


PARENT PARCEL: 04-00-026-109-012, -016, -017

CHILD PARCEL: 04-00-026-109-301 THRU -303


13-03168

STARTING POINT: AT A MON BOX AT THE INTERSECTION OF C/L OF POTTERSTONE WAY AND C/L OF SCHWARTZ RD.

POTTERSTONE WAY

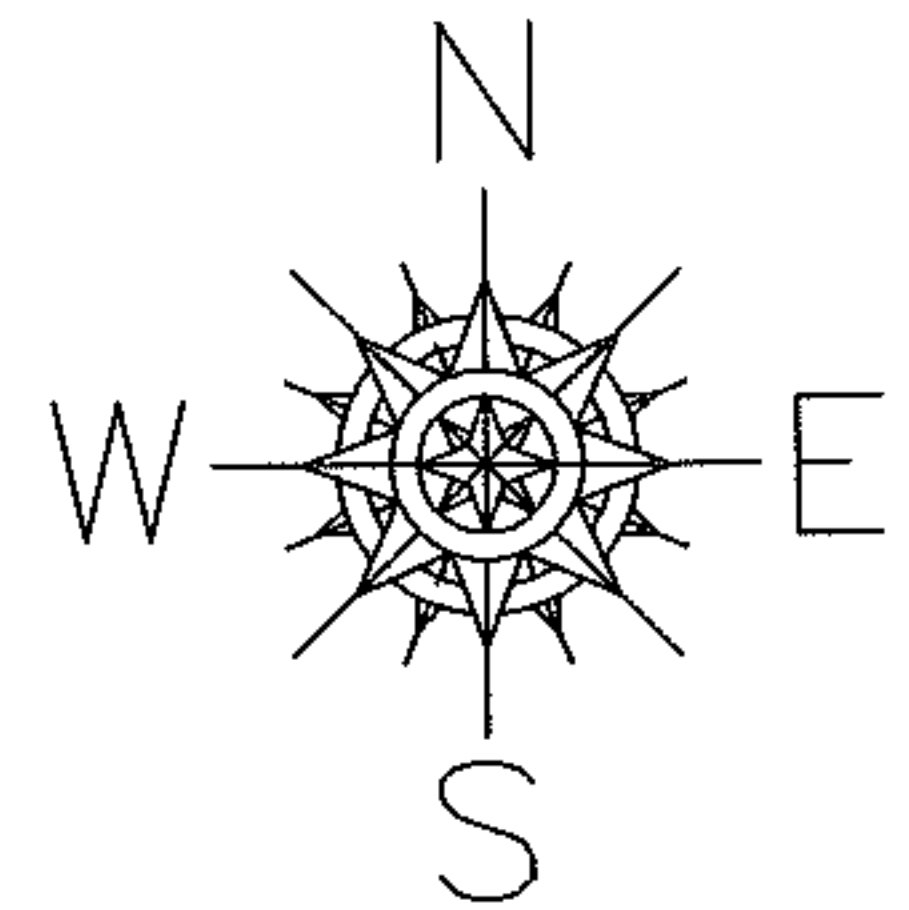

SCHWARTZ RD.

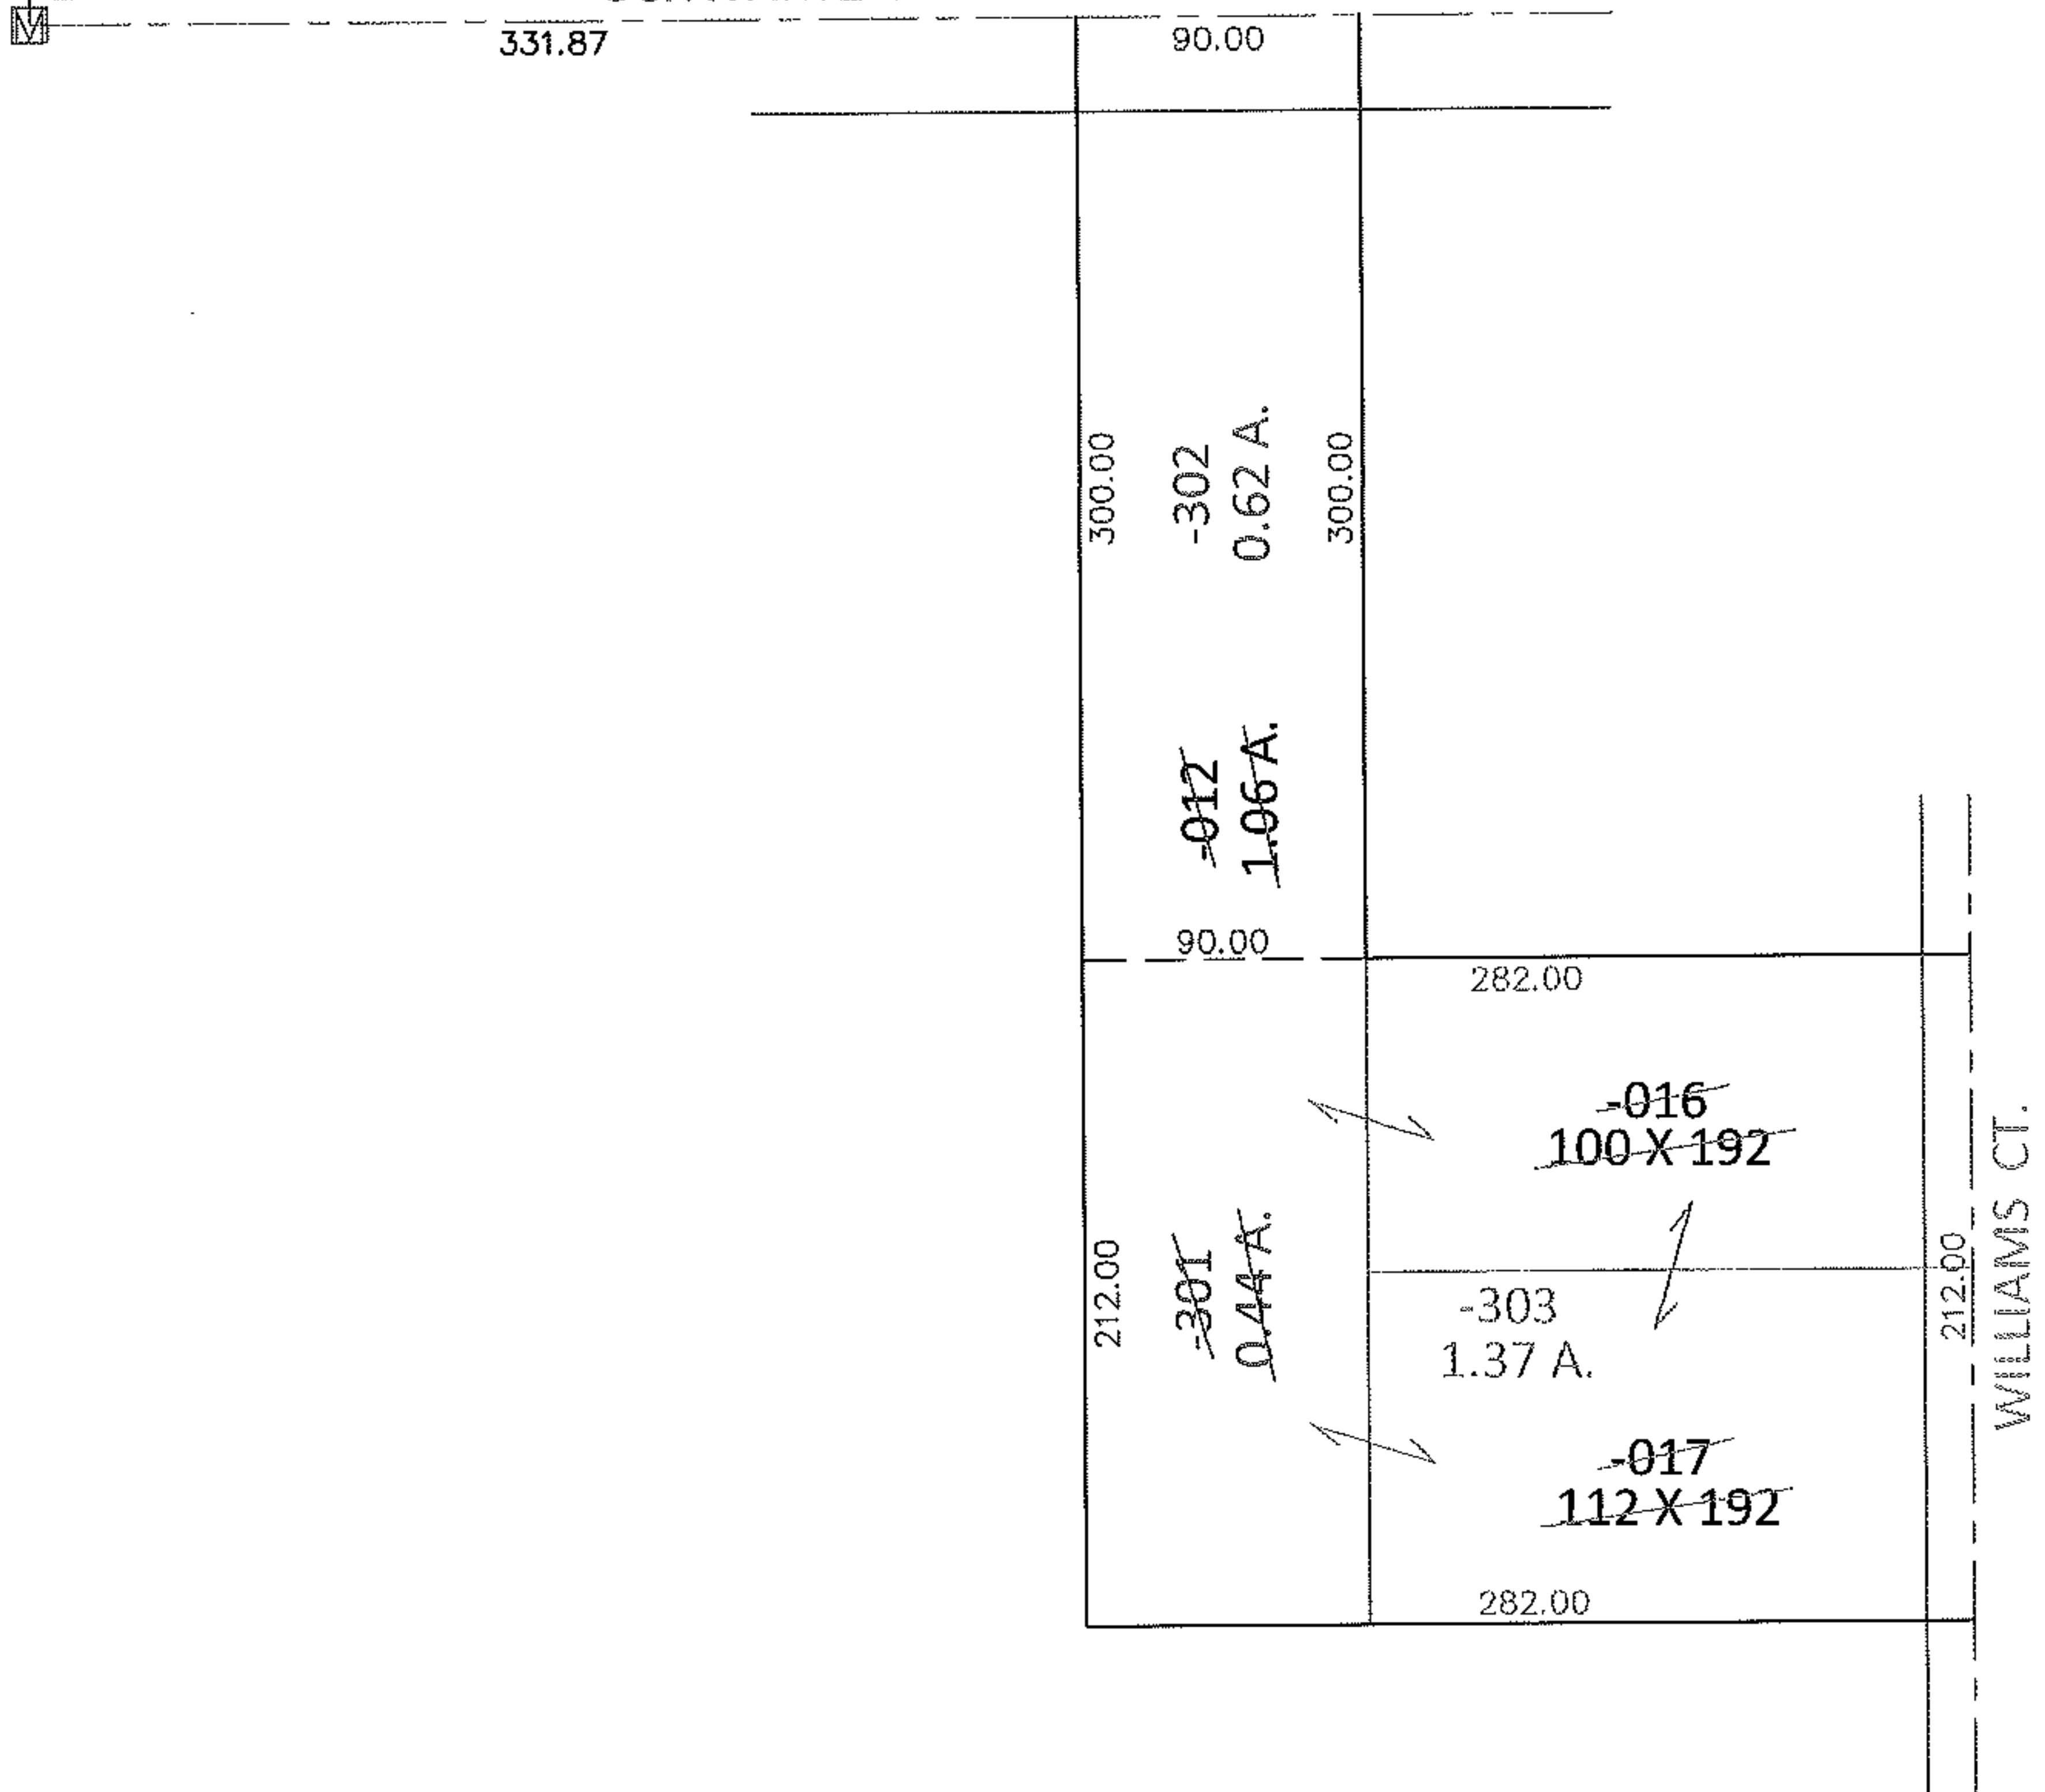

SPLITS/DEEDS PROCESSED

LORAIN COUNTY TAX MAP DEPARTMENT
226 MIDDLE AVE. ELYRIA, OHIO

SURVEYED BY: ERIC W. SHORT

CLOSURE: .01:10,000

MAP PAGE(S): 4-00-026-F

APPROVED BY: RRM DATE: 7-31-13

SCALE: 1"= 100 PRIOR INST.: OR 1283/610