
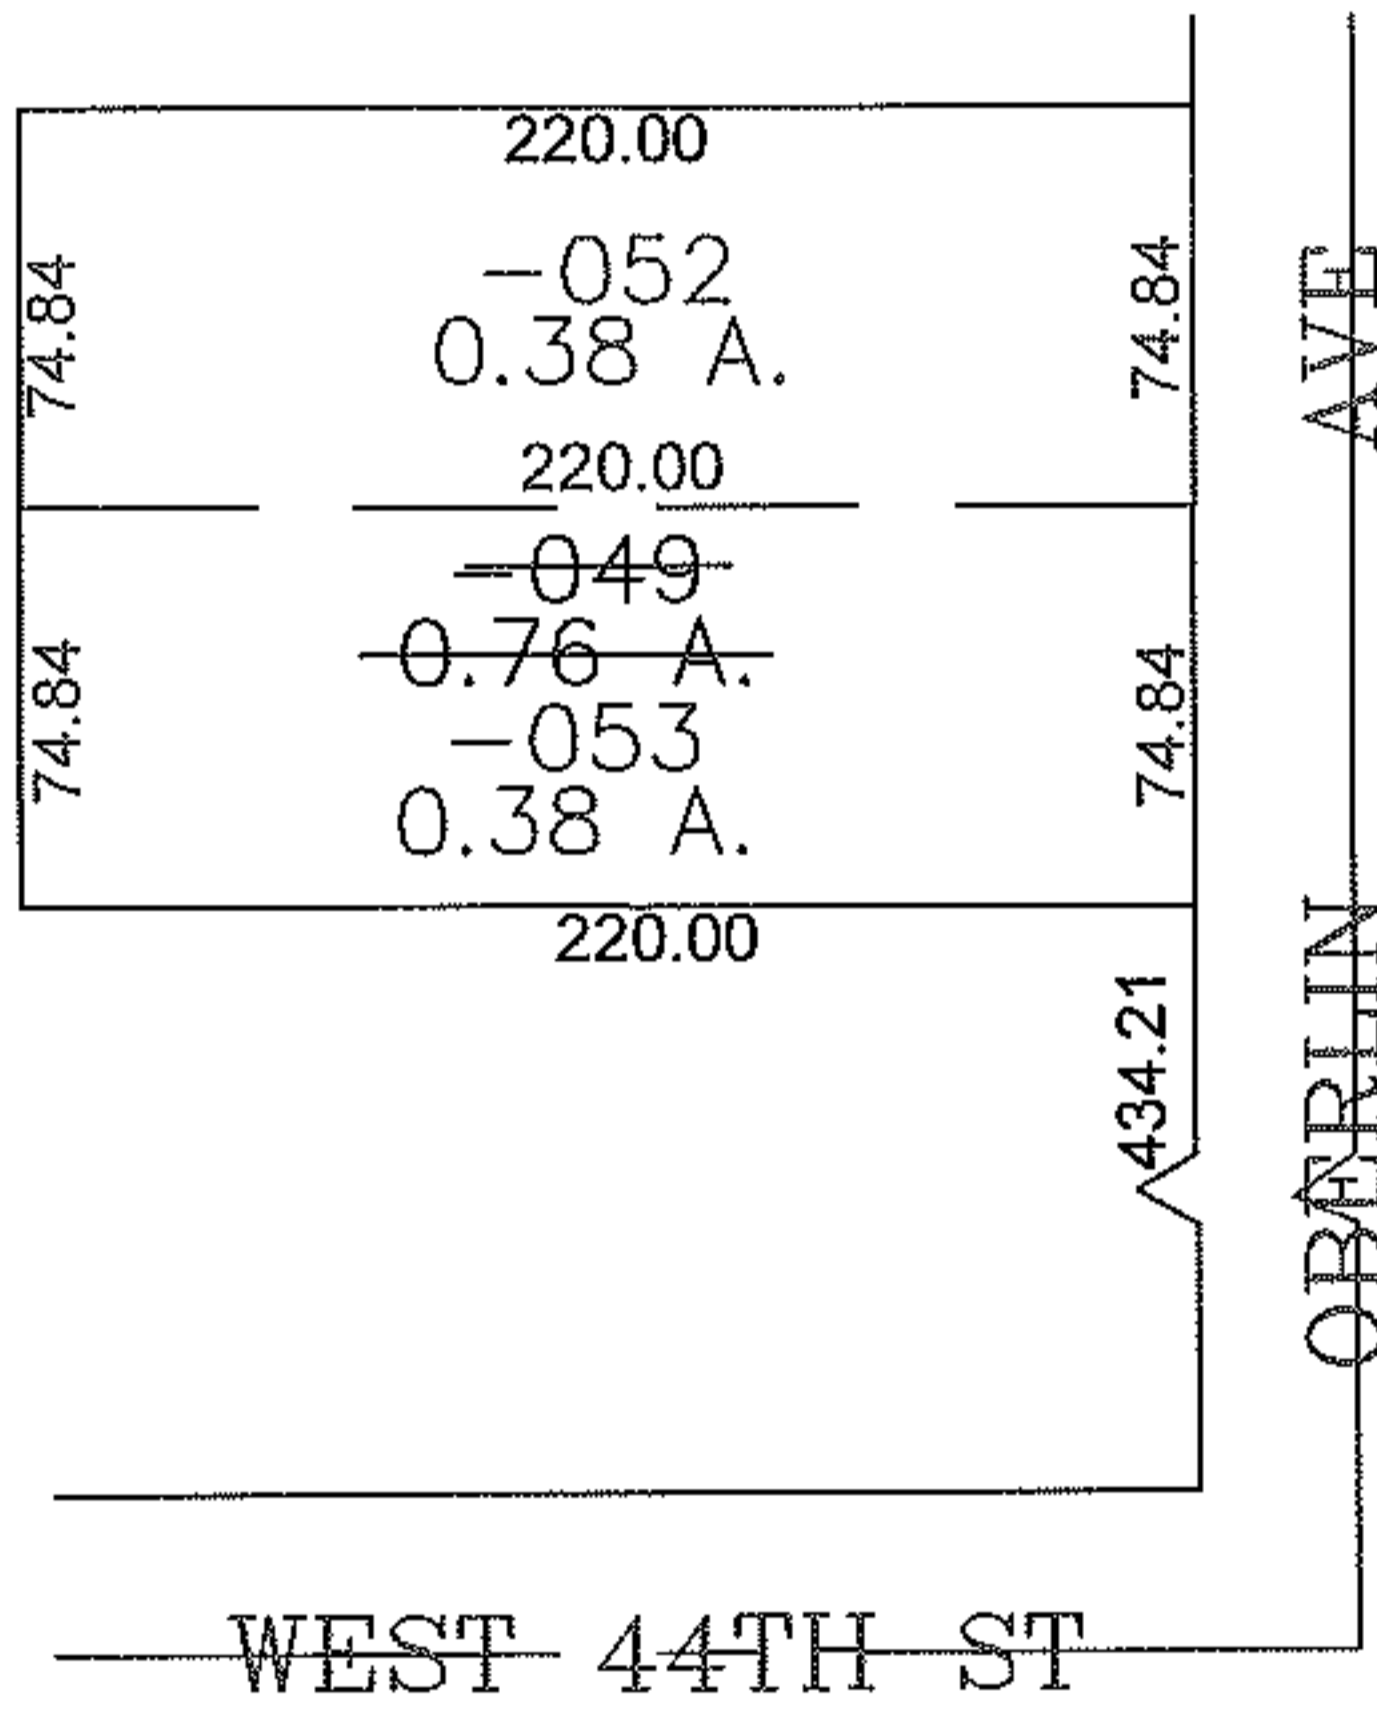


PARENT PARCEL: 02-02-006-108-049

CHILD PARCEL: 02-02-006-108-052, -053

STARTING POINT: INTERSECTION OF NORTH LINE OF W 44TH ST & WEST LINE OF OBERLIN AVE

13-03169

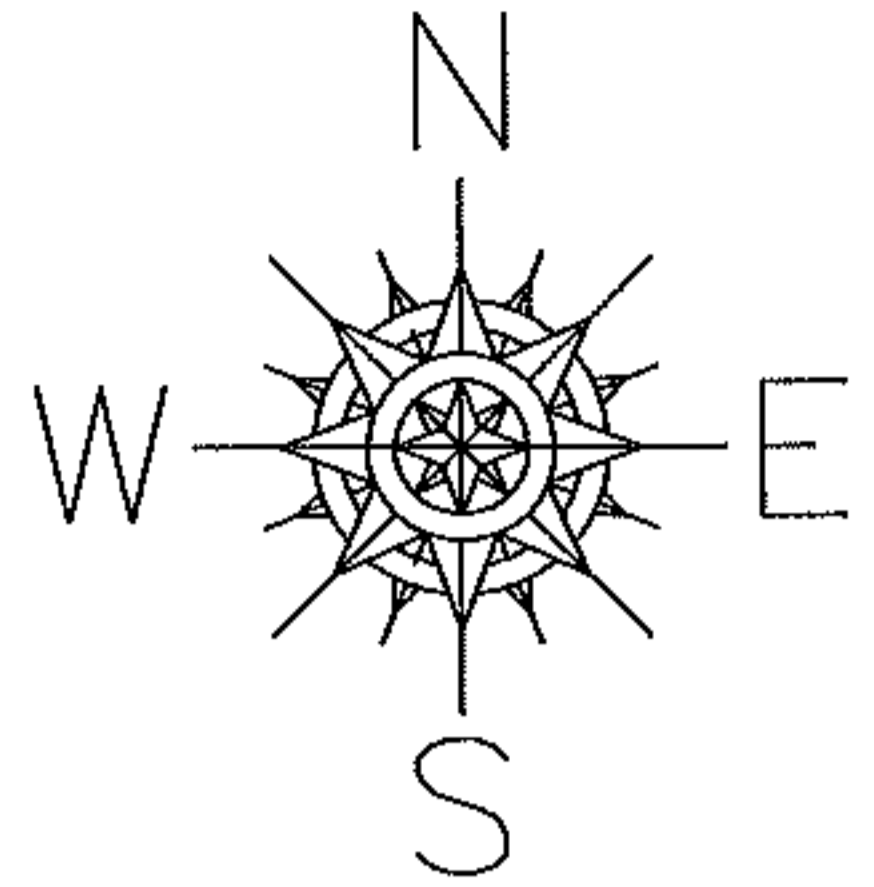

SPLITS/DEEDS PROCESSED

LORAIN COUNTY TAX MAP DEPARTMENT
226 MIDDLE AVE. ELYRIA, OHIO

SURVEYED BY: PATRICK MCGANNON

CLOSURE: 0.00 : 10,000

MAP PAGE(S): 02-02-006-B

APPROVED BY: JAH DATE: 7/29/2013

SCALE: 1" = 100 PRIOR INSTRUMENT: DV XXXX/XXX