


PARENT PARCEL: 16-00-054-000-004

CHILD PARCEL: 16-00-054-630-001

15-03174-A

STARTING POINT:

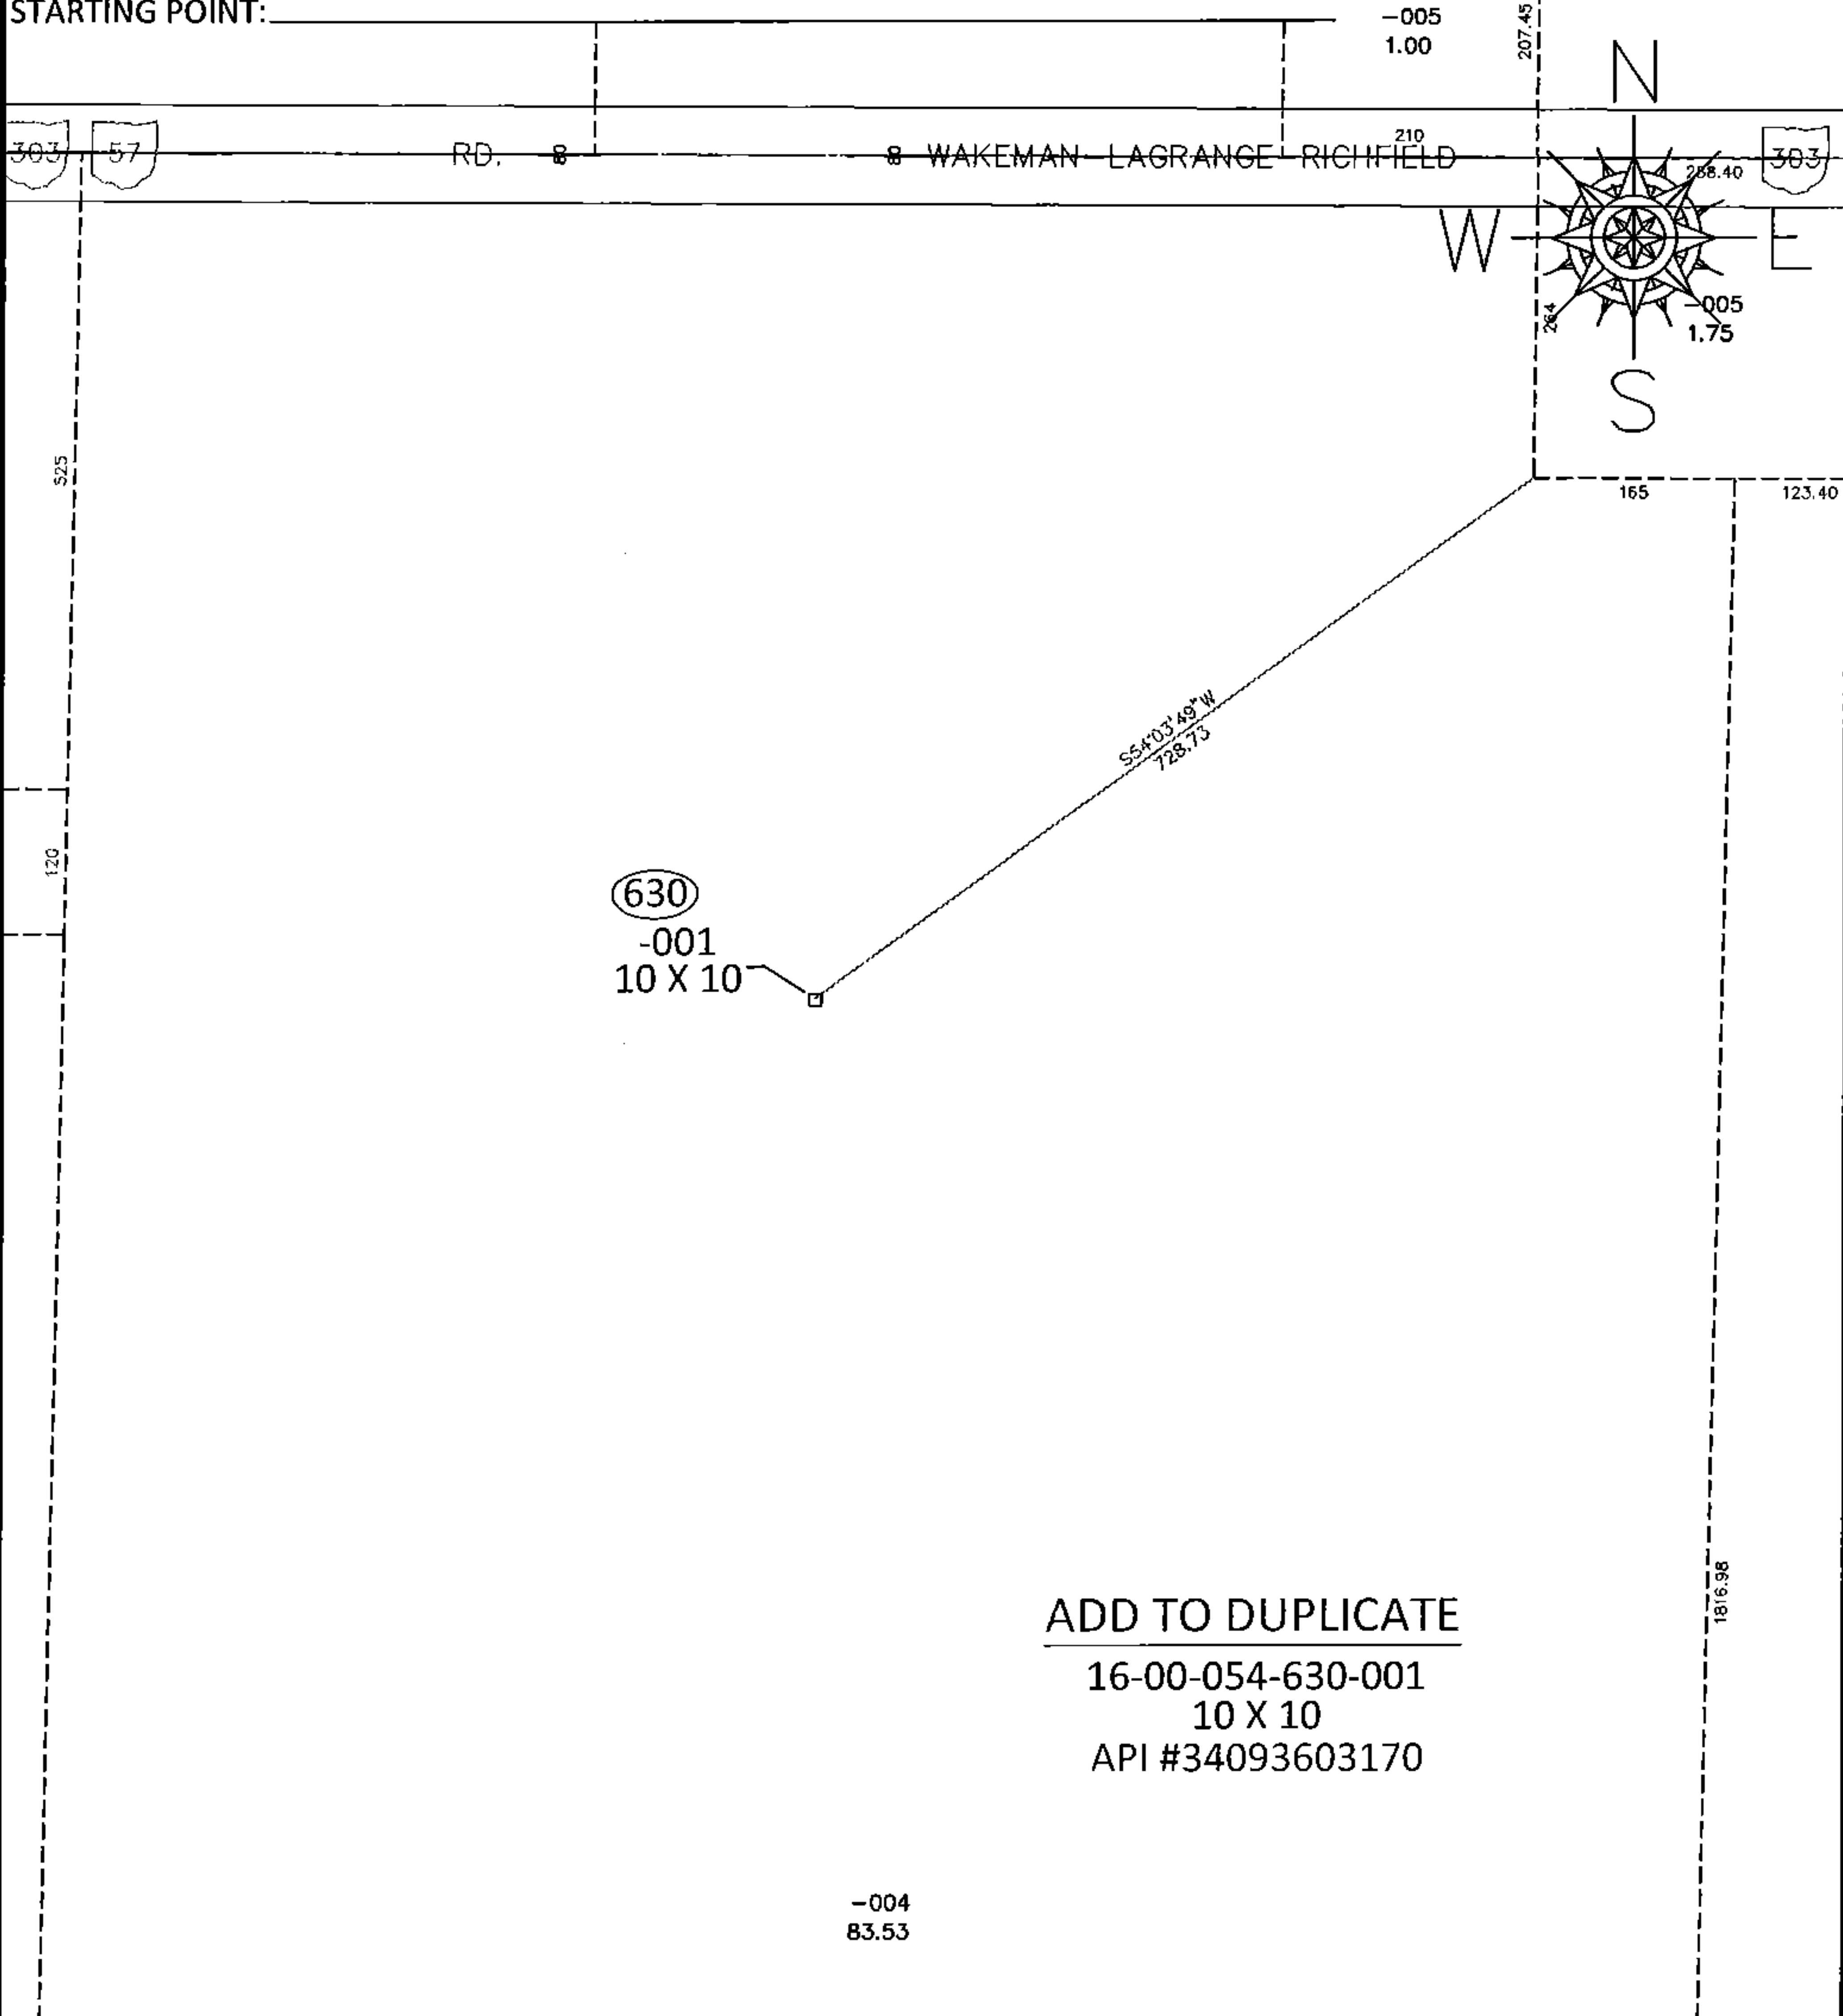


ADD TO DUPLICATE

16-00-054-630-001

10 X 10

API #34093603170

-004  
83.53

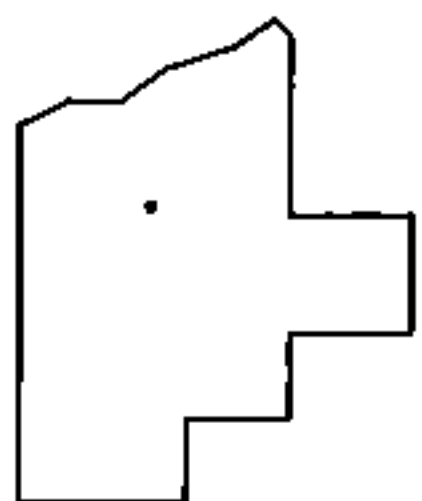

SPLITS/DEEDS PROCESSED

LORAIN COUNTY TAX MAP DEPARTMENT  
226 MIDDLE AVE. ELYRIA, OHIO

SURVEYED BY: N/A

CLOSURE: N/A

MAP PAGE(S): 16-G

APPROVED BY: RRM DATE: 5-6-15

SCALE: 1" = 200

PRIOR INST.: \_\_\_\_\_