
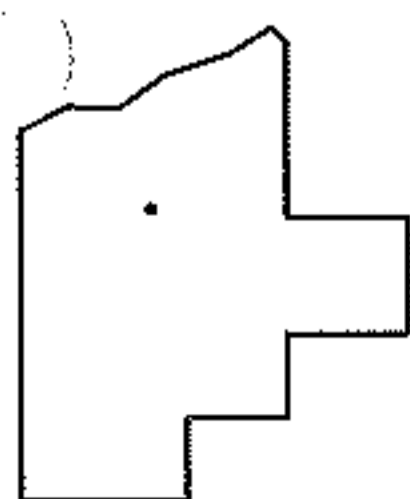
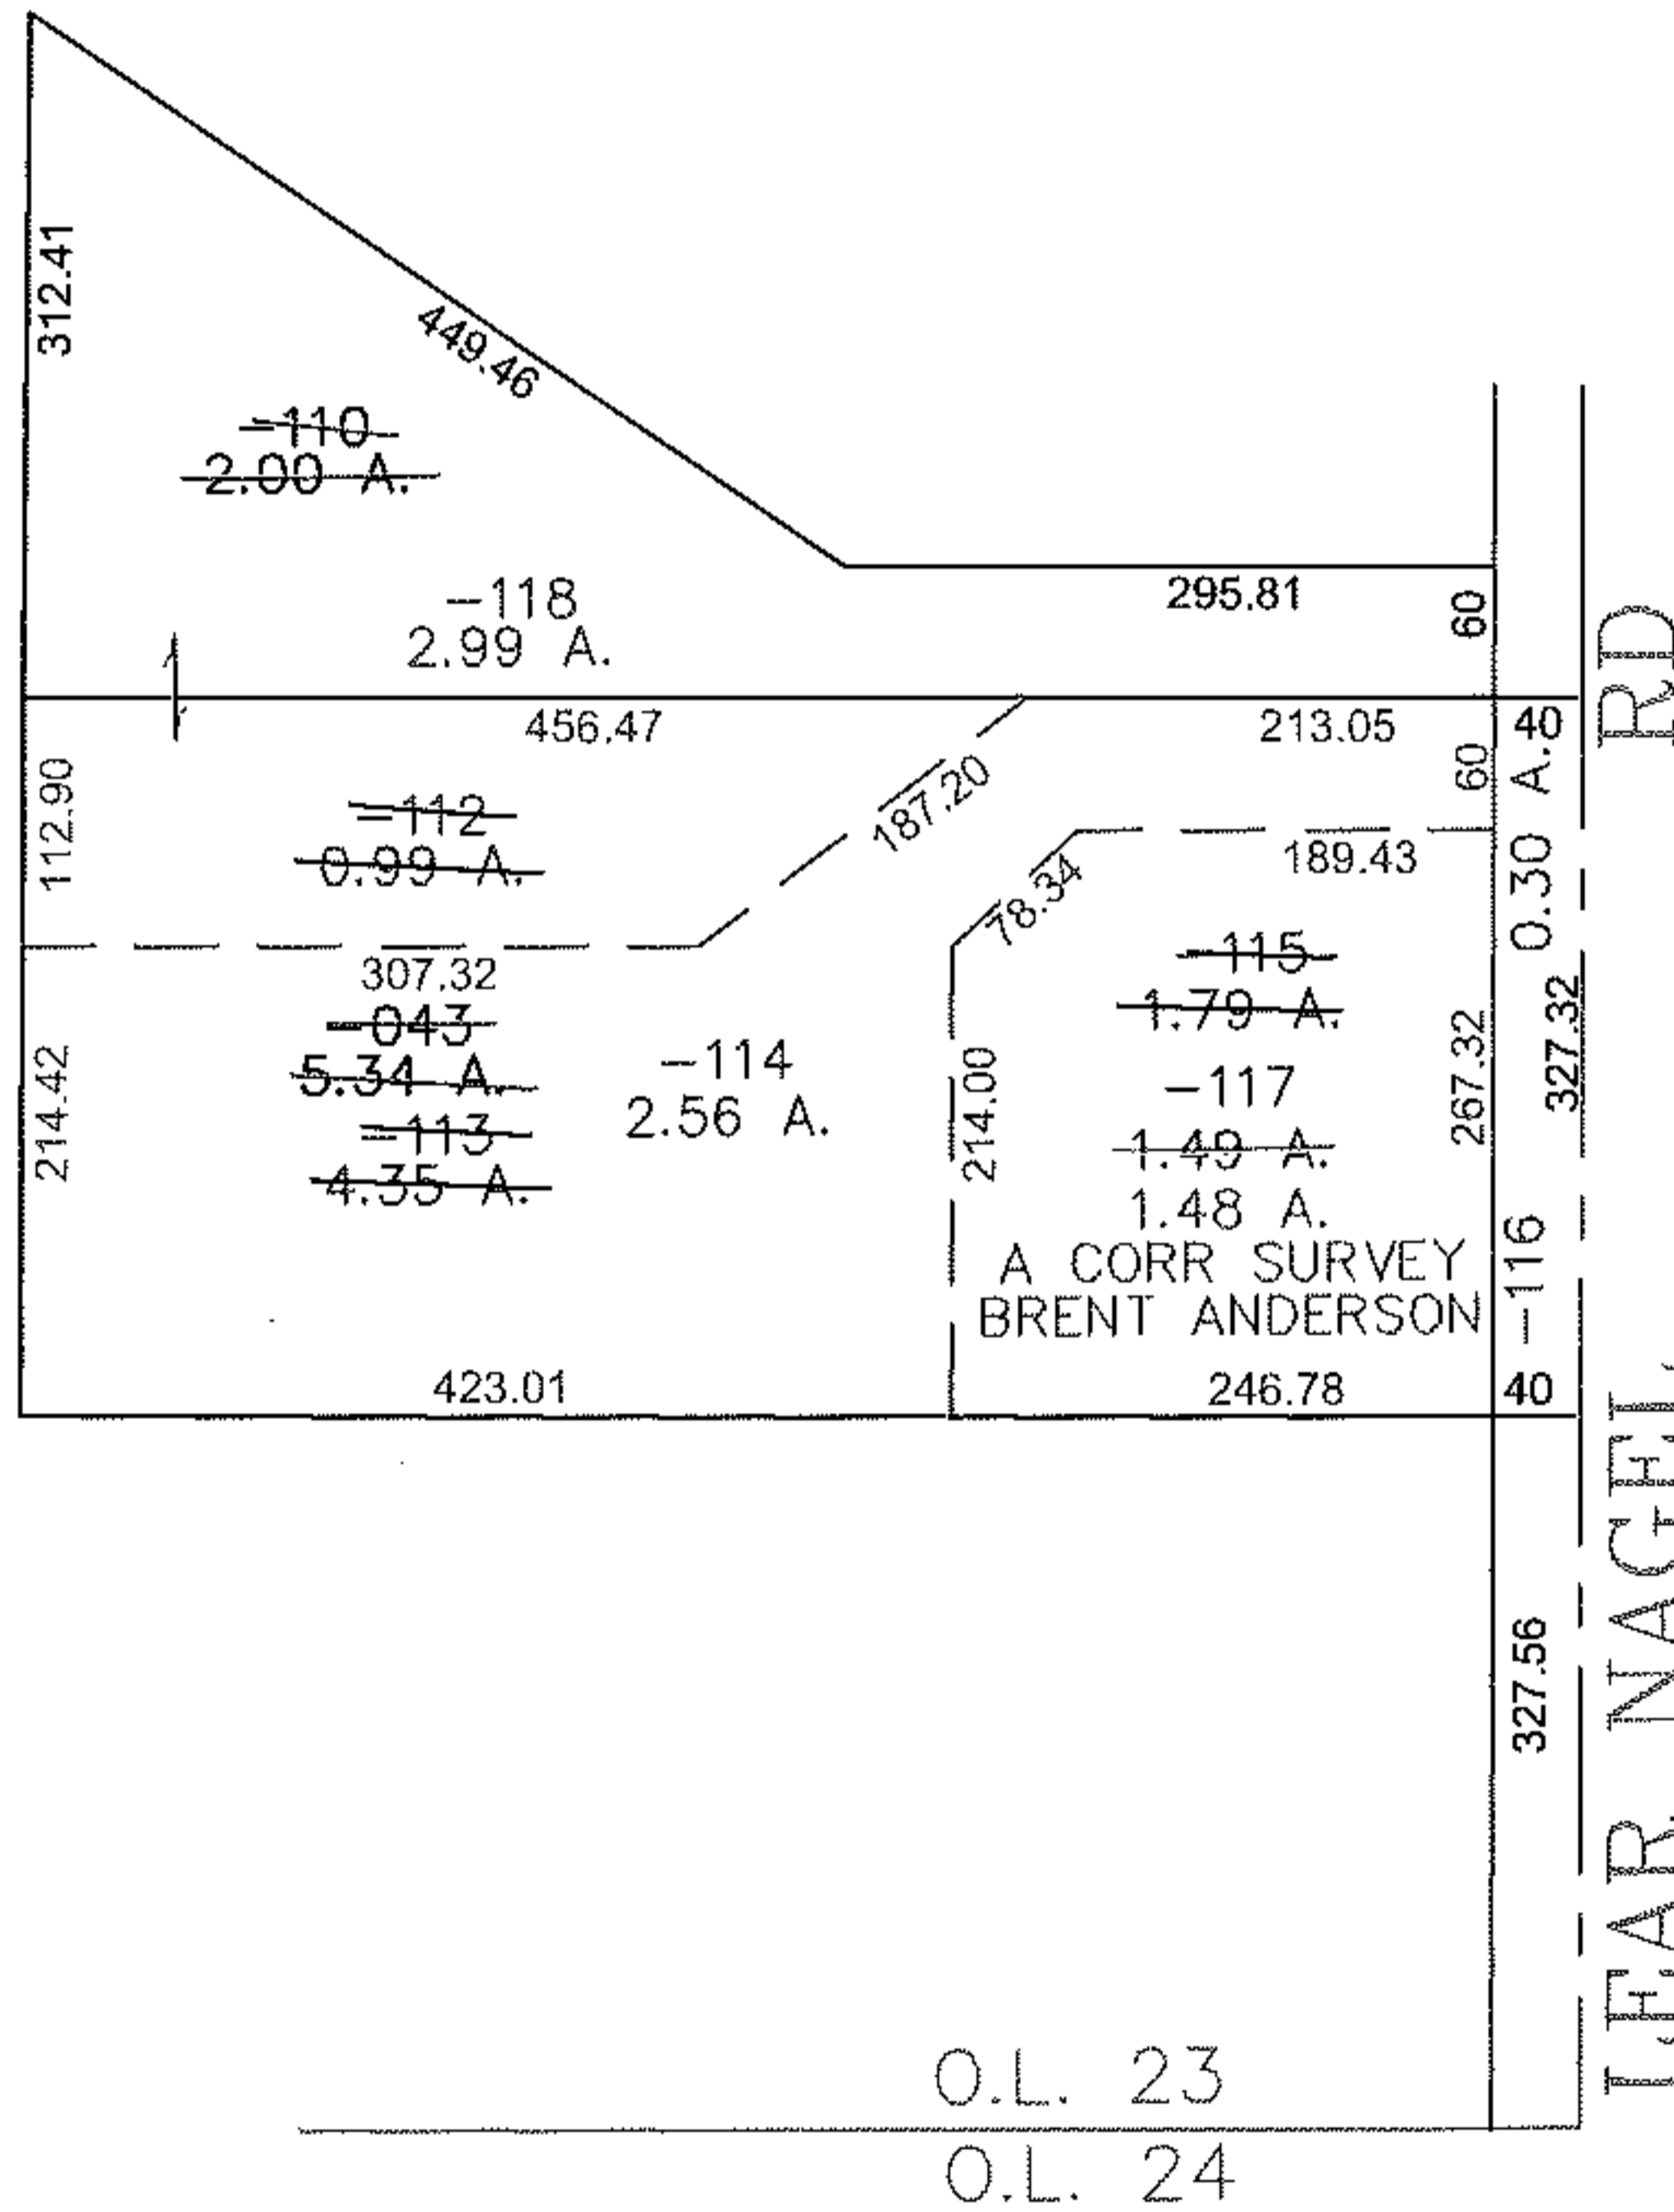


PARENT PARCEL: 04-00-023-110-043, -110

CHILD PARCEL: 04-00-023-110-112 THRU -118

STARTING POINT: CERENTERLINE OF LEAR NAGEL RD & O.L. 23

13-03175

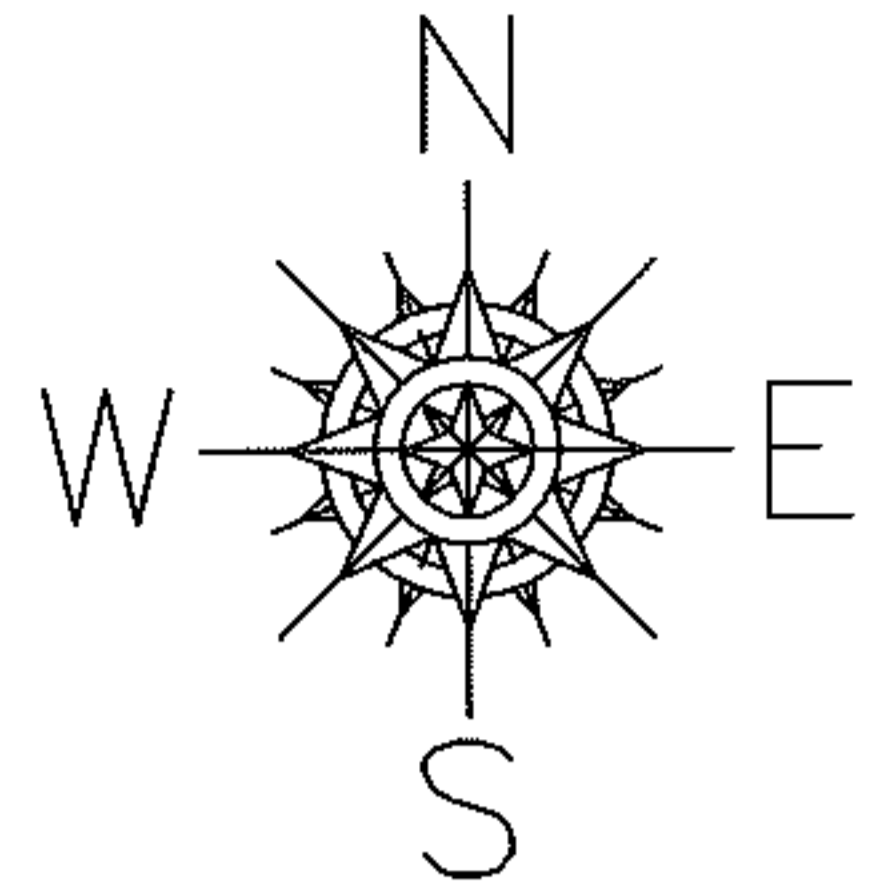

**SPLITS/DEEDS PROCESSED**  
LORAIN COUNTY TAX MAP DEPARTMENT  
226 MIDDLE AVE. ELYRIA, OHIO

SURVEYED BY: BRENT ANDERSON  
CLOSURE: 0.00 : 10,000  
MAP PAGE(S): 04-00-023-H  
APPROVED BY: JAH DATE: 8-12-2013  
SCALE: 1" = 200 PRIOR INSTRUMENT: 20130450851