



102

PARENT PARCEL: 12-00-063-~~000~~-007

CHILD PARCEL: 12-00-063-630-001

STARTING POINT:


15-03179-A

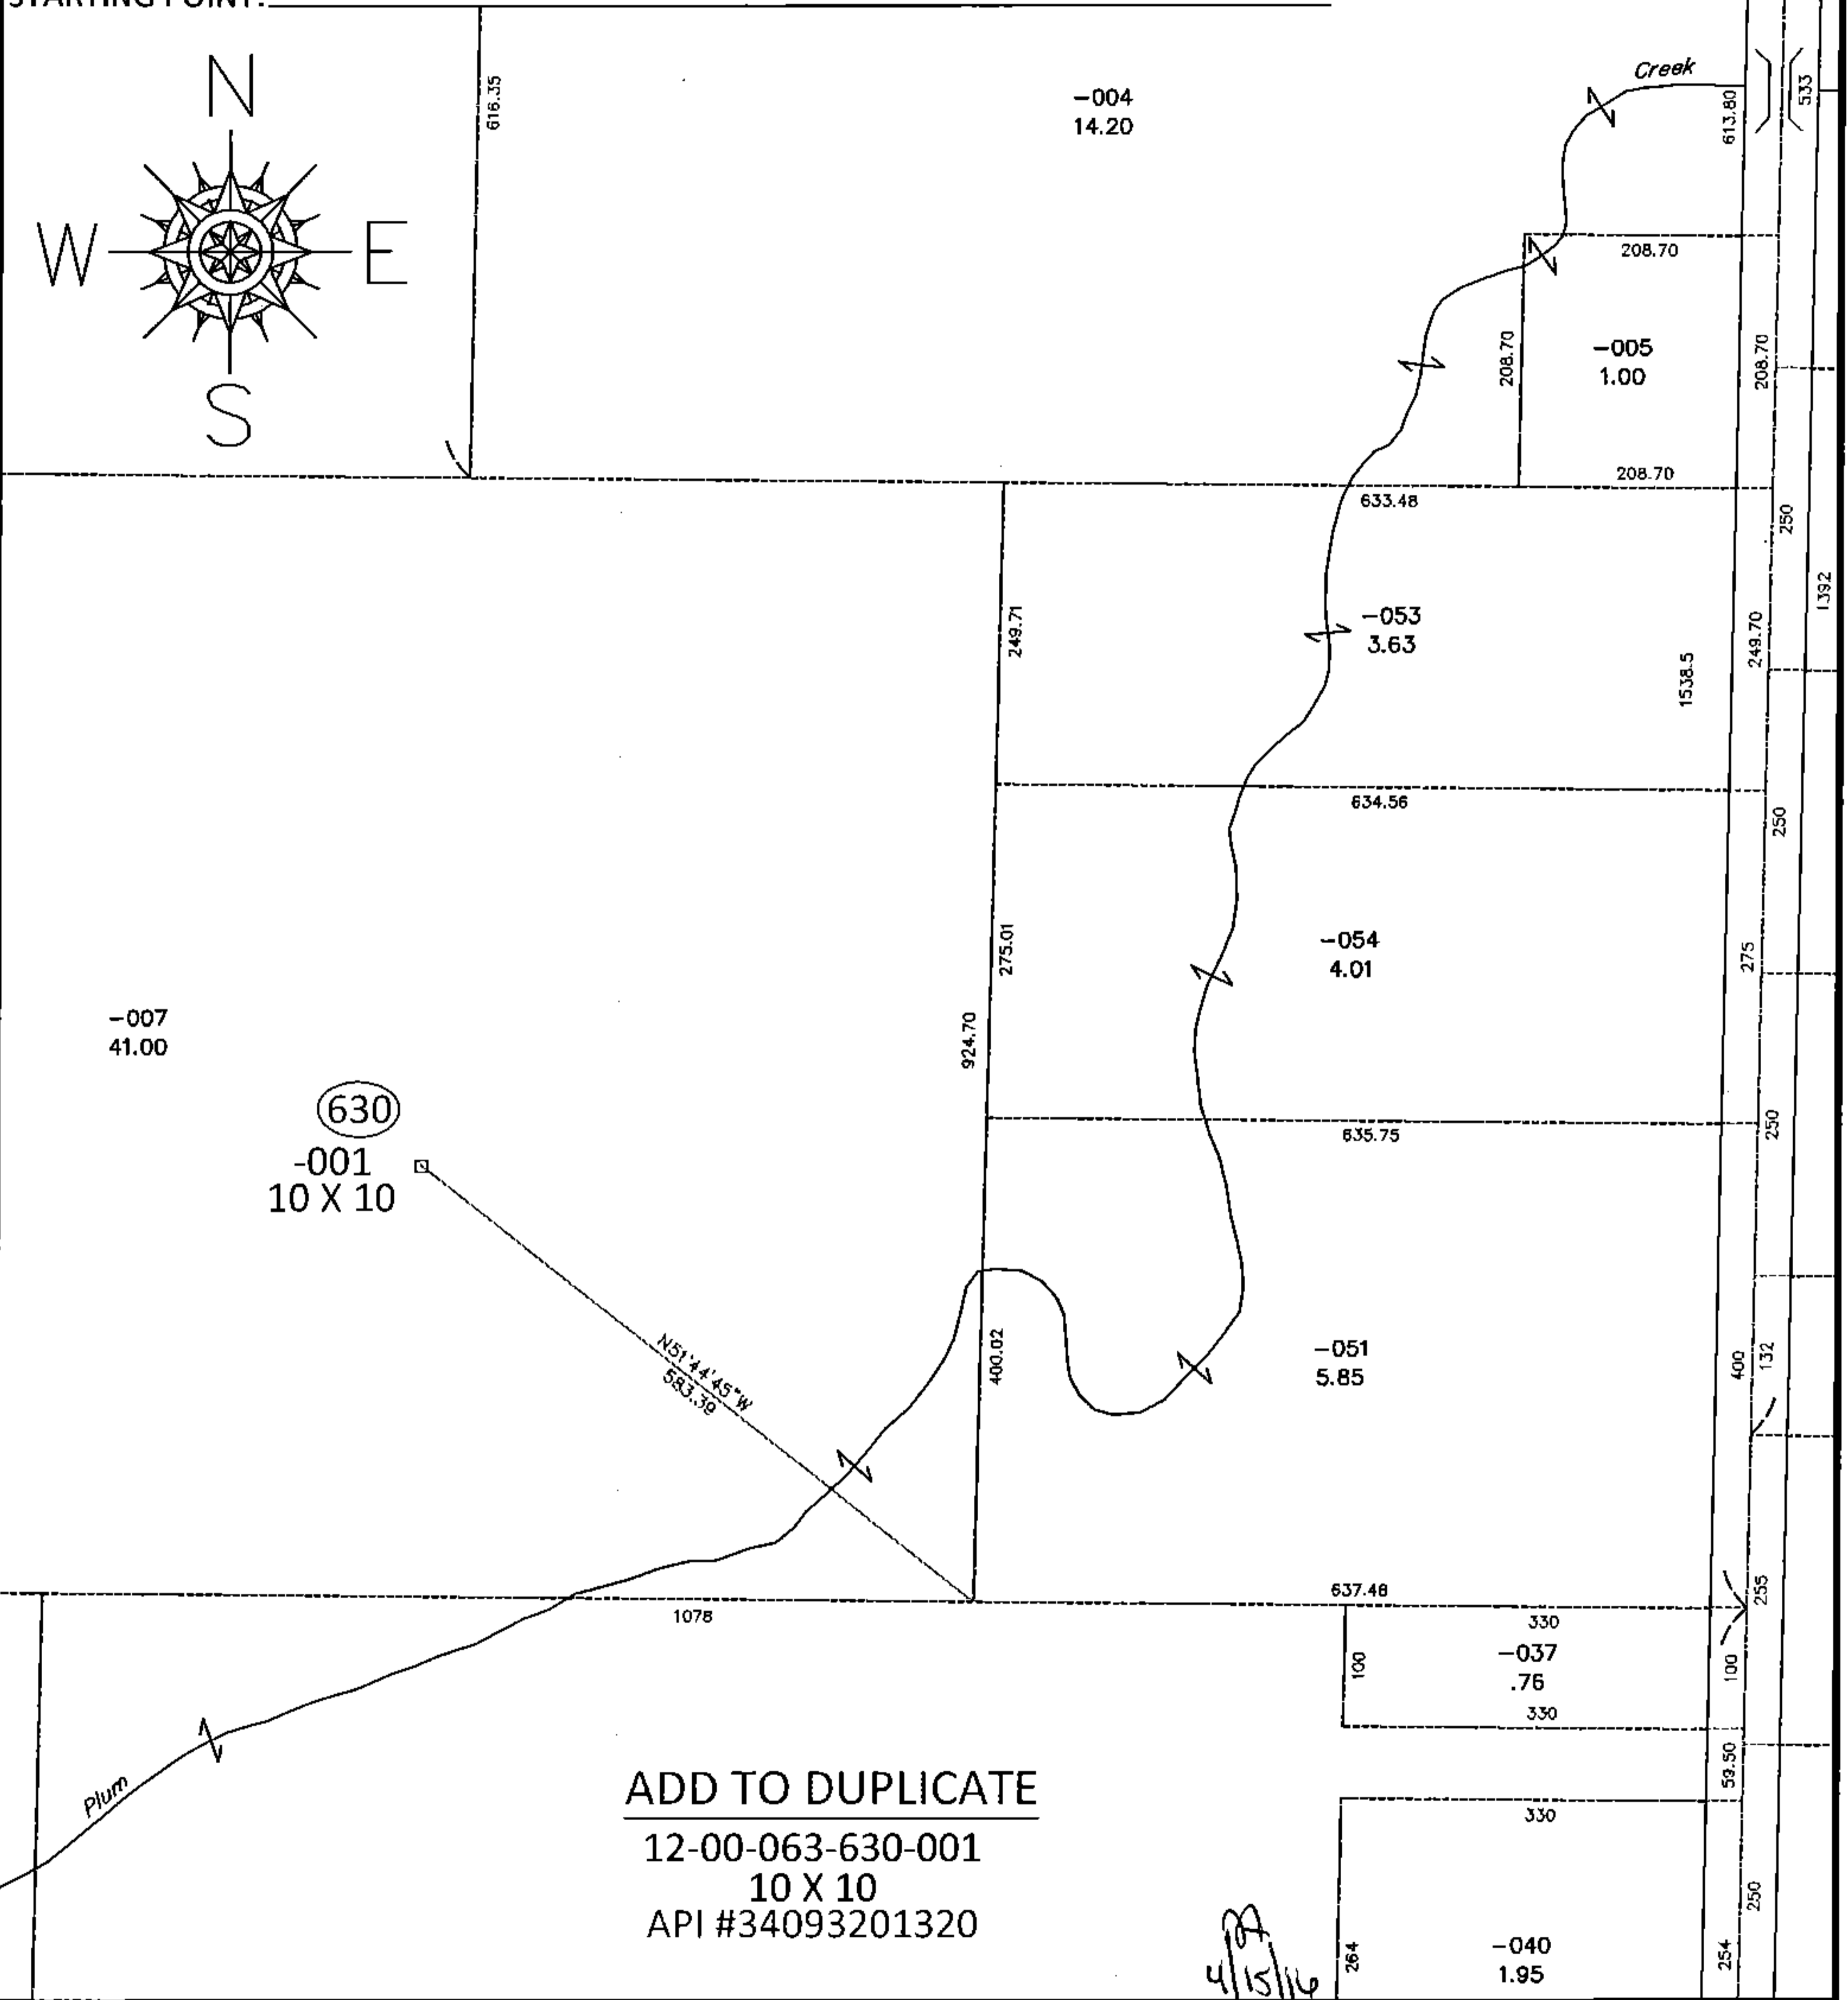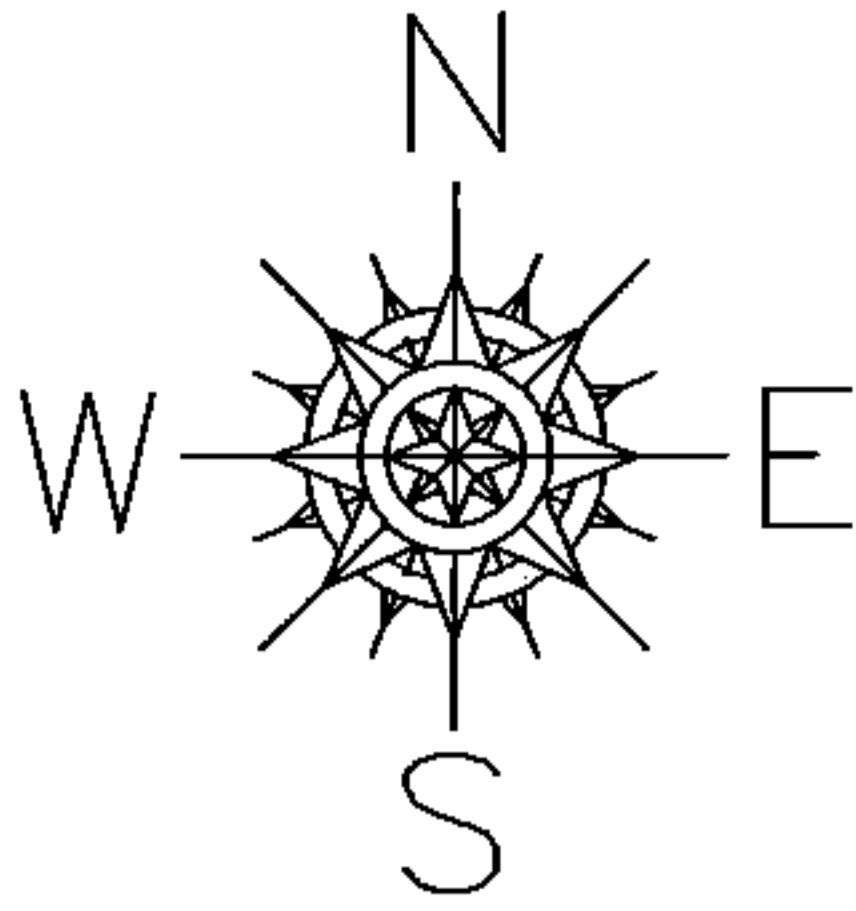

(630)  
-001  
10 X 10

ADD TO DUPLICATE  
12-00-063-630-001  
10 X 10  
API #34093201320

4/15/16

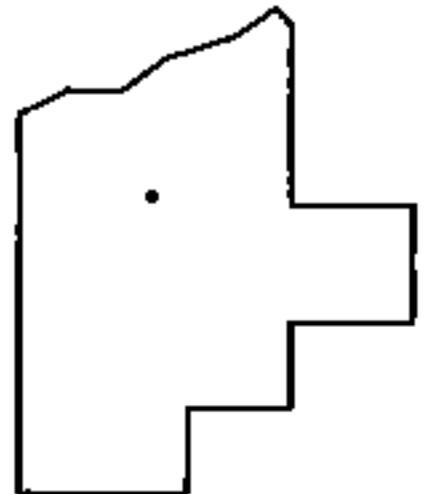

**SPLITS/DEEDS PROCESSED**  
LORAIN COUNTY TAX MAP DEPARTMENT  
226 MIDDLE AVE. ELYRIA, OHIO

SURVEYED BY: N/A  
CLOSURE: N/A  
MAP PAGE(S): 12-00-063-B  
APPROVED BY: RRM DATE: 5-6-15  
SCALE: 1" = 200 PRIOR INST.: