
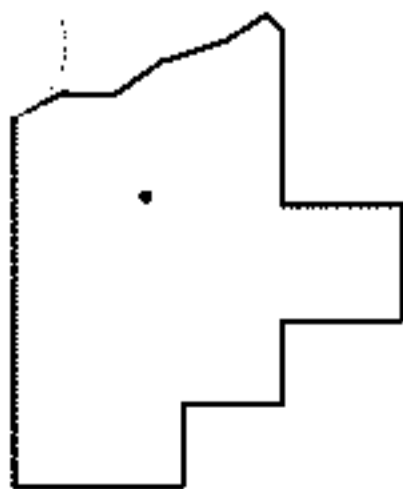
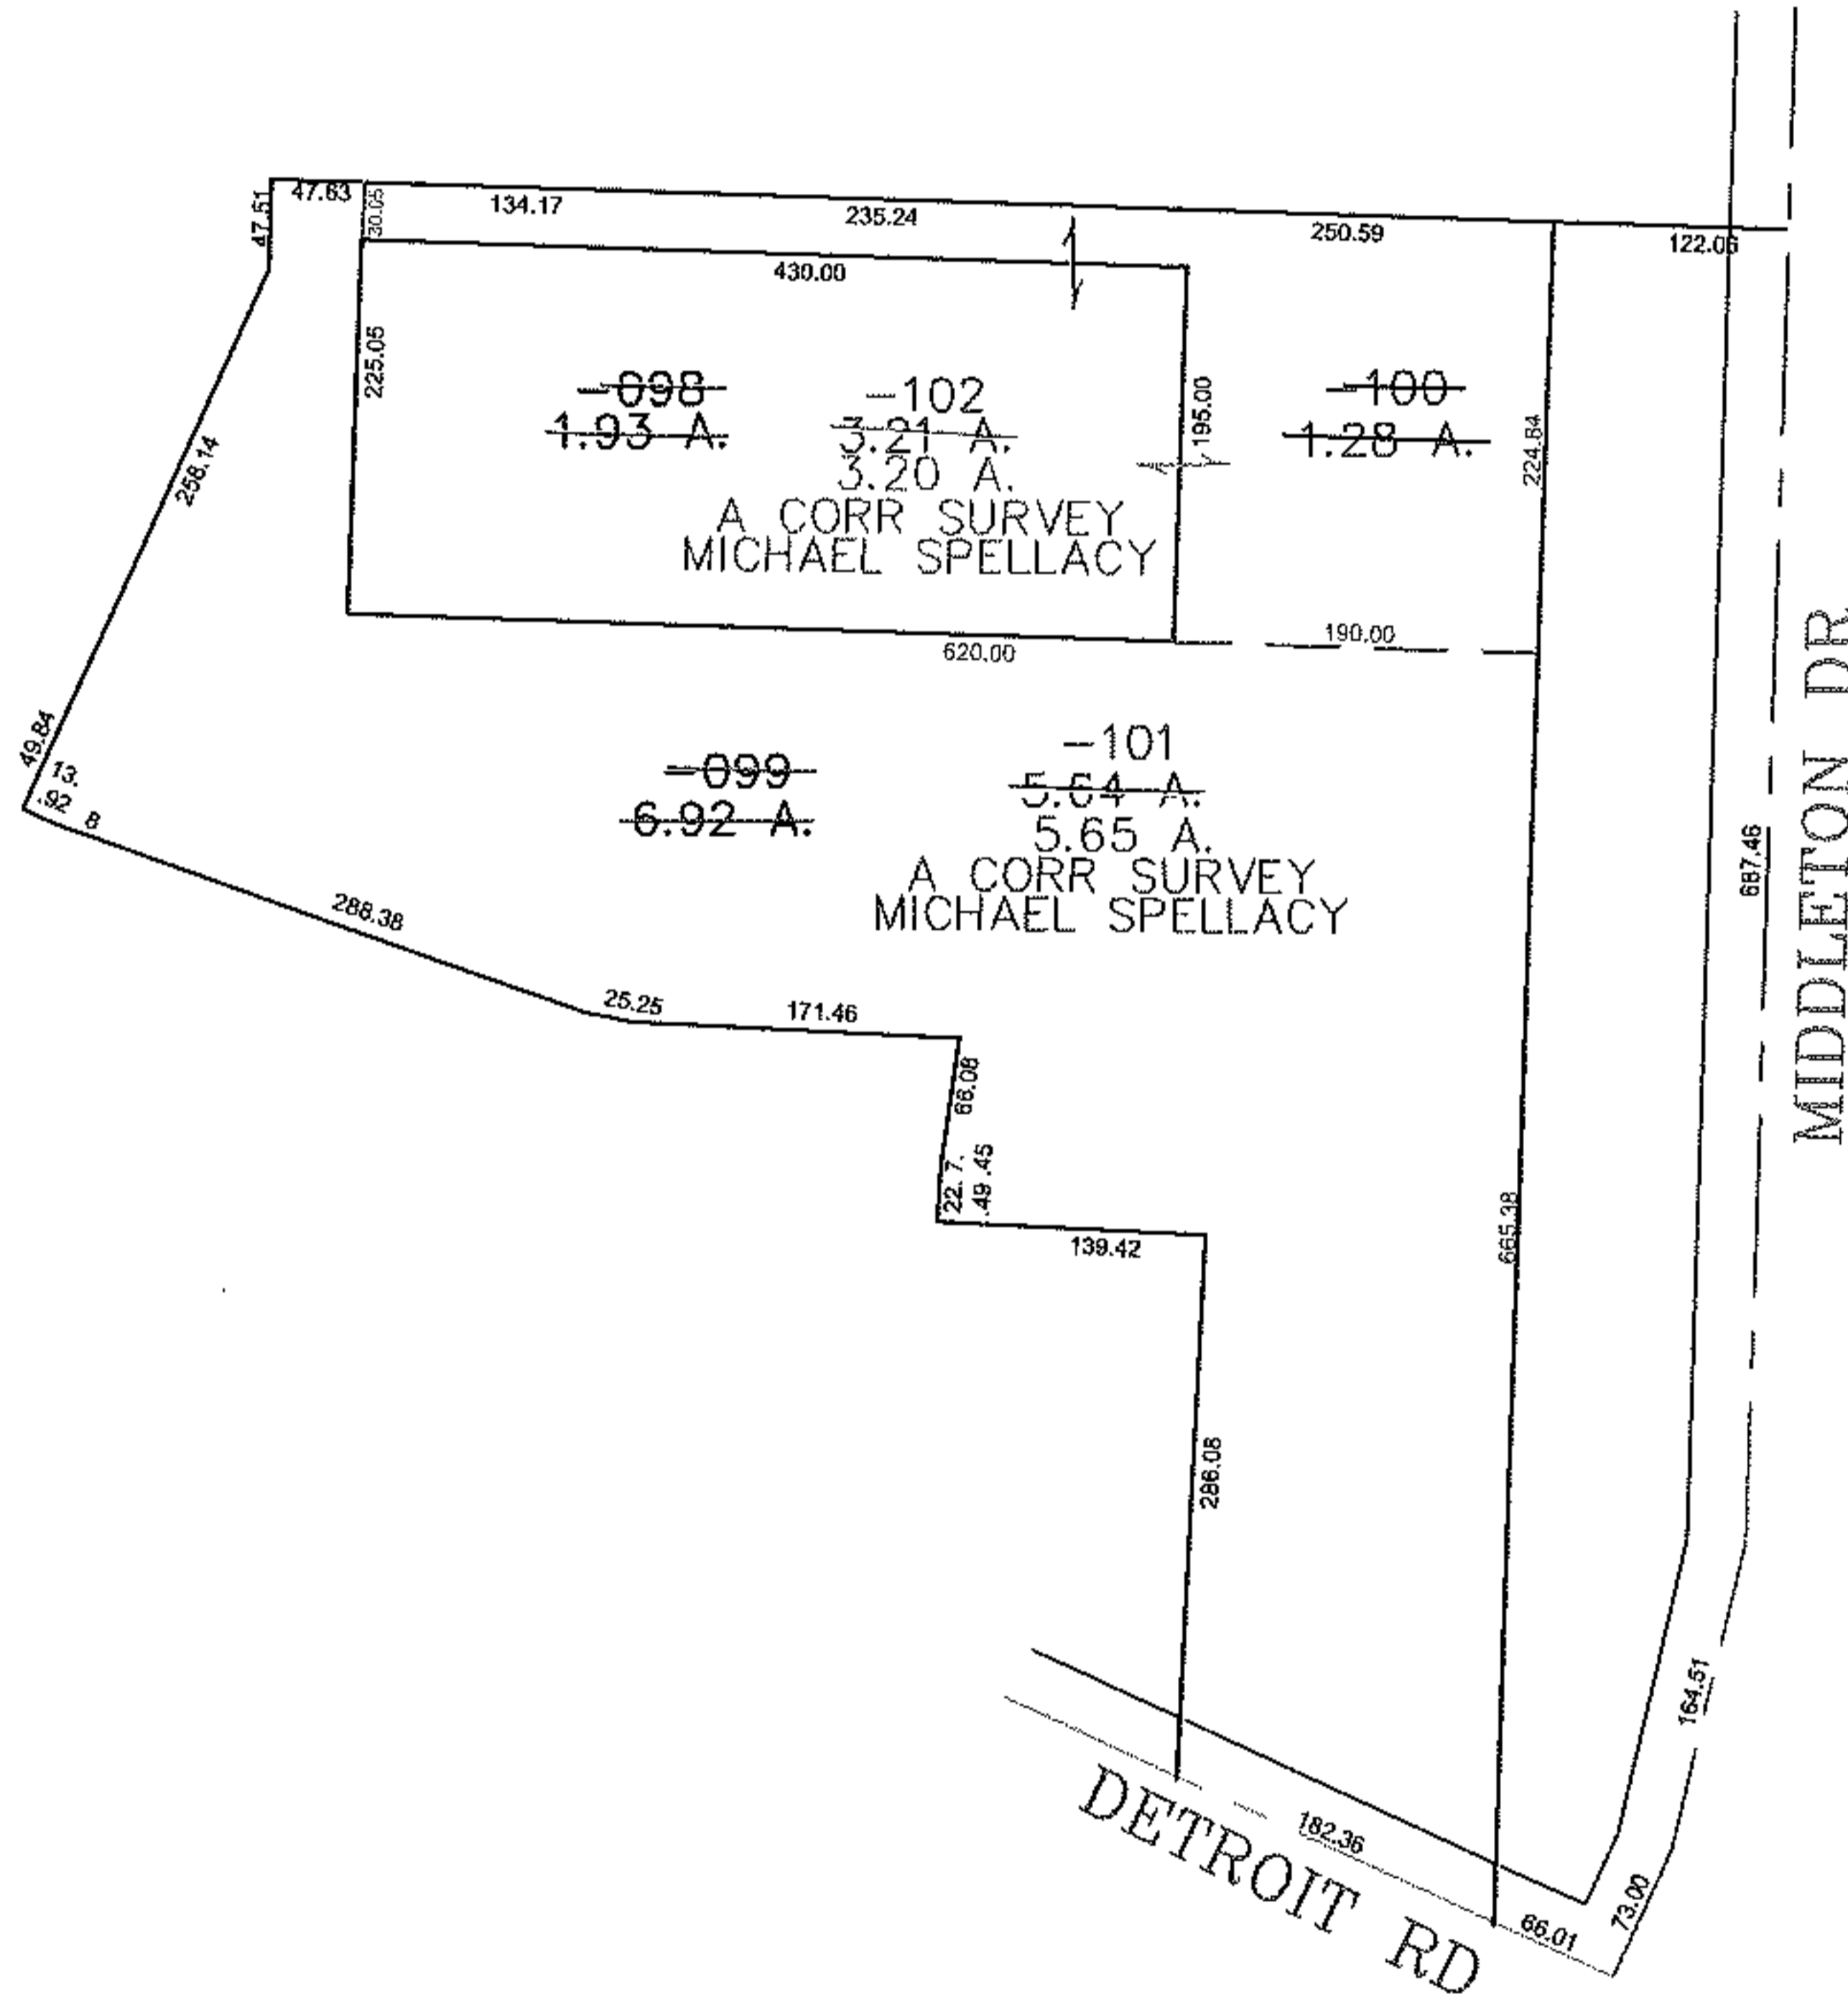


PARENT PARCEL: 04-00-015-103-099, -098

CHILD PARCEL: 04-00-015-103-100, -101, -102

STARTING POINT: CENTERLINE OF DETROIT RD & MIDDLETON DR.

13-03179

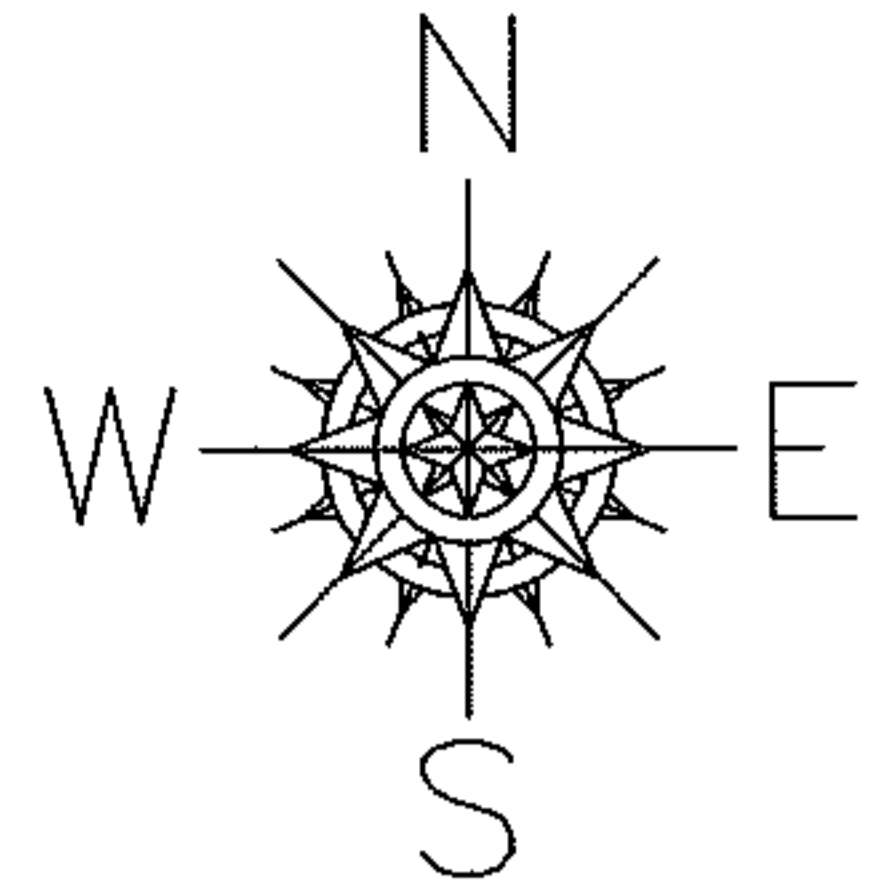

**SPLITS/DEEDS PROCESSED**  
 LORAIN COUNTY TAX MAP DEPARTMENT  
 226 MIDDLE AVE. ELYRIA, OHIO

SURVEYED BY: MICHAEL SPELLACY  
 CLOSURE: 0.00 : 10.000  
 MAP PAGE(S): 04-00-015-D  
 APPROVED BY: JAH DATE: 8/20/2013  
 SCALE: 1" = 200 PRIOR INSTRUMENT: 20130460085