
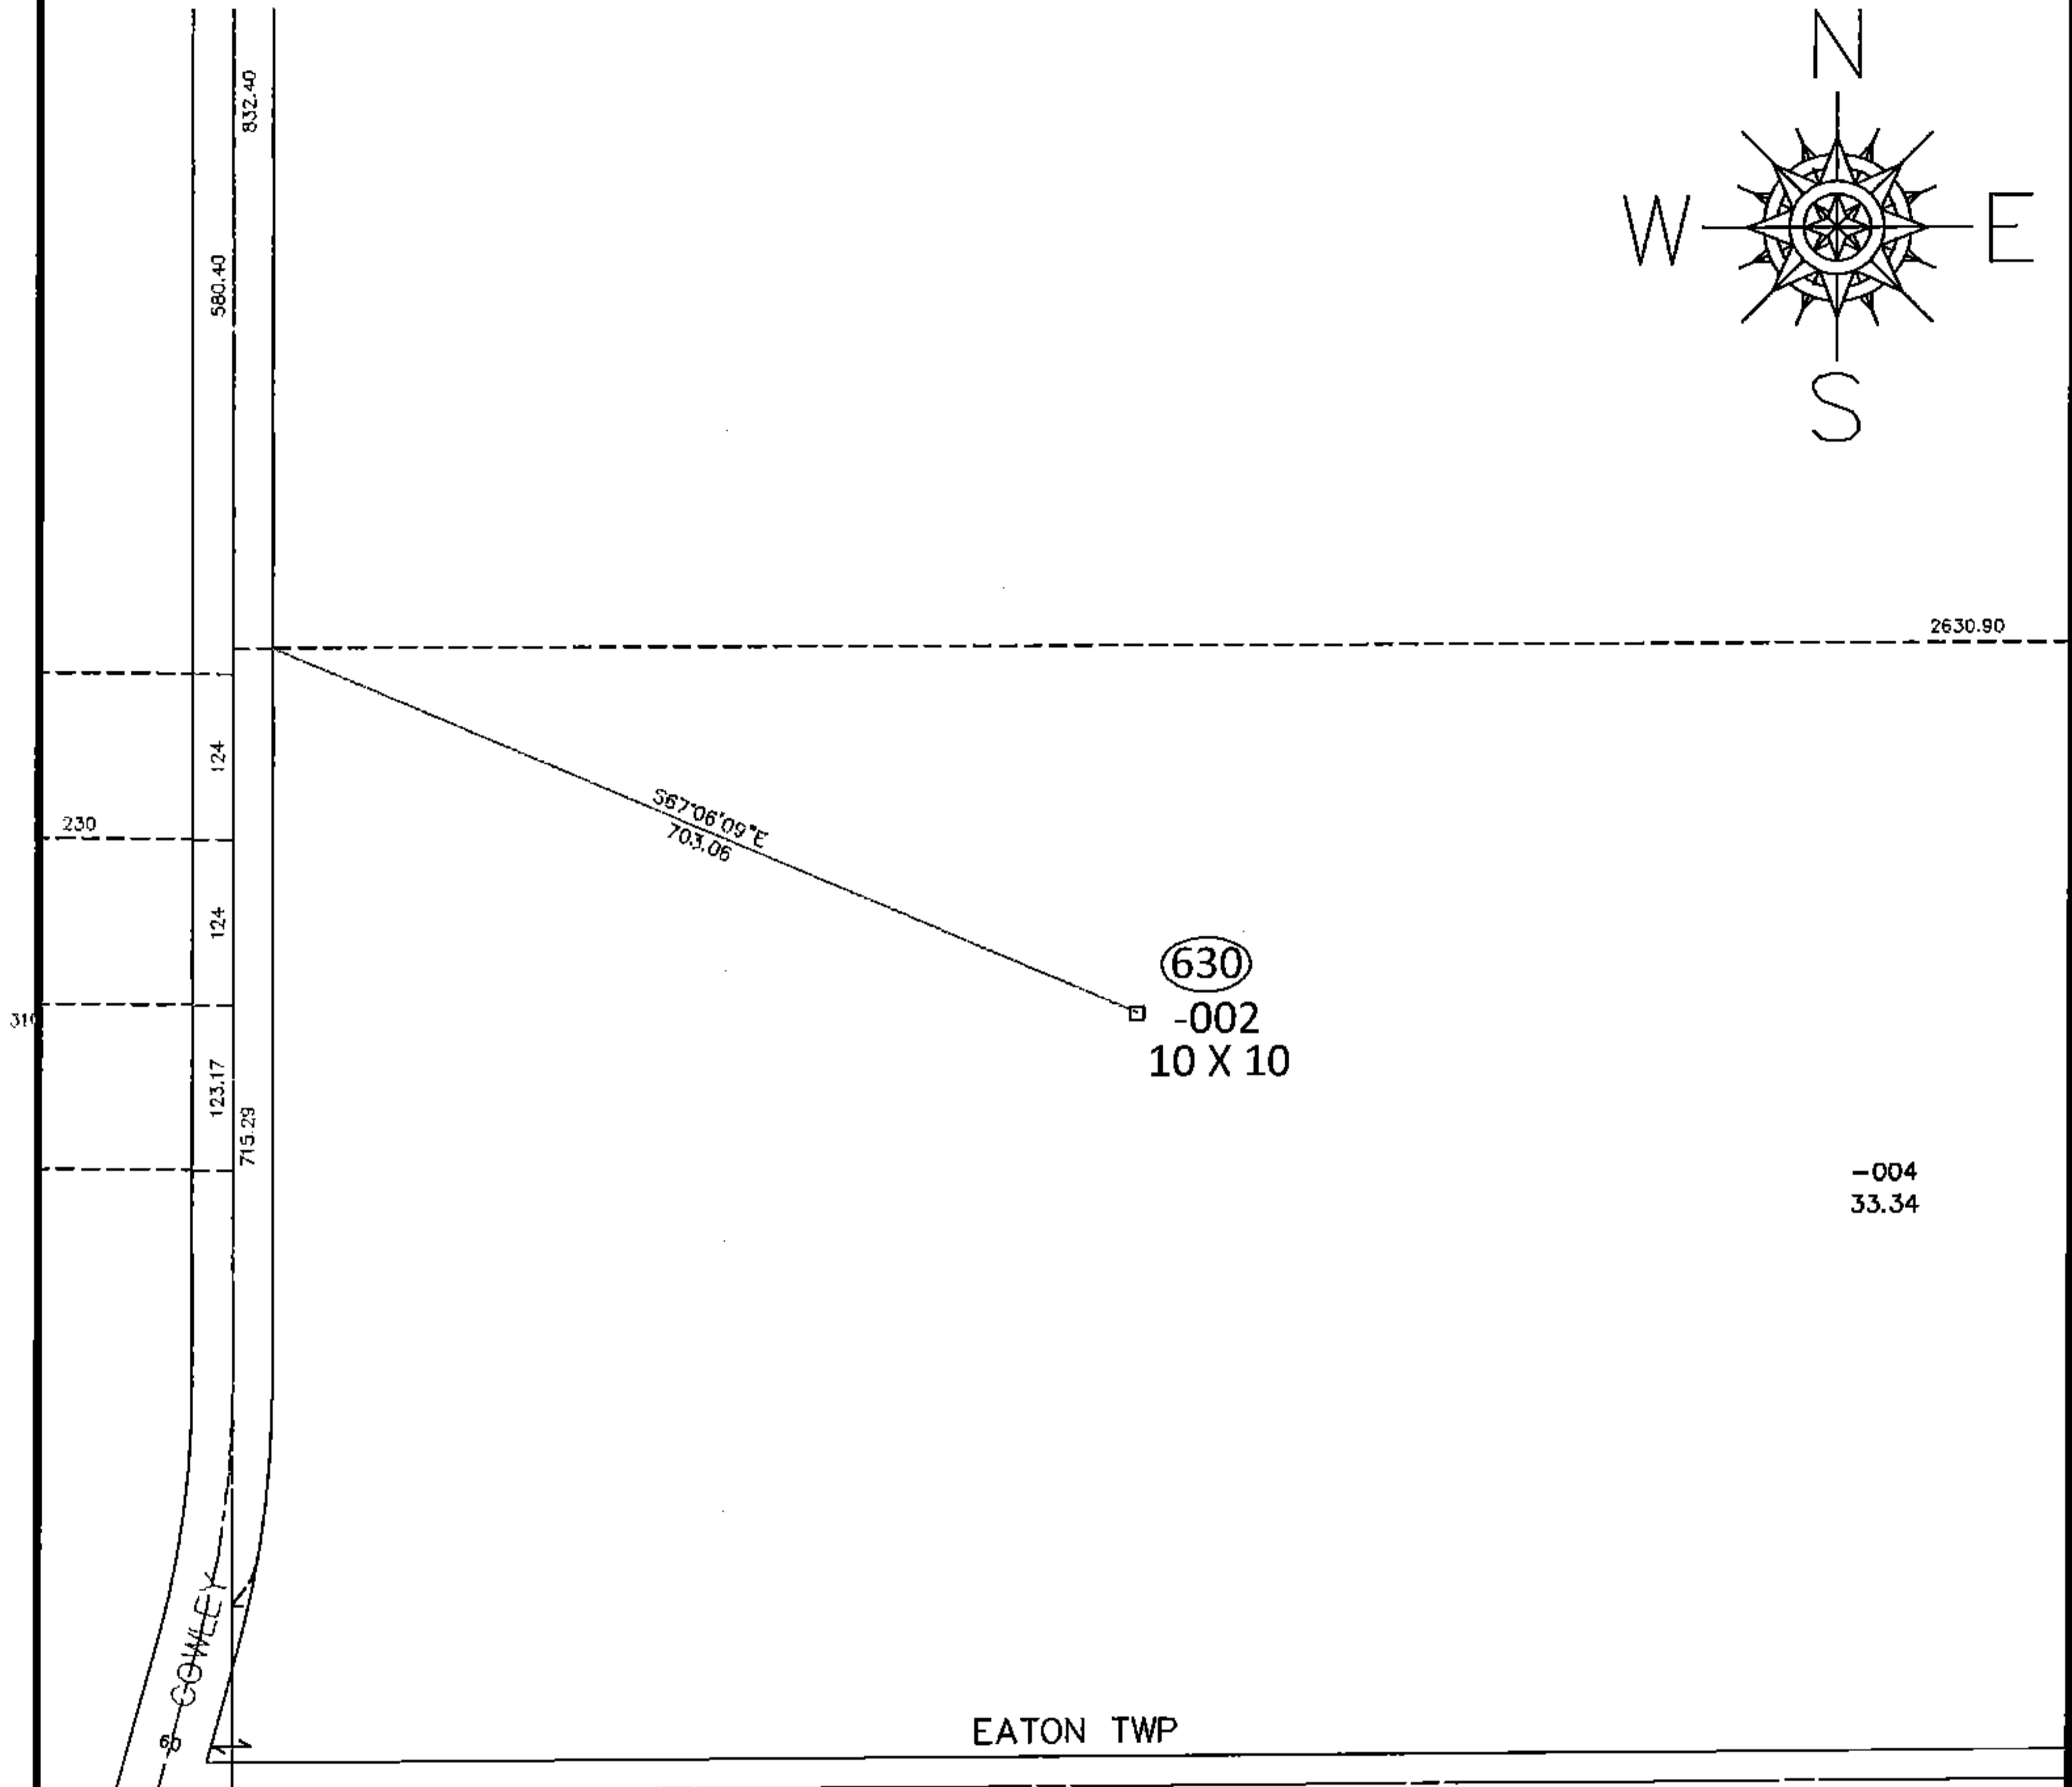


PARENT PARCEL: 11-00-001-000-004

CHILD PARCEL: 11-00-001-630-002

STARTING POINT:


15-03181-A

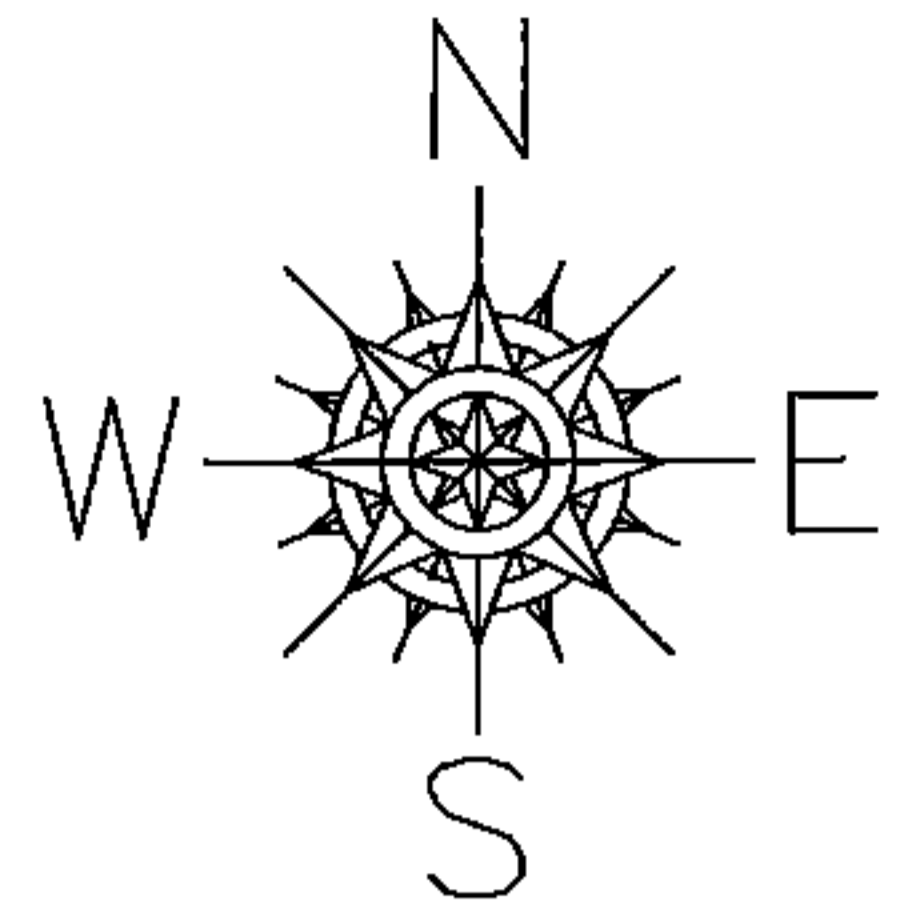

EATON TWP

ADD TO DUPLICATE

11-00-001-630-002  
10 X 10  
API #34093602540

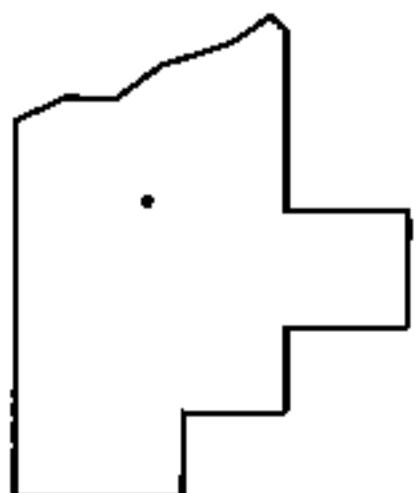

SPLITS/DEEDS PROCESSED

LORAIN COUNTY TAX MAP DEPARTMENT  
226 MIDDLE AVE. ELYRIA, OHIO

SURVEYED BY: N/A

CLOSURE: N/A

MAP PAGE(S): 11-00-001-A

APPROVED BY: RRM DATE: 5-6-15

SCALE: 1"=200

PRIOR INST.: