
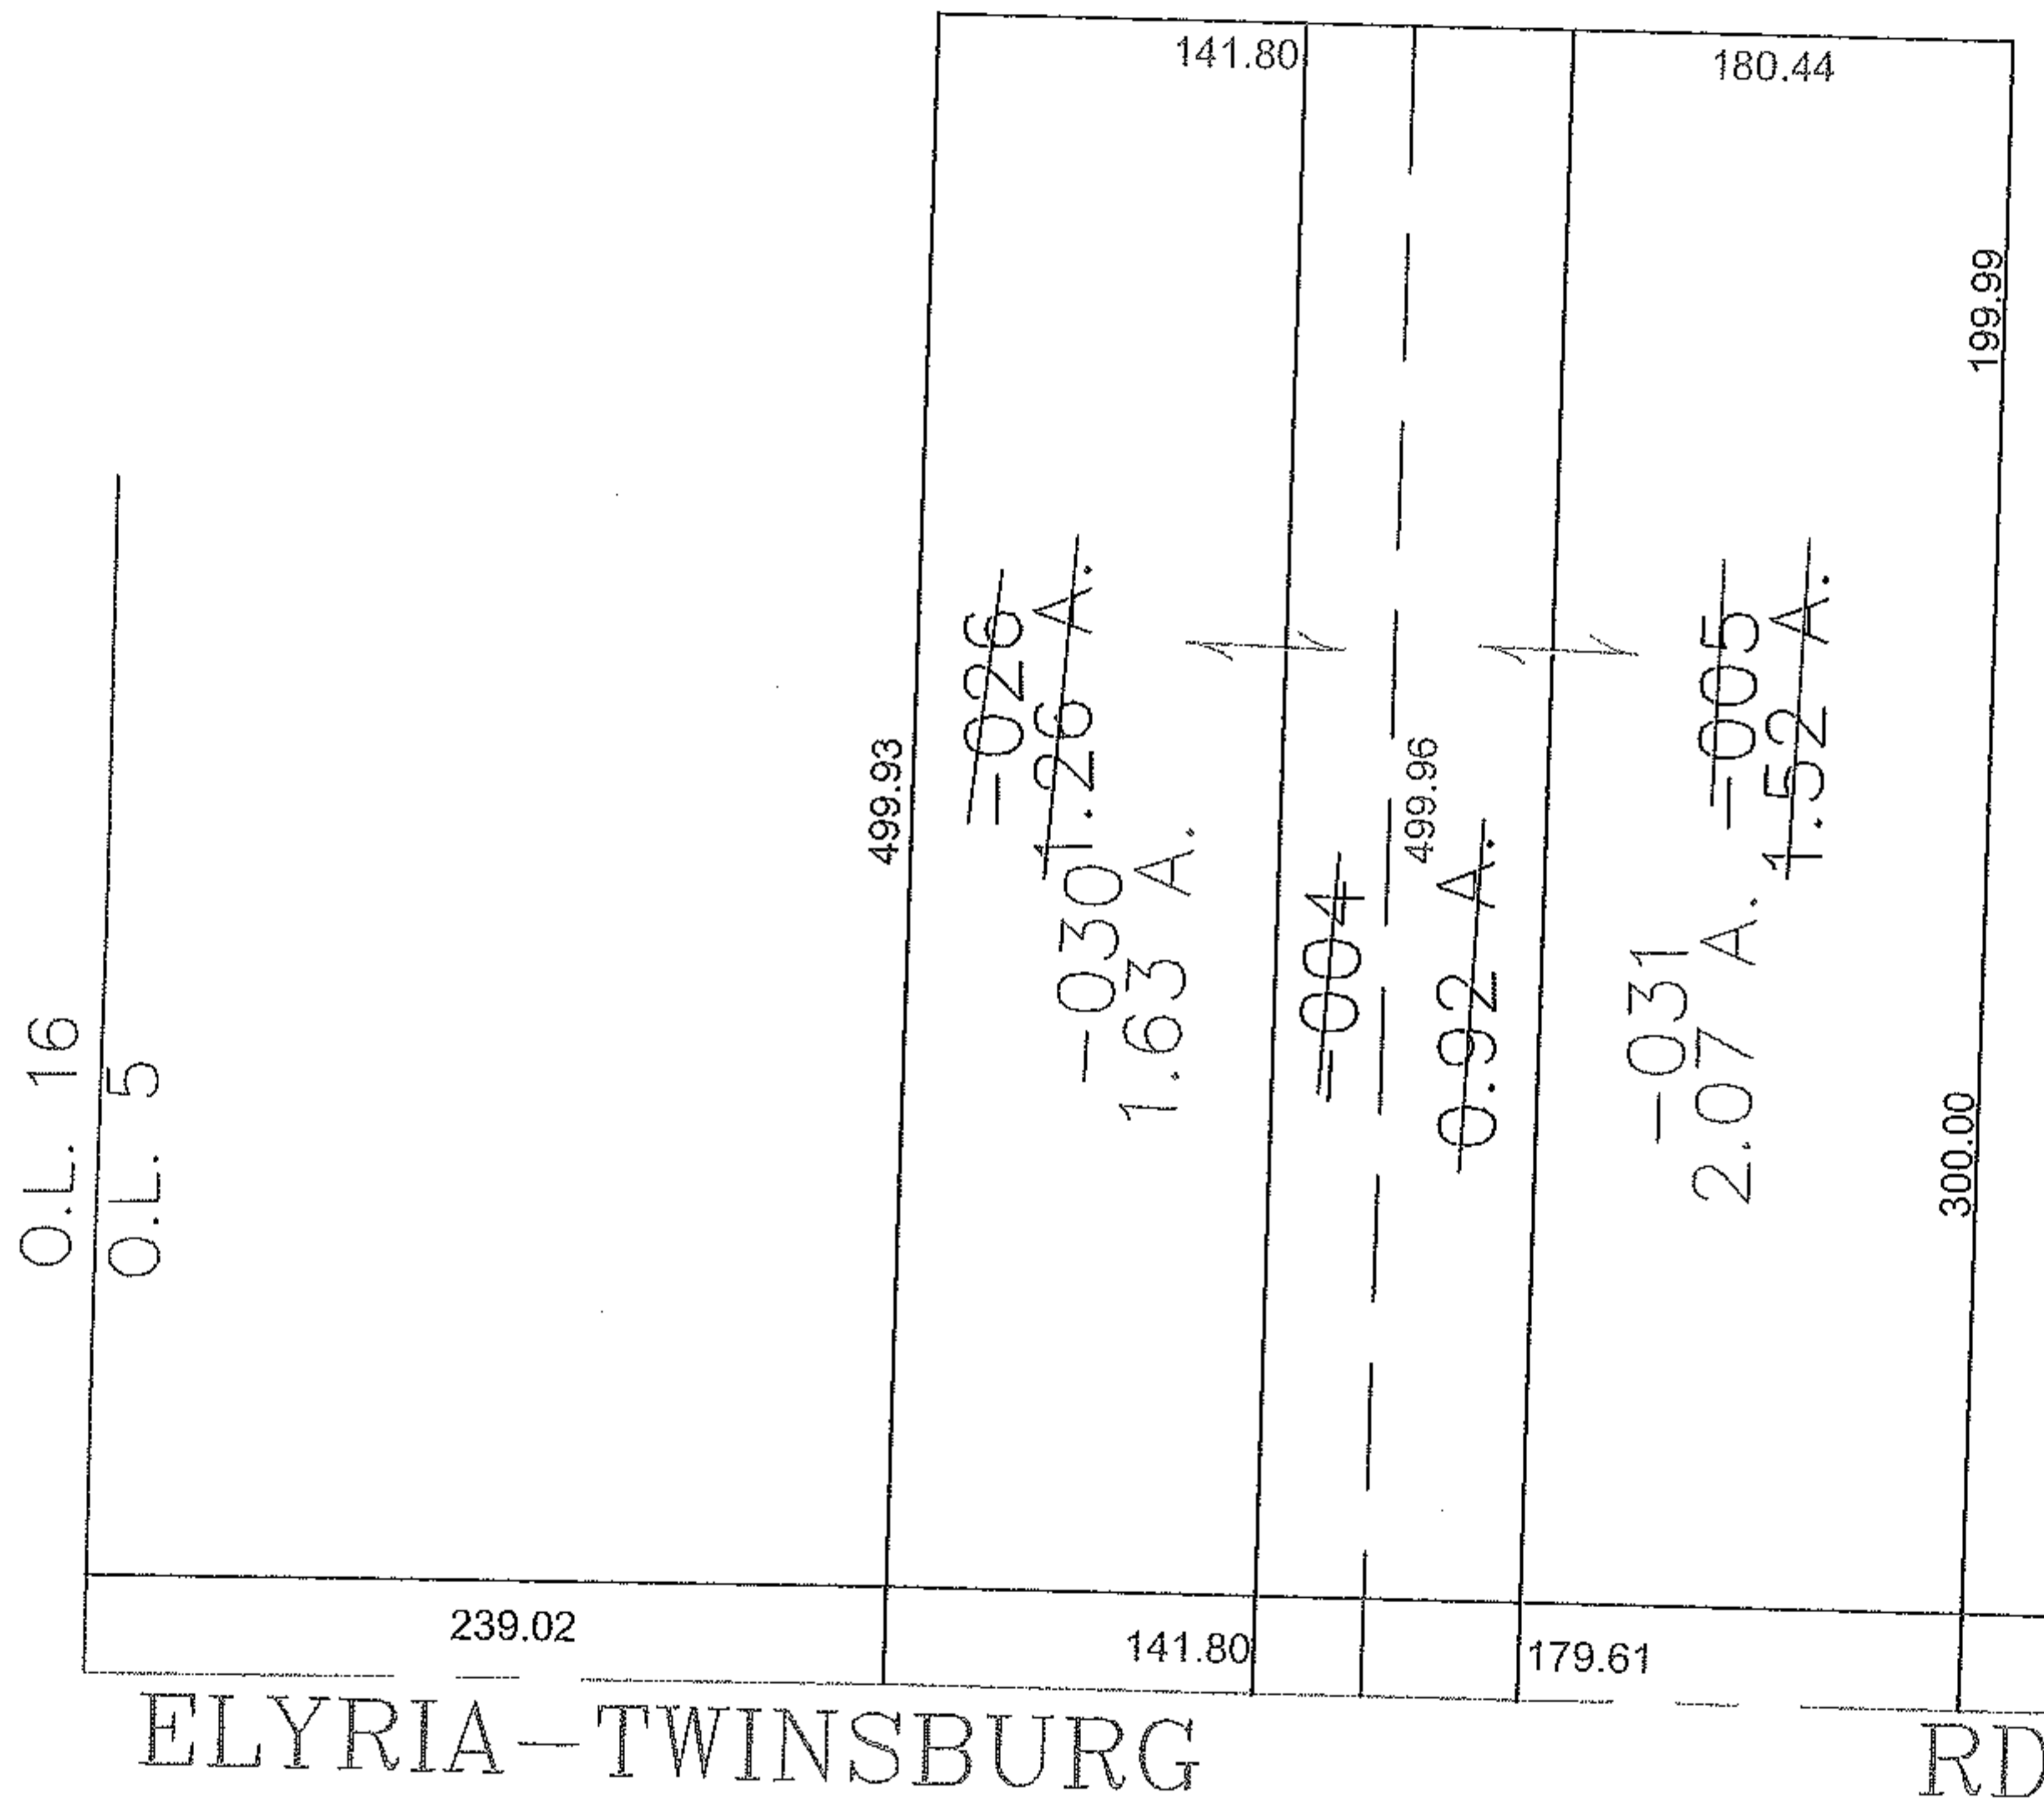


PARENT PARCEL: 12-00-005-101-005, -004, -026

CHILD PARCEL: 12-00-005-101-030, -031

STARTING POINT: CENTERLINE OF ELYRIA-TWINSBURG RD & O.L. 5

13-03181

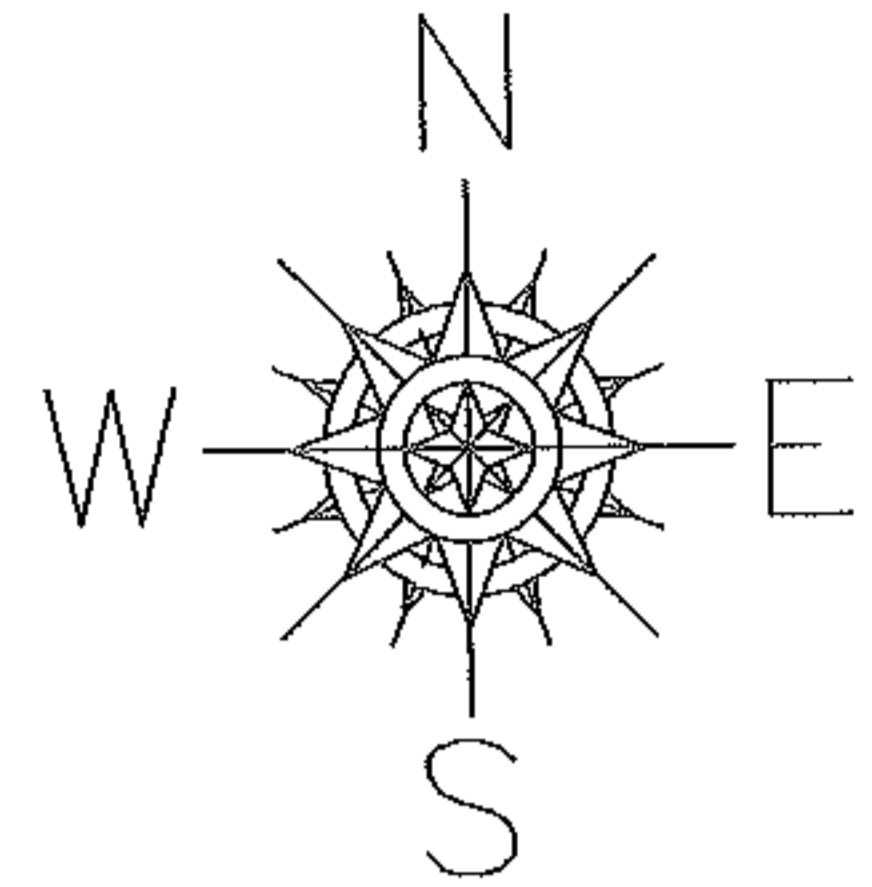

ELYRIA-TWINSBURG RD

SPLITS/DEEDS PROCESSED

LORAIN COUNTY TAX MAP DEPARTMENT
226 MIDDLE AVE. ELYRIA, OHIO

SURVEYED BY:	TIM FINKE
CLOSURE:	0.00 : 10.000
MAP PAGE(S):	12-00-005-A
APPROVED BY:	JAH
DATE:	9/12/2013
SCALE:	1"= 100
PRIOR INSTRUMENT:	DV 1179/108