
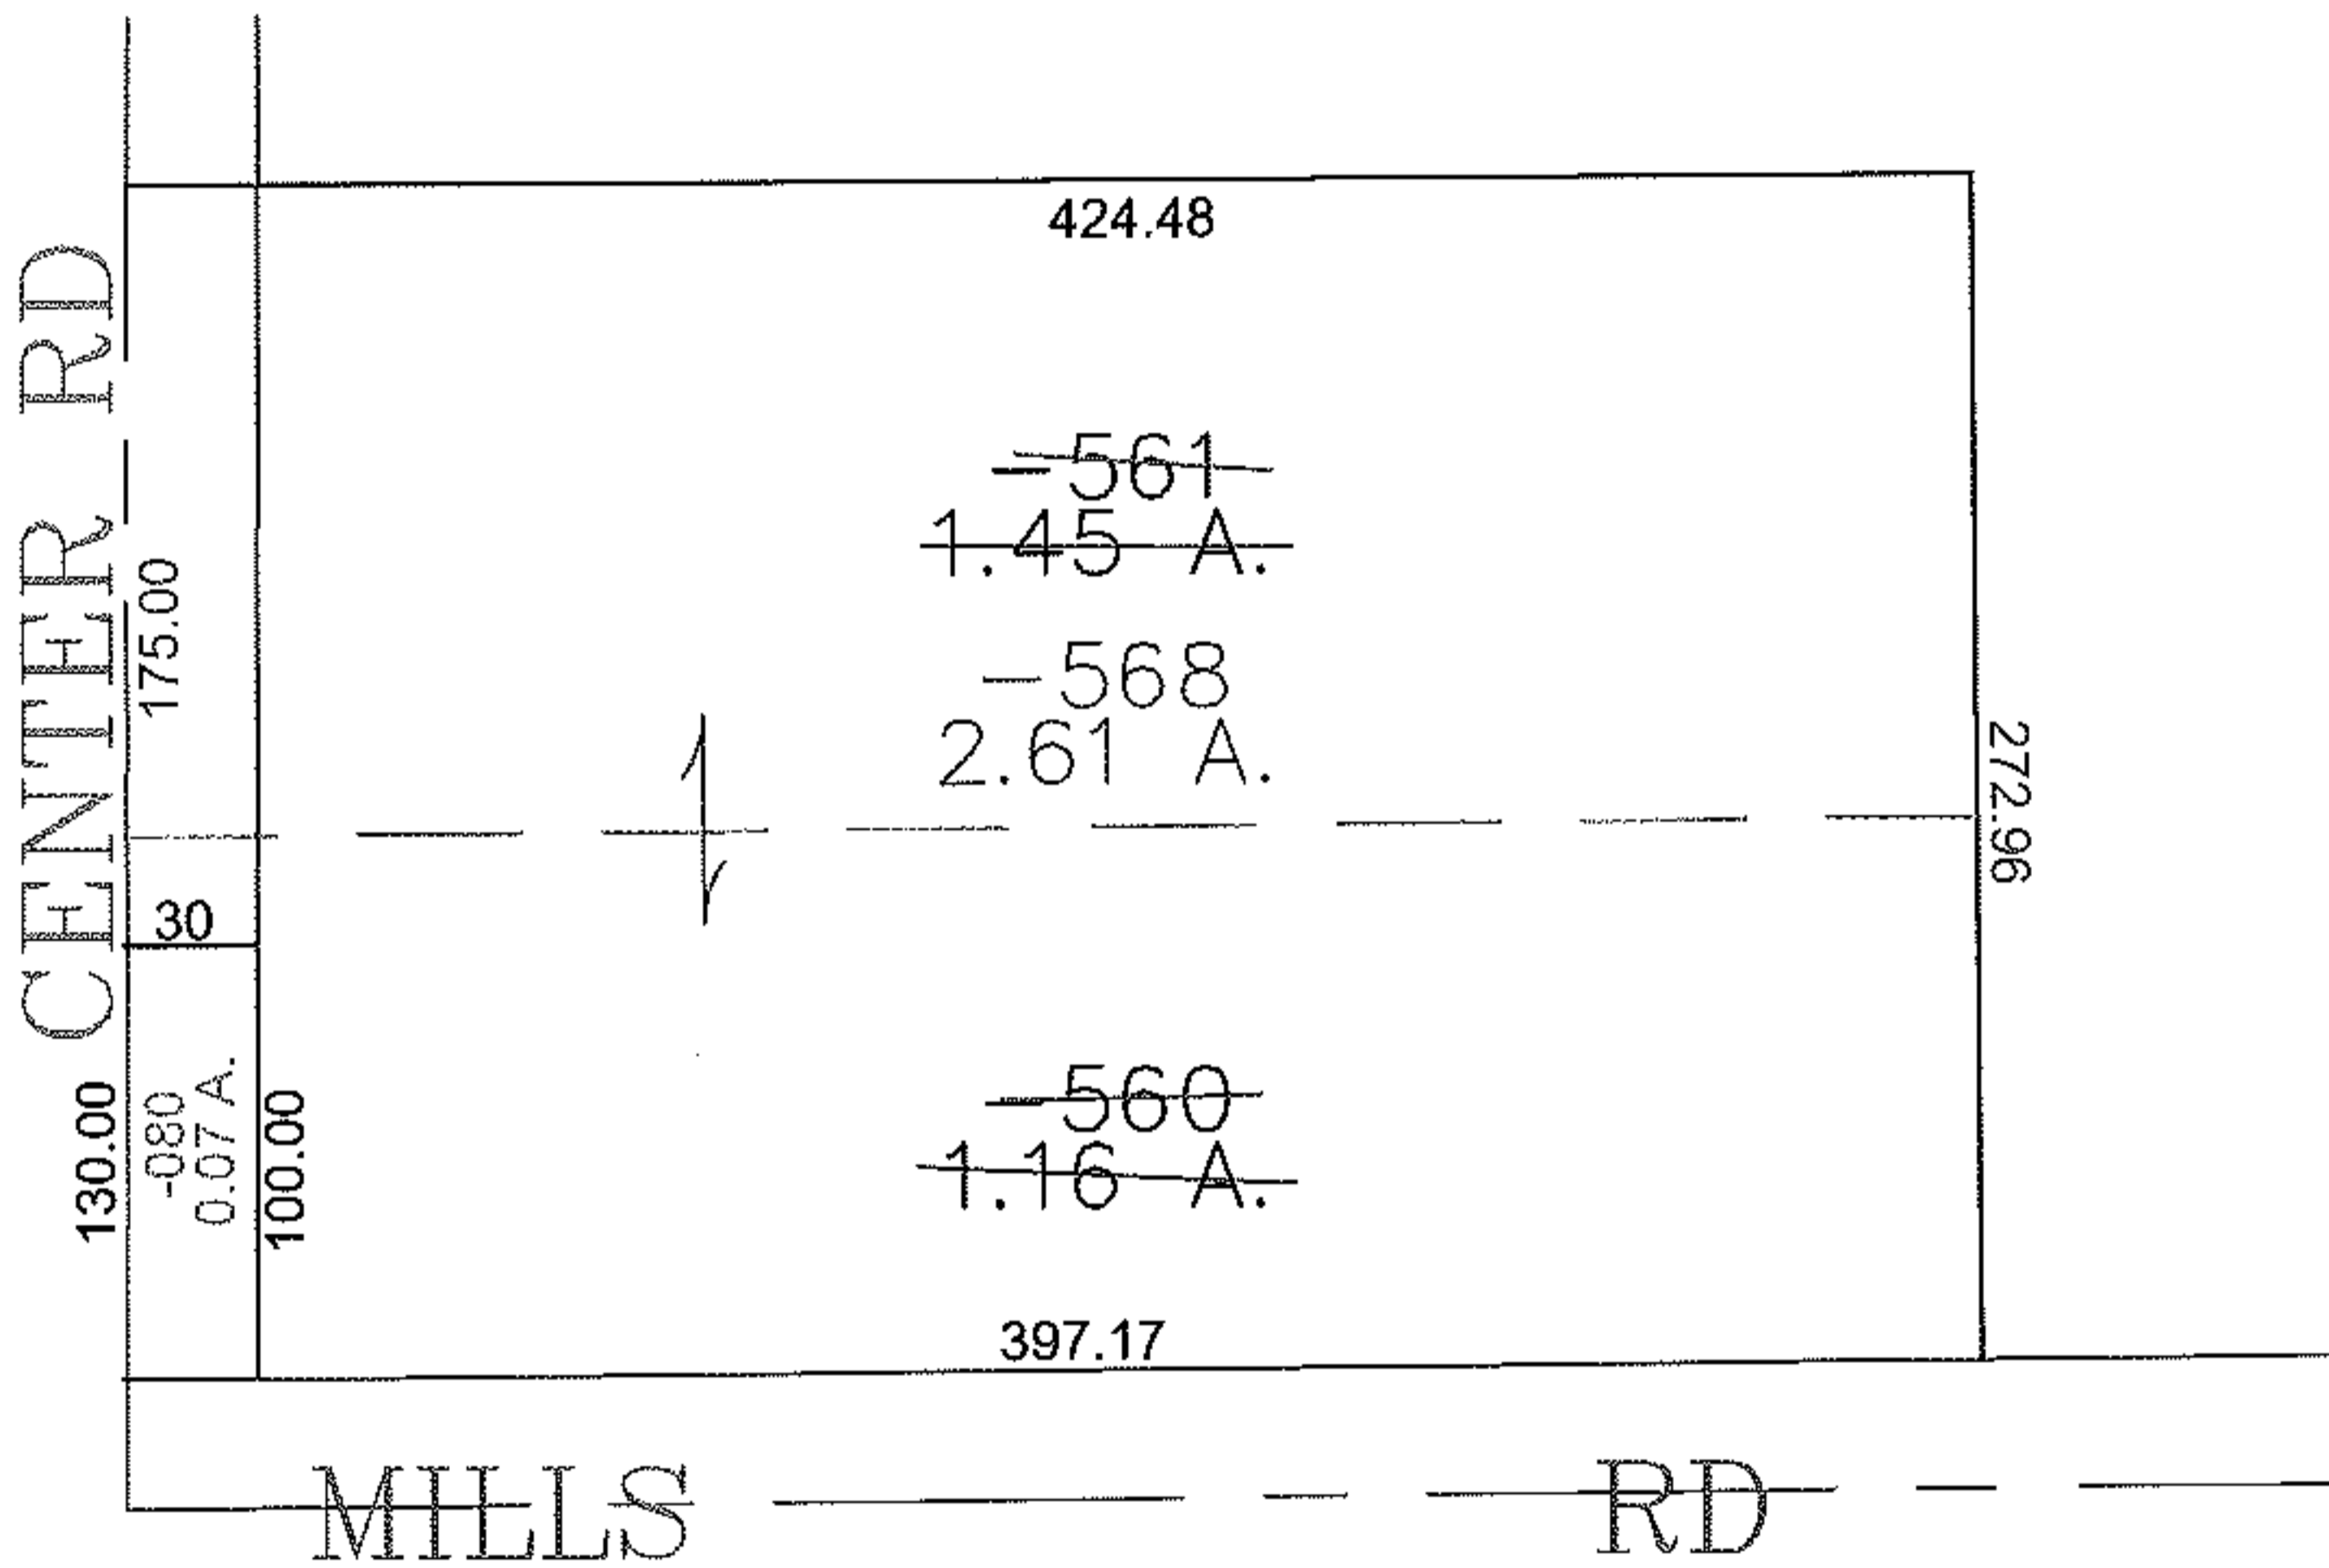


PARENT PARCEL: 04-00-013-000-560, -561

CHILD PARCEL: 04-00-013-000-568

STARTING POINT: CENTERLINE OF CENTER RD & MILLS RD

13-03183

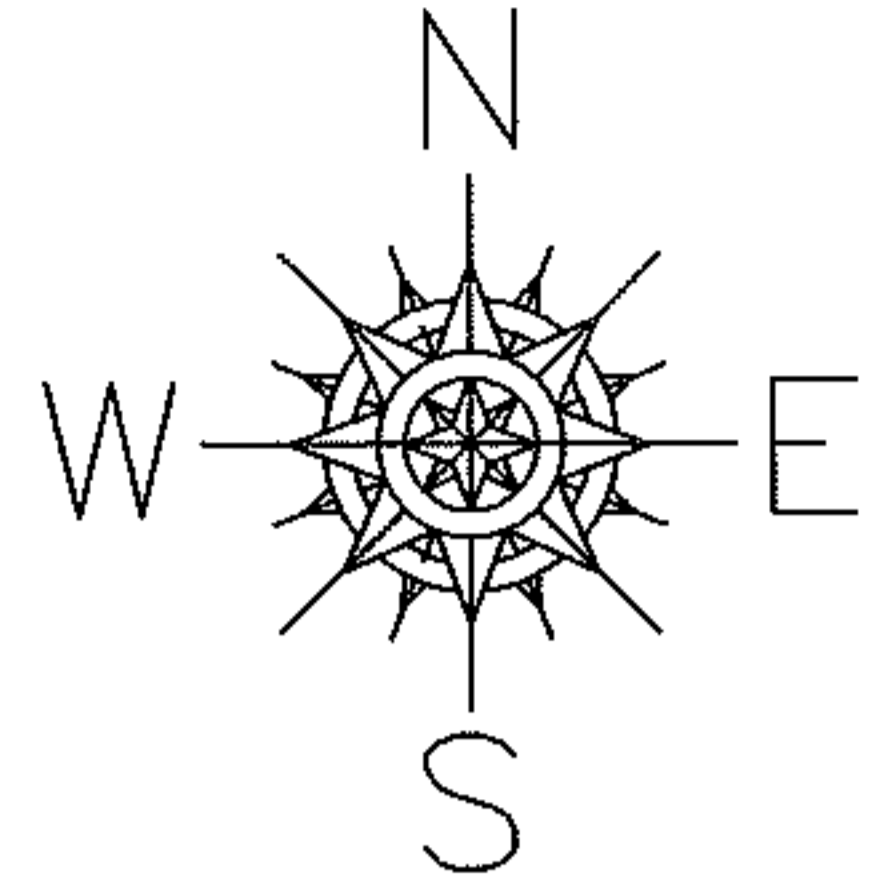

SPLITS/DEEDS PROCESSED

LORAIN COUNTY TAX MAP DEPARTMENT
226 MIDDLE AVE. ELYRIA, OHIO

SURVEYED BY: MICHAEL SPELLACY

CLOSURE: 0.00 : 10.000

MAP PAGE(S): 04-00-013-G

APPROVED BY: JAH DATE: 9-18-2013

SCALE: 1" = 100 PRIOR INSTRUMENT: 20110390541