
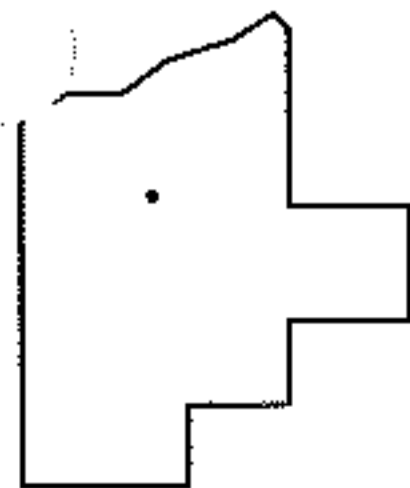
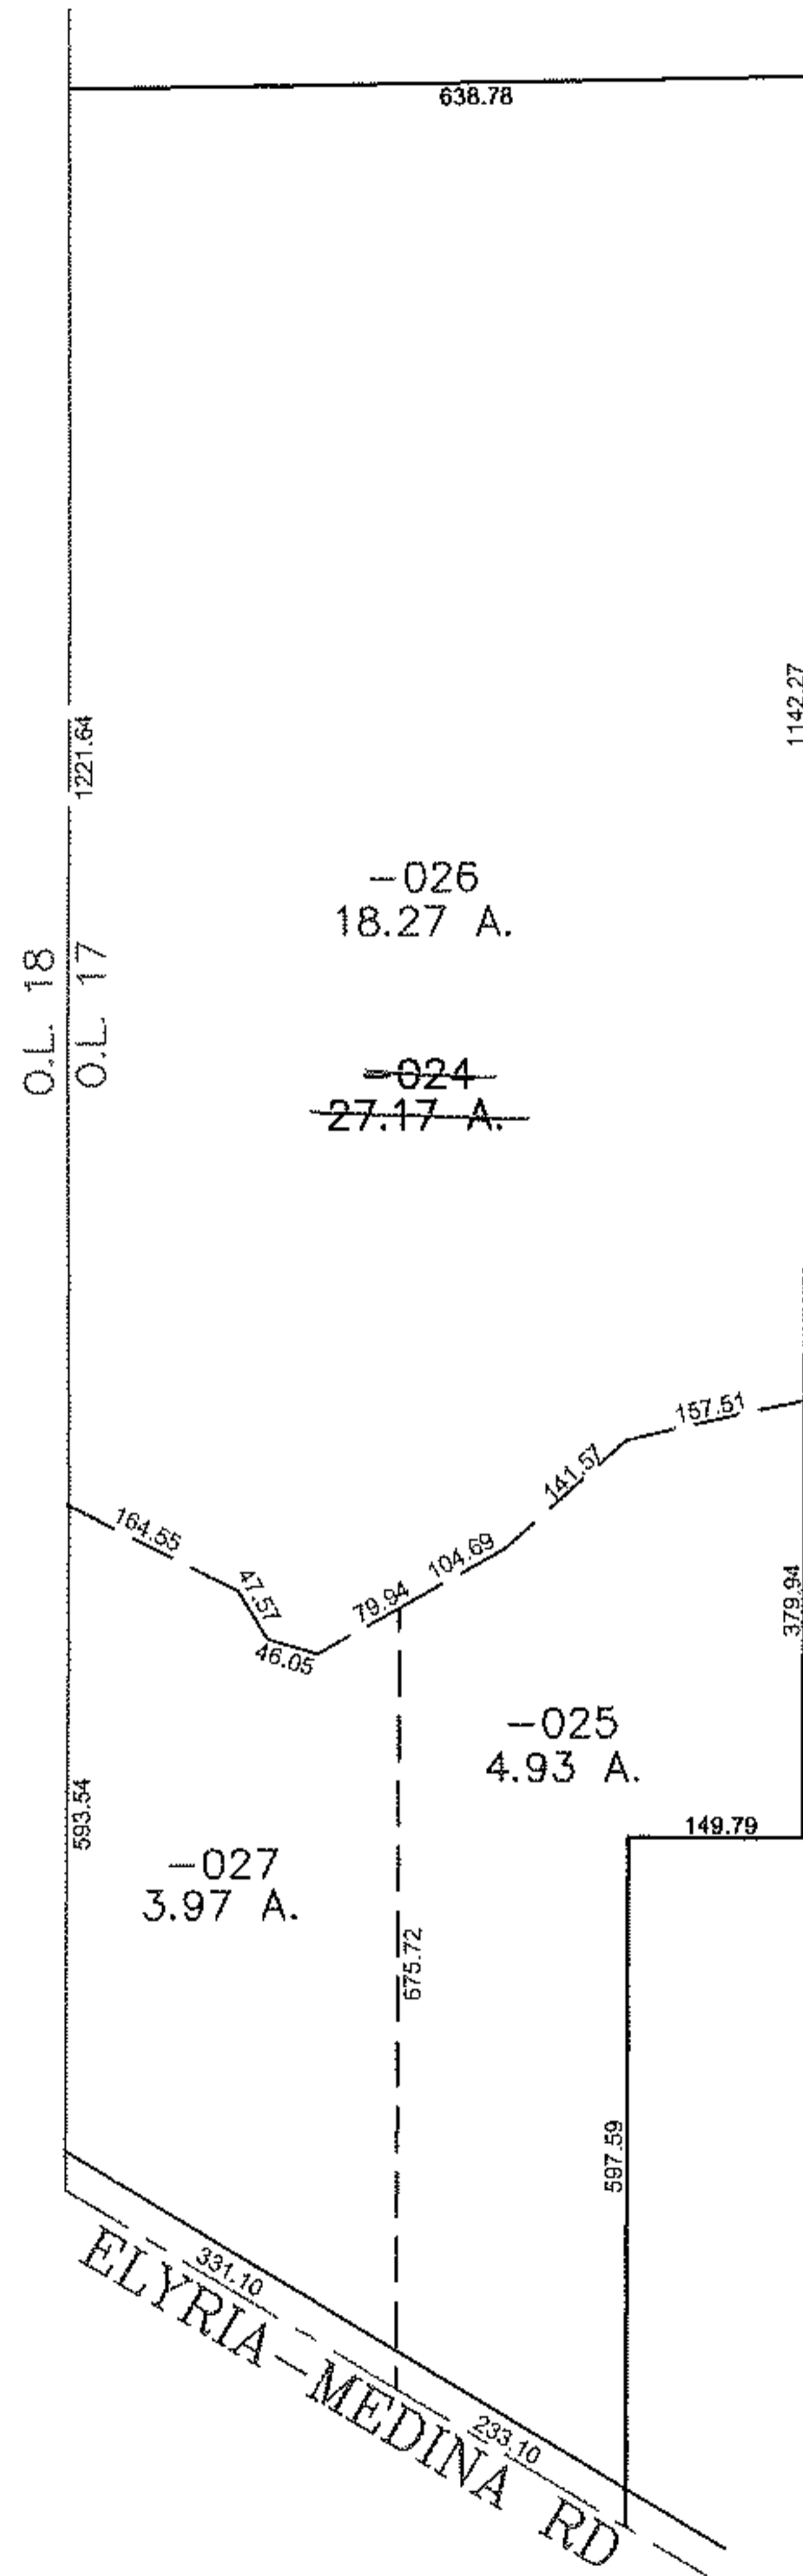


PARENT PARCEL: 16-00-017-000-024

CHILD PARCEL: 16-00-017-000-025, -026, -027

STARTING POINT: CENTERLINE OF ELYRIA-MEDINA RD & O.L. 17

13-03185

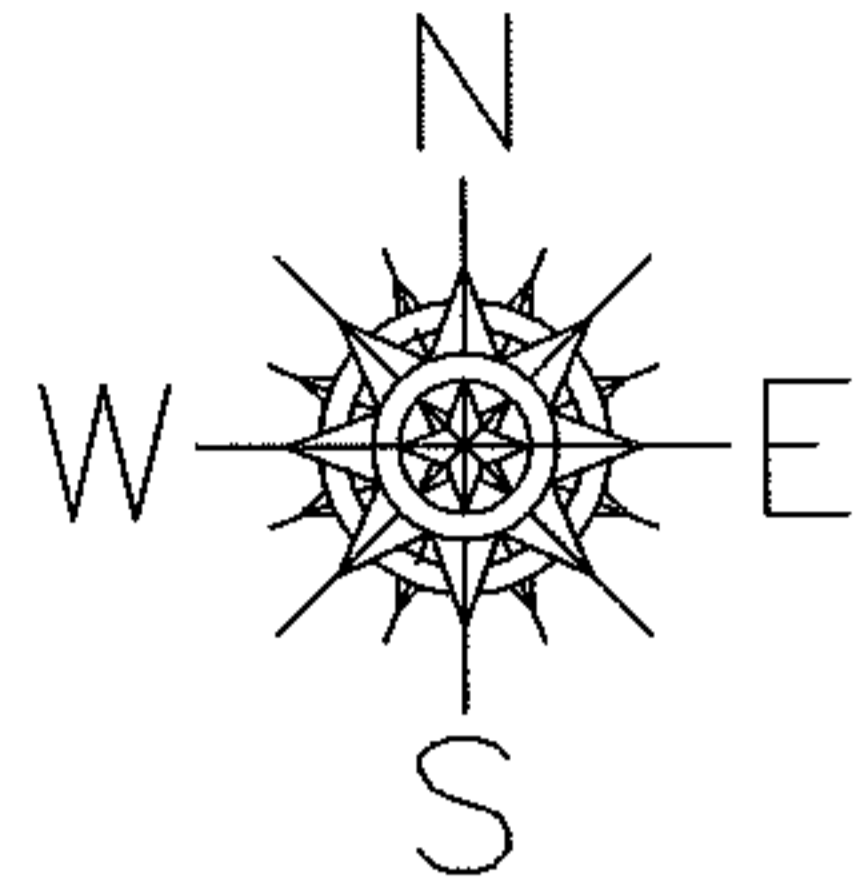

SPLITS/DEEDS PROCESSED
 LORAIN COUNTY TAX MAP DEPARTMENT
 226 MIDDLE AVE. ELYRIA, OHIO

SURVEYED BY: THOMAS SIMON
 CLOSURE: 0.00 : 10.000
 MAP PAGE(S): 16-B
 APPROVED BY: JAH DATE: 9/23/2013
 SCALE: 1" = 300 PRIOR INSTRUMENT: 20110373778