
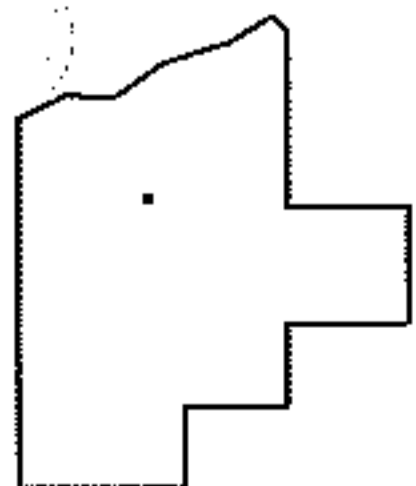
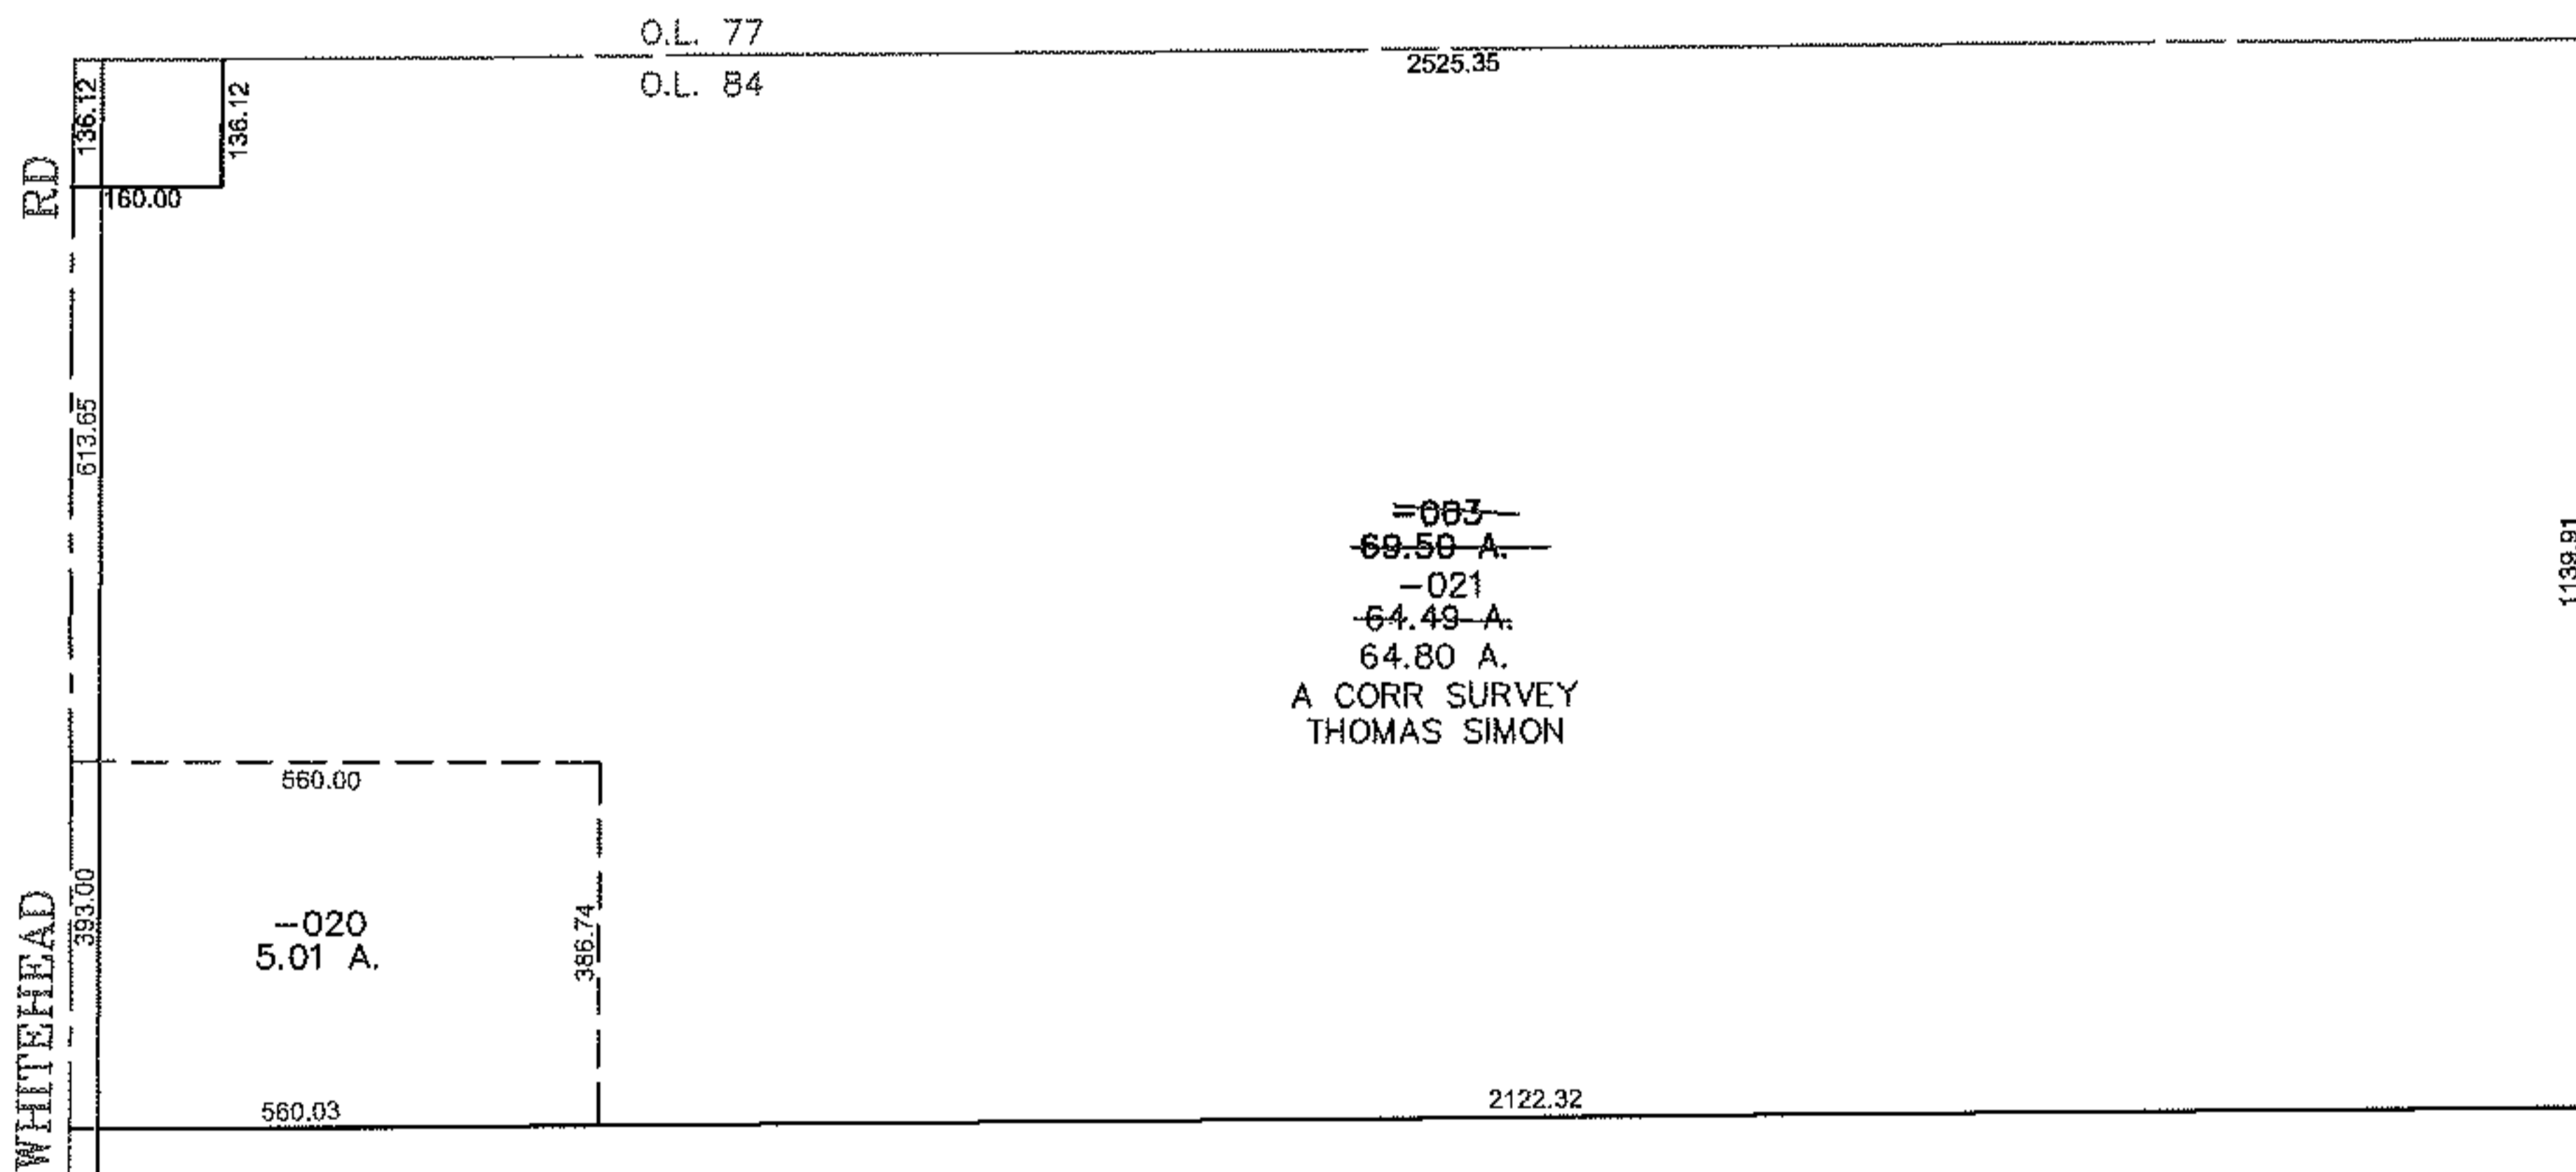


PARENT PARCEL: 15-00-084-000-003

CHILD PARCEL: 15-00-084-000-020, -021

STARTING POINT: CENTERLINE OF WHITEHEAD RD & O.L. 84

13-03187

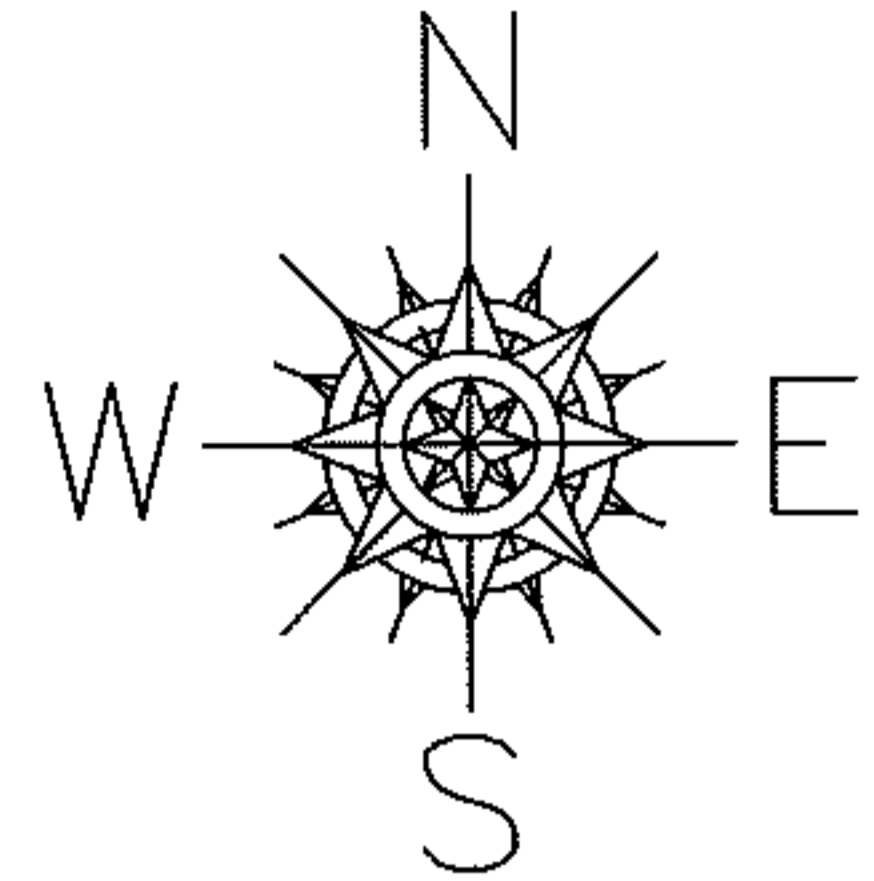

SPLITS/DEEDS PROCESSED

LORAIN COUNTY TAX MAP DEPARTMENT
226 MIDDLE AVE. ELYRIA, OHIO

SURVEYED BY: THOMAS SIMON

CLOSURE: 0.00 : 10,000

MAP PAGE(S): 15-F

APPROVED BY: JAH DATE: 9/24/2013

SCALE: 1"= 400 PRIOR INST.: 20010776319