


PARENT PARCEL: 04-00-026-109-260

CHILD PARCEL: 04-00-026-630-002

15-03189-A

STARTING POINT:

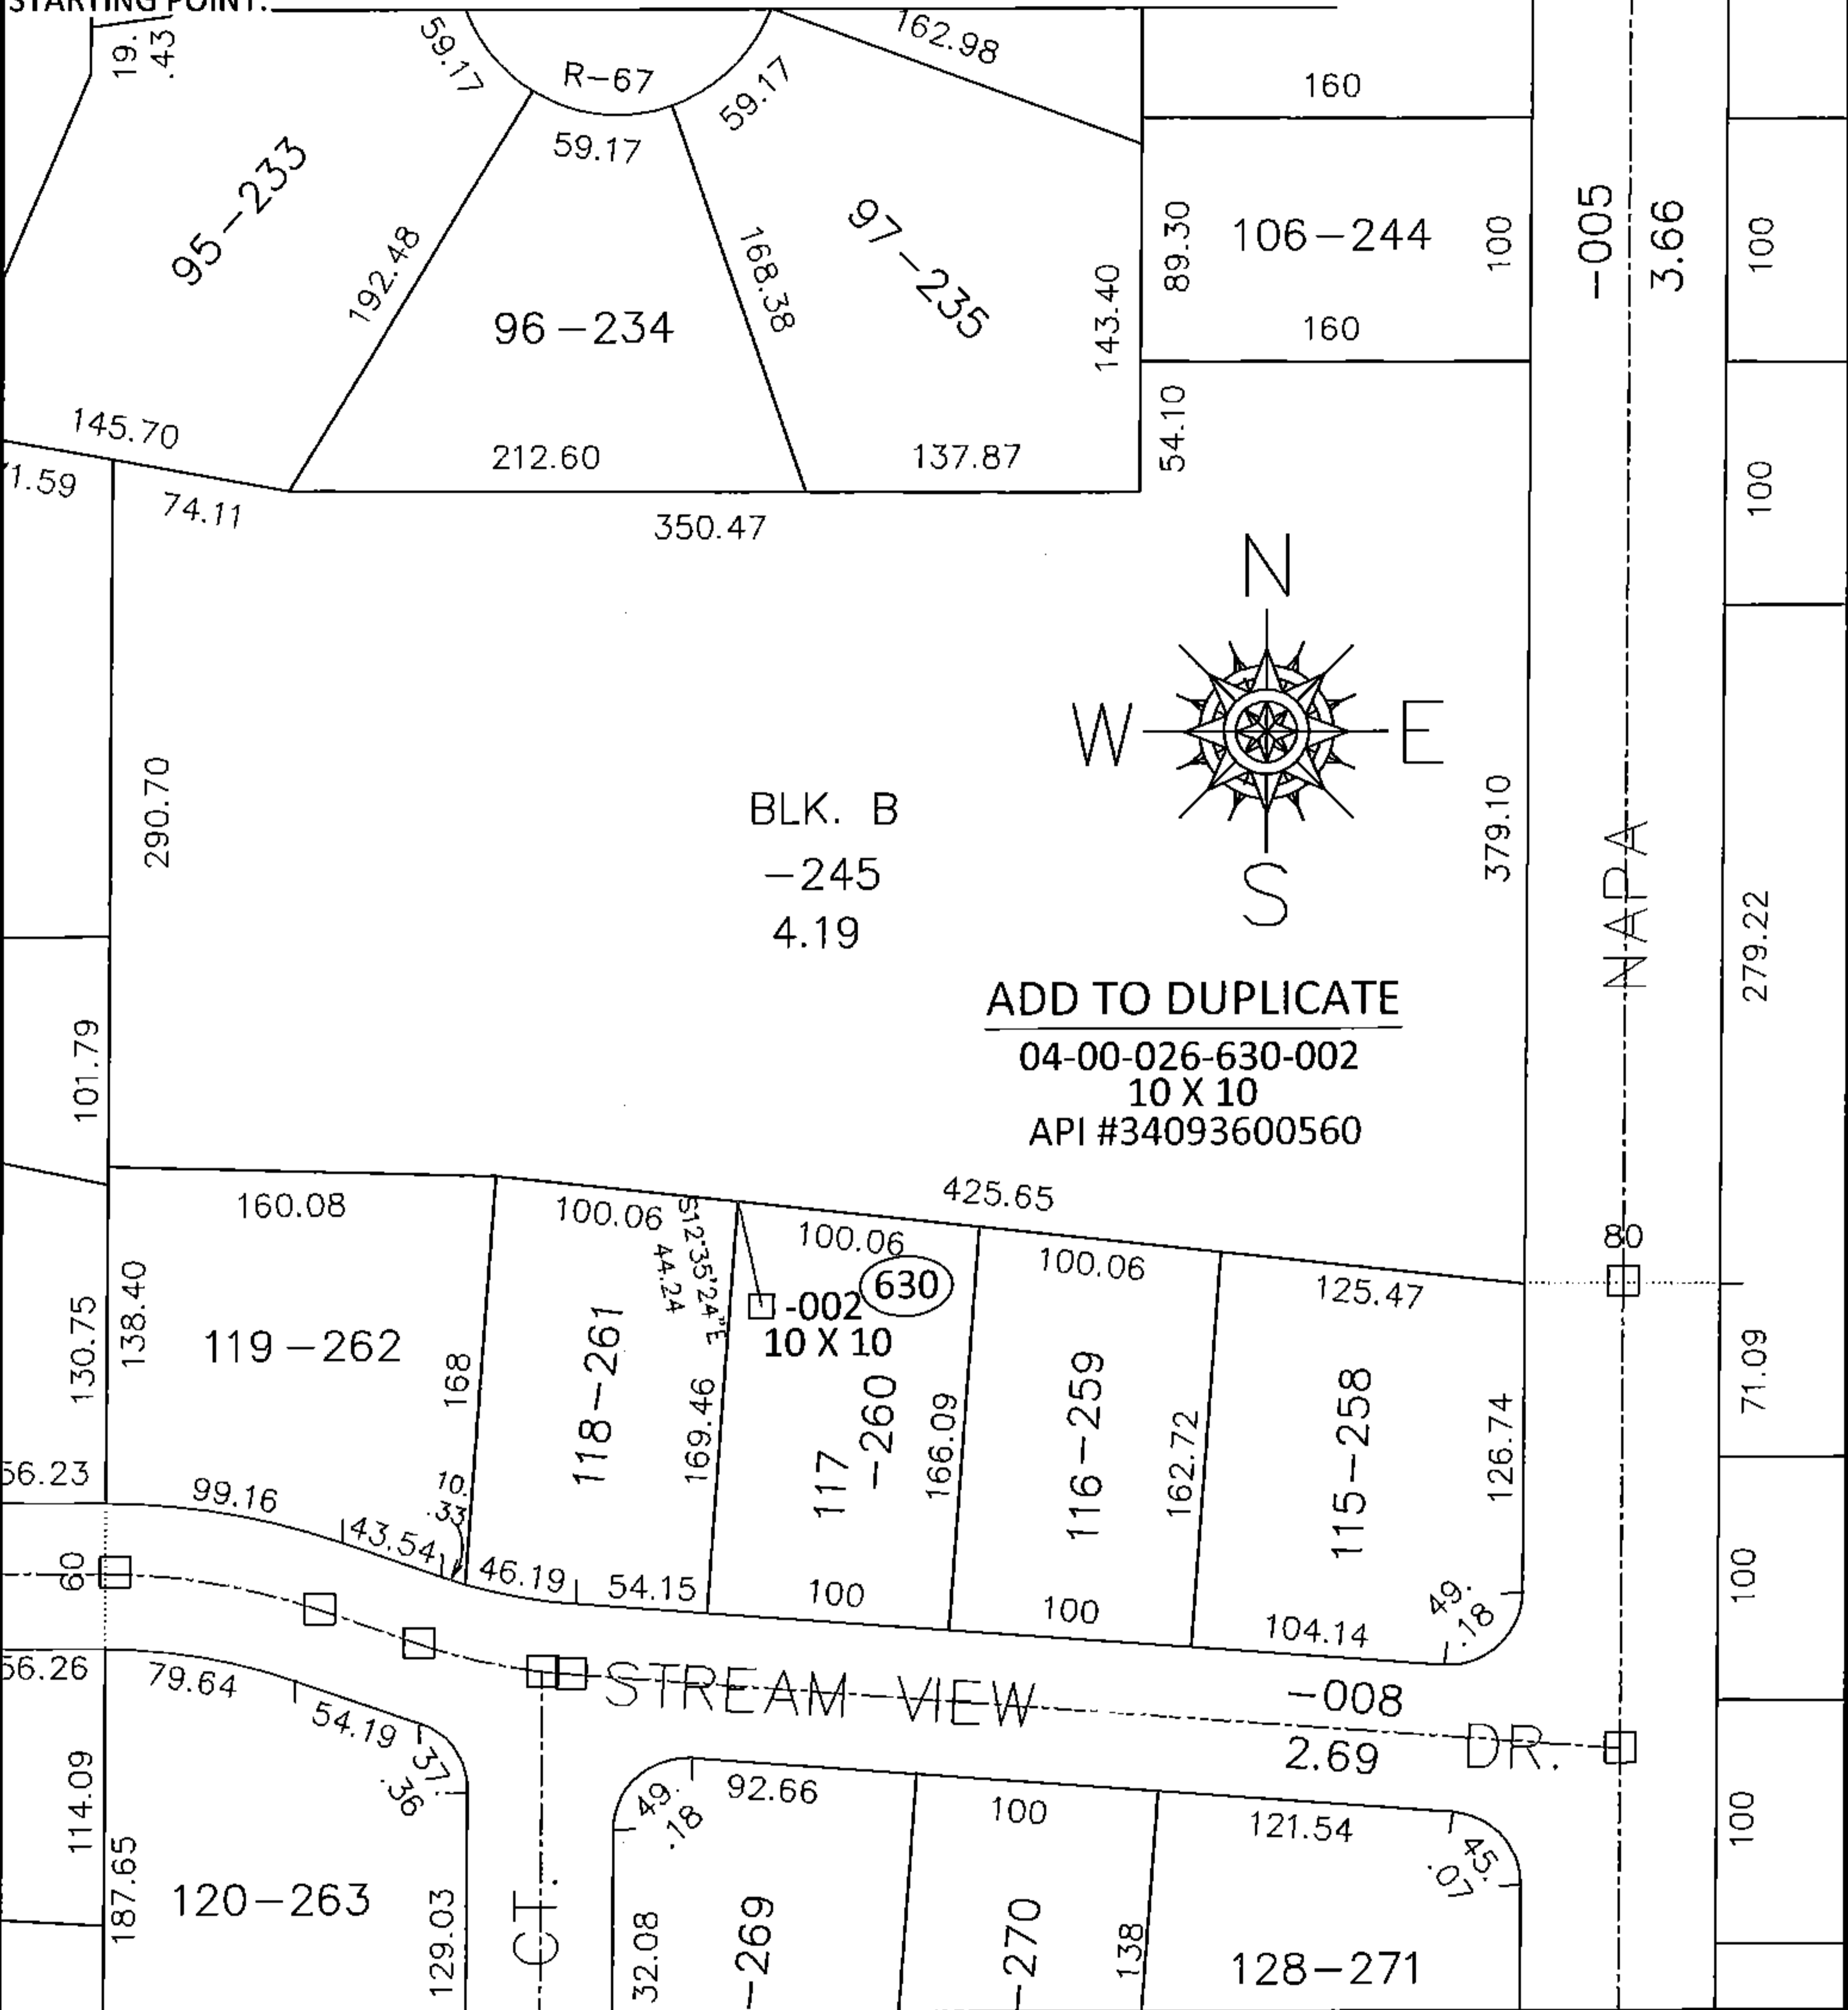

ADD TO DUPLICATE

04-00-026-630-002

10 X 10

API #34093600560

SPLITS/DEEDS PROCESSED

LORAIN COUNTY TAX MAP DEPARTMENT
226 MIDDLE AVE. ELYRIA, OHIO

SURVEYED BY: N/A

CLOSURE: N/A

MAP PAGE(S): 4-00-026-E

APPROVED BY: RRM DATE: 5-11-15

SCALE: 1"= 100

PRIOR INST.: