


PARENT PARCEL: 06-22-019-000-002, -010, -003, -004 06-21-005-105-020

CHILD PARCEL: 06-21-005-105-042 THRU -045 06-22-019-000-010, -011

STARTING POINT: CENTERLINE OF ELYRIA AVE & SW CORNER OF WILBUR HEIGHTS SUBD

13-03189

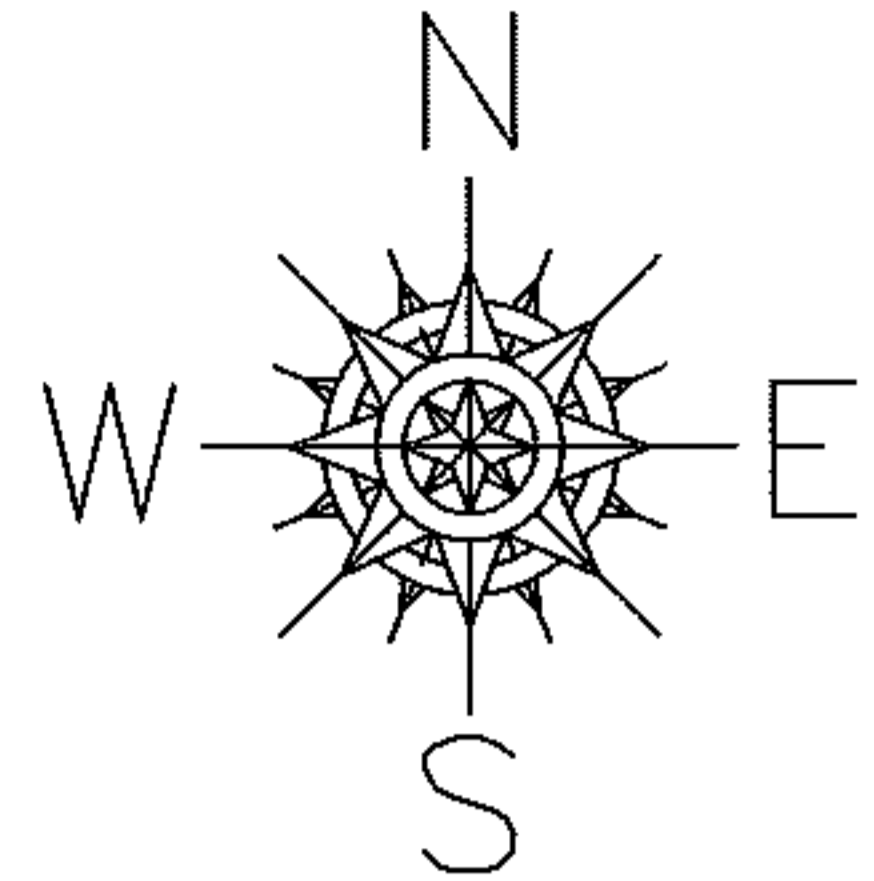



1

WILBUR HEIGHTS SUBD
VOL 5 PG 13

ELYRIA

ELYRIA AVE
1000.00
1000.00
1000.00
1000.00

NEWBERRY TR O.L. 5
BURRELL & DAY TR O.L. 19

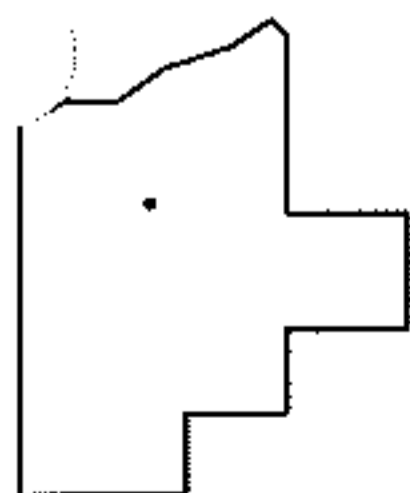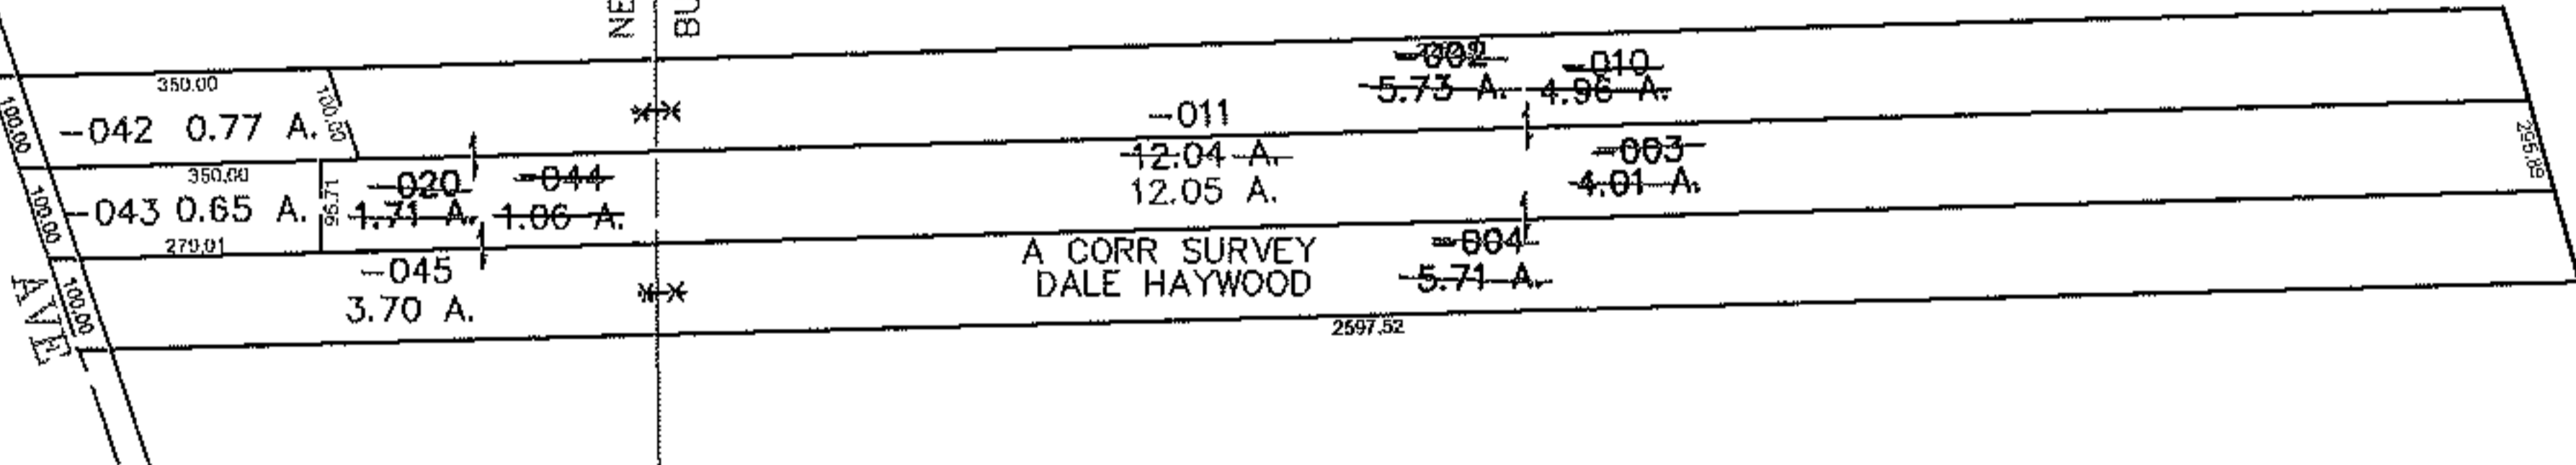

SPLITS/DEEDS PROCESSED

LORAIN COUNTY TAX MAP DEPARTMENT
226 MIDDLE AVE. ELYRIA, OHIO

SURVEYED BY: DALE HAYWOOD

CLOSURE: 0.00 : 10,000

MAP PAGE(S): 6-5, 6-6

APPROVED BY: JAH DATE: 9/25/2013

SCALE: 1" = 400 PRIOR INST.: 20100356820