


PARENT PARCEL: 12-00-002-630-001, -002


CHILD PARCEL: _____

STARTING POINT: _____

15-03191-C

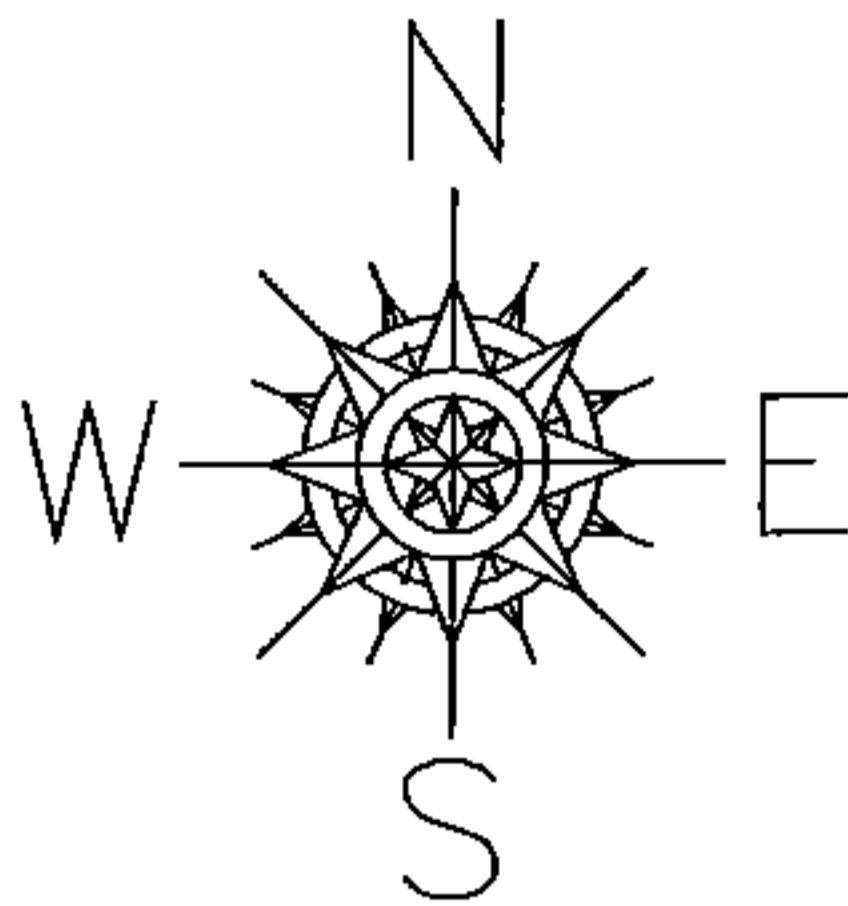

~~(630) X001~~

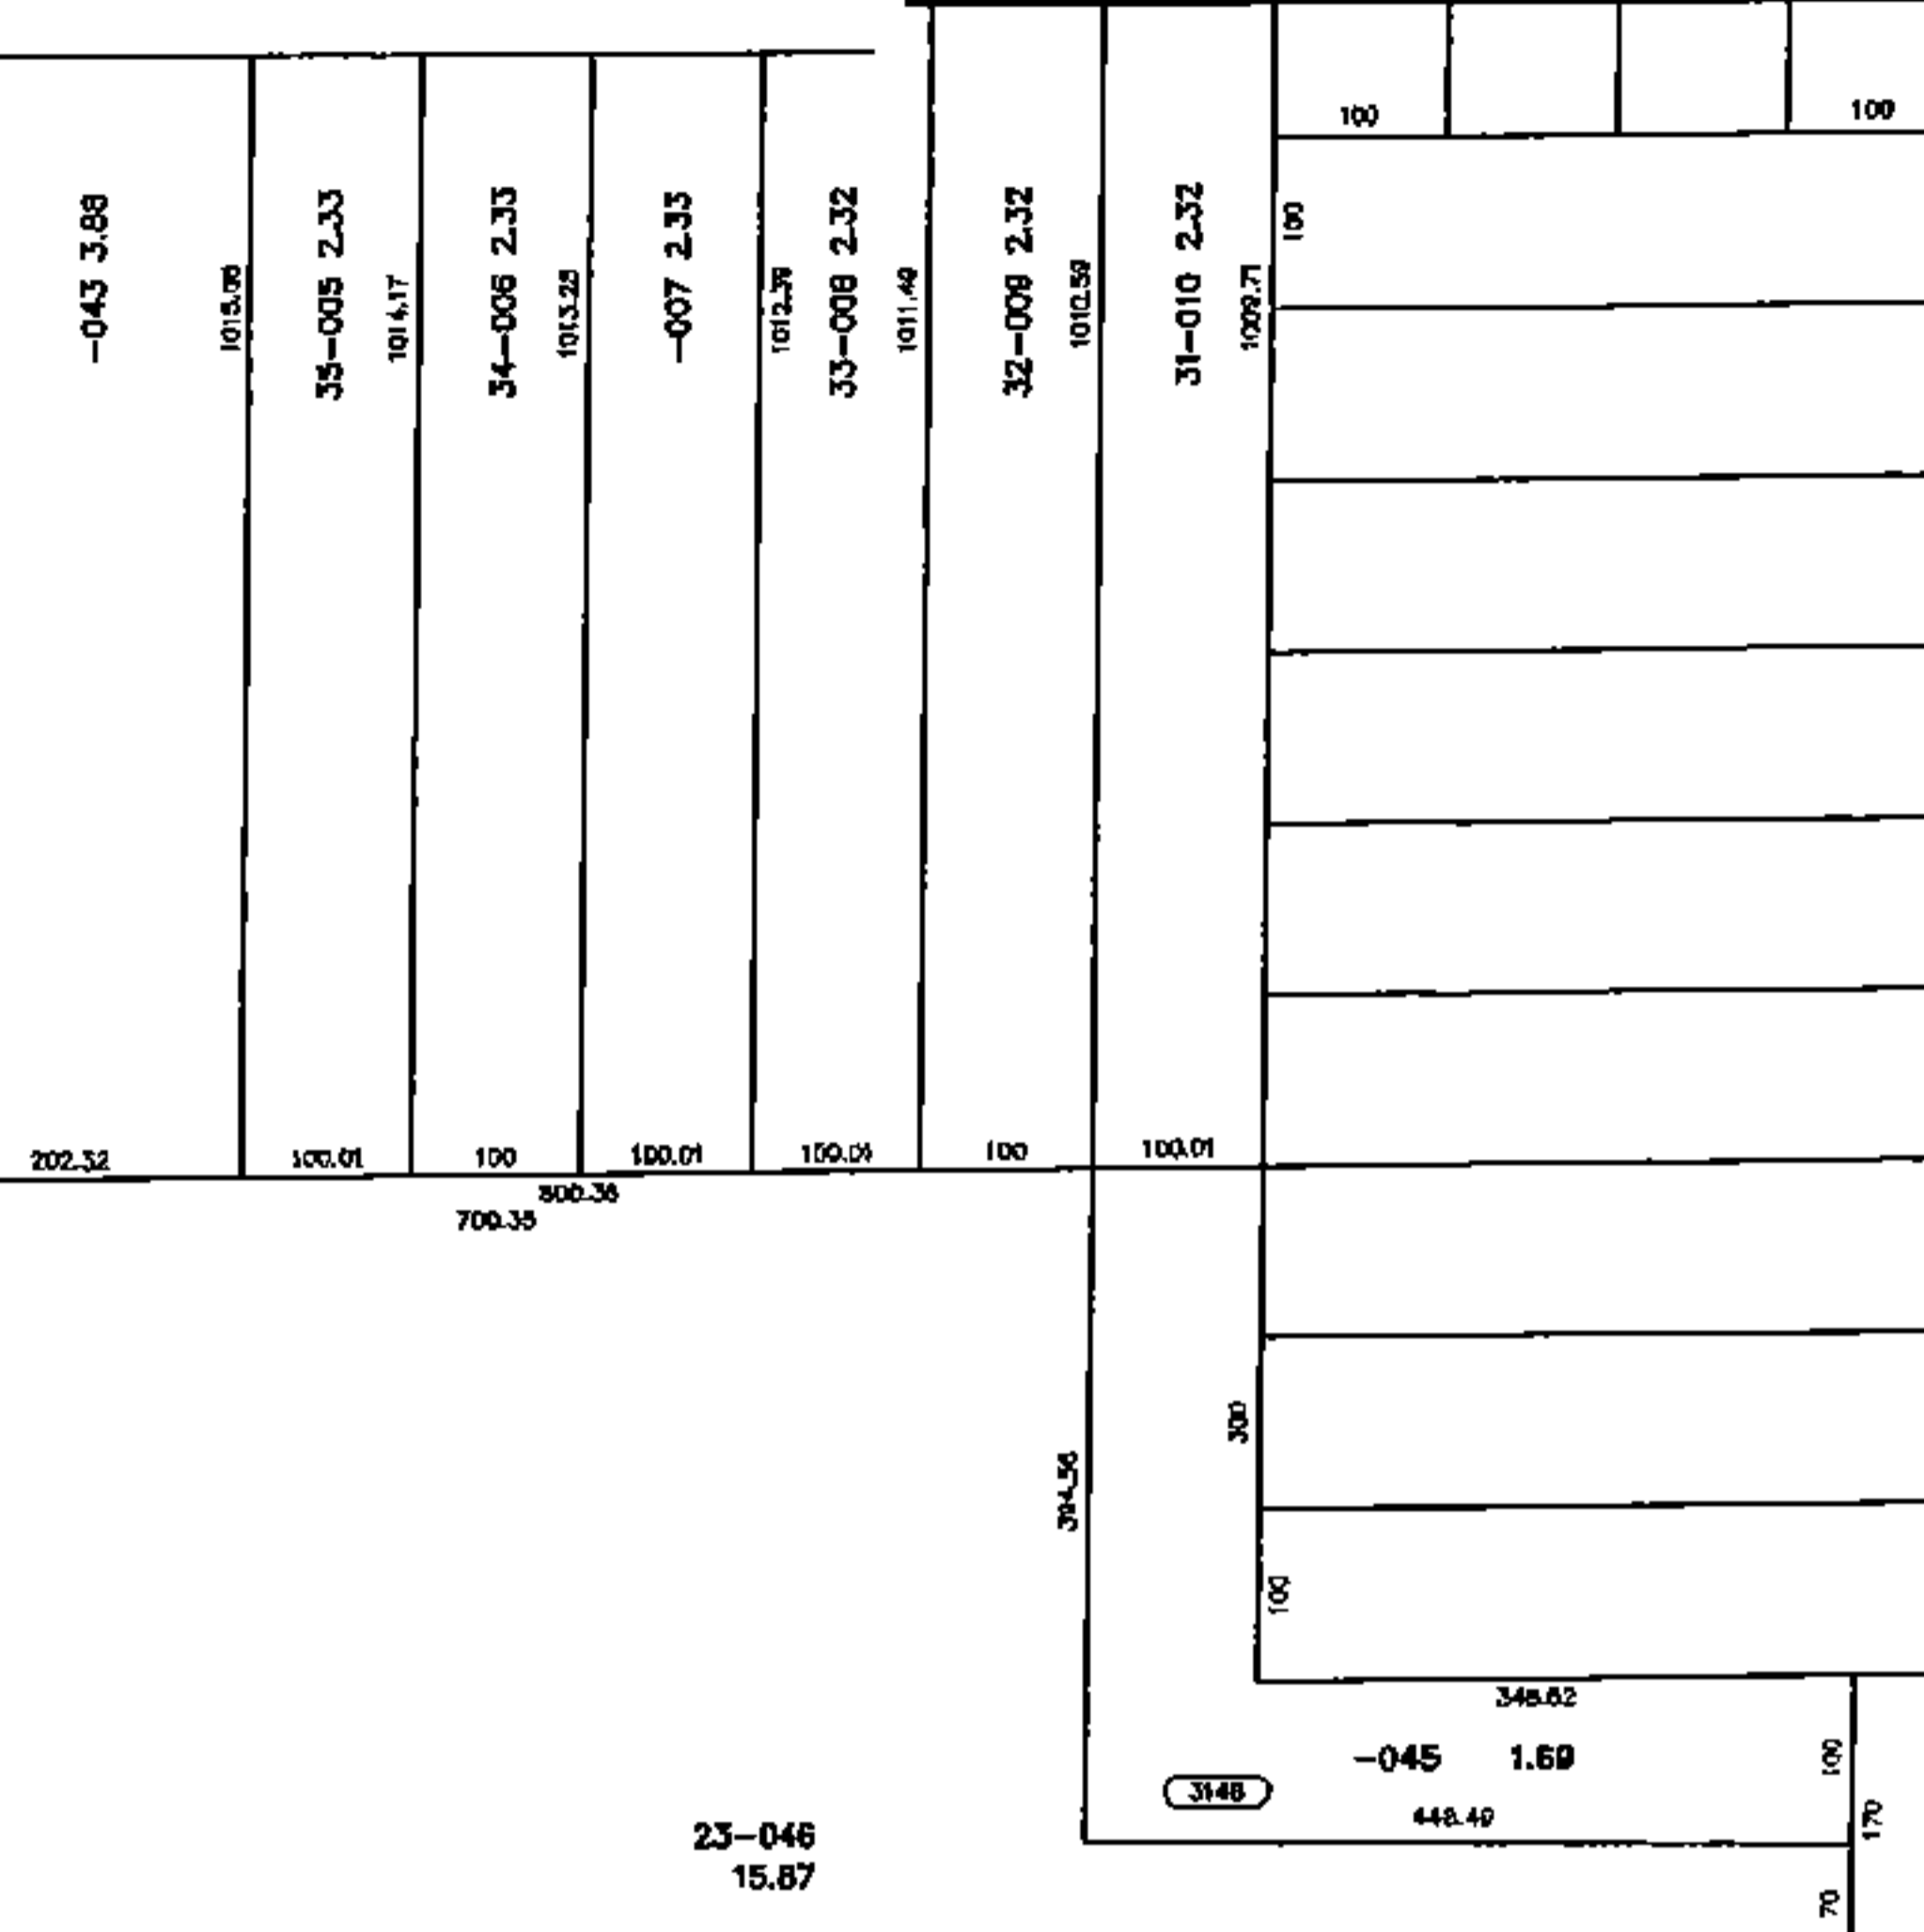

-001
60.46

TA 12/10/15

PER PAUL N.

MAP CORRECTION ONLY

12-00-002-630-001 → -003

API #34093211840


12-00-002-630-002 → -004

API #34093211650

NEEDS MOVED

2013
10 X 10
1103

2008
1106
10 X 10
5/12/15

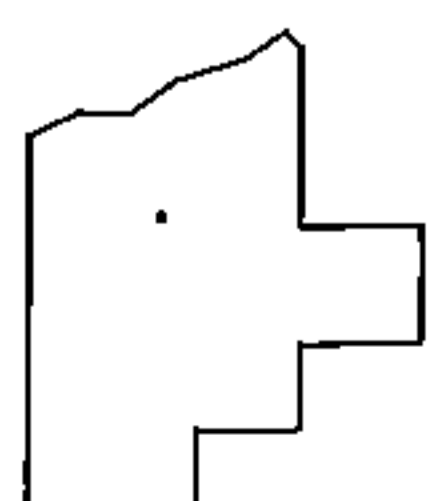

SPLITS/DEEDS PROCESSED

LORAIN COUNTY TAX MAP DEPARTMENT
226 MIDDLE AVE. ELYRIA, OHIO

SURVEYED BY: N/A

CLOSURE: N/A

MAP PAGE(S): 12-00-002-A & B

APPROVED BY: RRM DATE: 5-12-15

SCALE: 1" = 300 PRIOR INST.: _____