
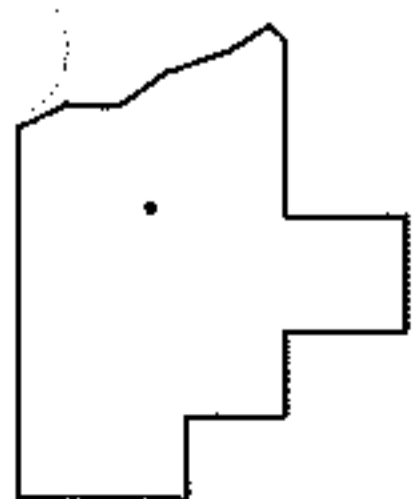
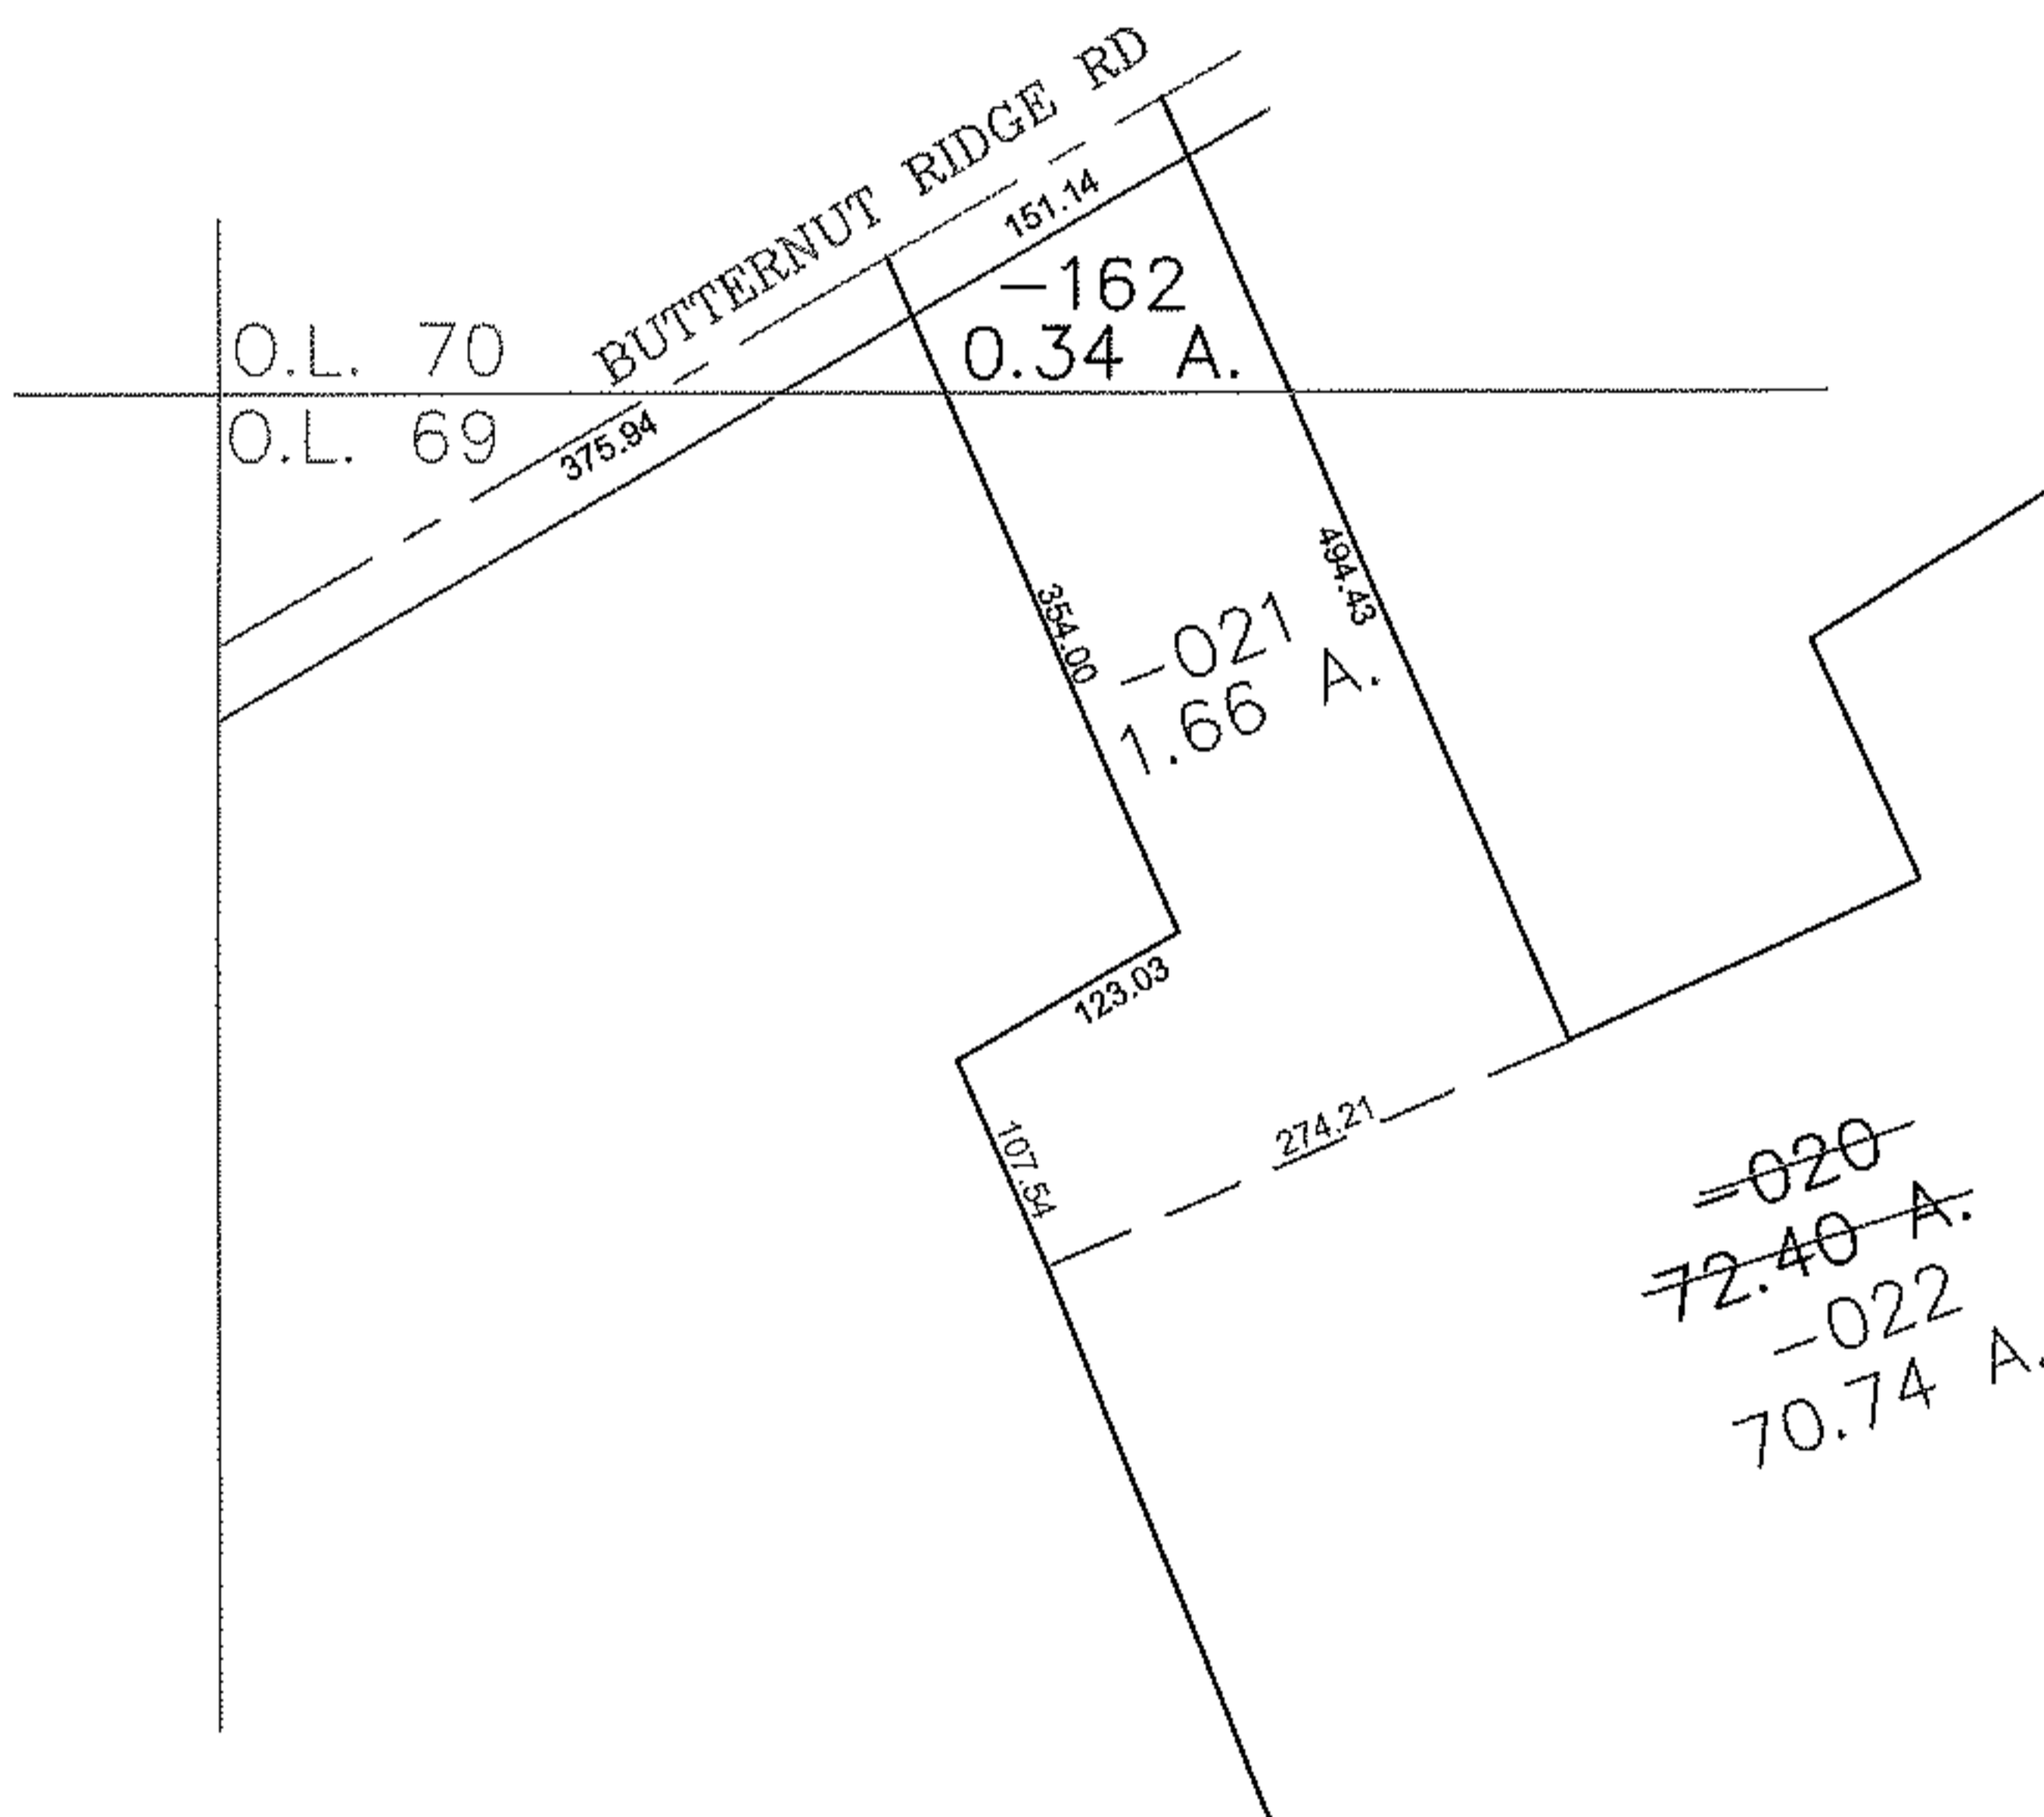


PARENT PARCEL: 11-00-069-000-020, 11-00-070-000-162 (ST)

CHILD PARCEL: 11-00-069-000-021, -022 11-00-070-000-162

STARTING POINT: CENTERLINE OF BUTTERNUT RIDGE RD & O.L. 69

13-03191

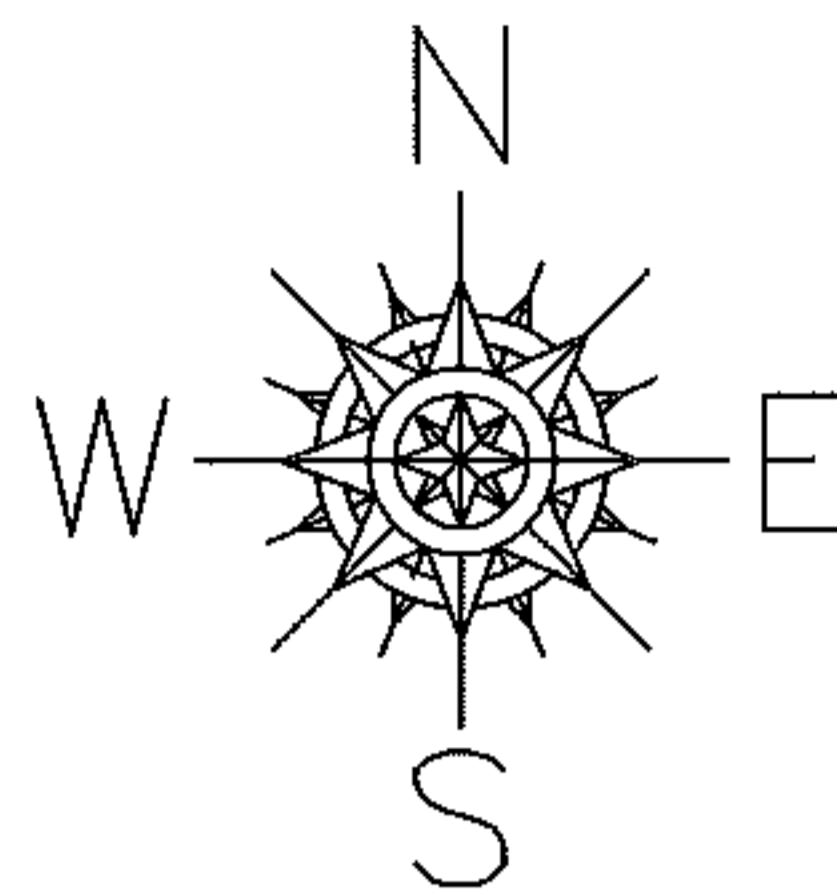

SPLITS/DEEDS PROCESSED
LORAIN COUNTY TAX MAP DEPARTMENT
226 MIDDLE AVE. ELYRIA, OHIO

SURVEYED BY: JAMES ZIEMBA
CLOSURE: 0.00 : 10.000
MAP PAGE(S): 11-B
APPROVED BY: JAH DATE: 10/3/2013
SCALE: 1" = 200 PRIOR INSTRUMENT: 20080256538