


PARENT PARCEL: 12-00-013-000-037

CHILD PARCEL: 12-00-013-630-001

STARTING POINT:


15-03195-A

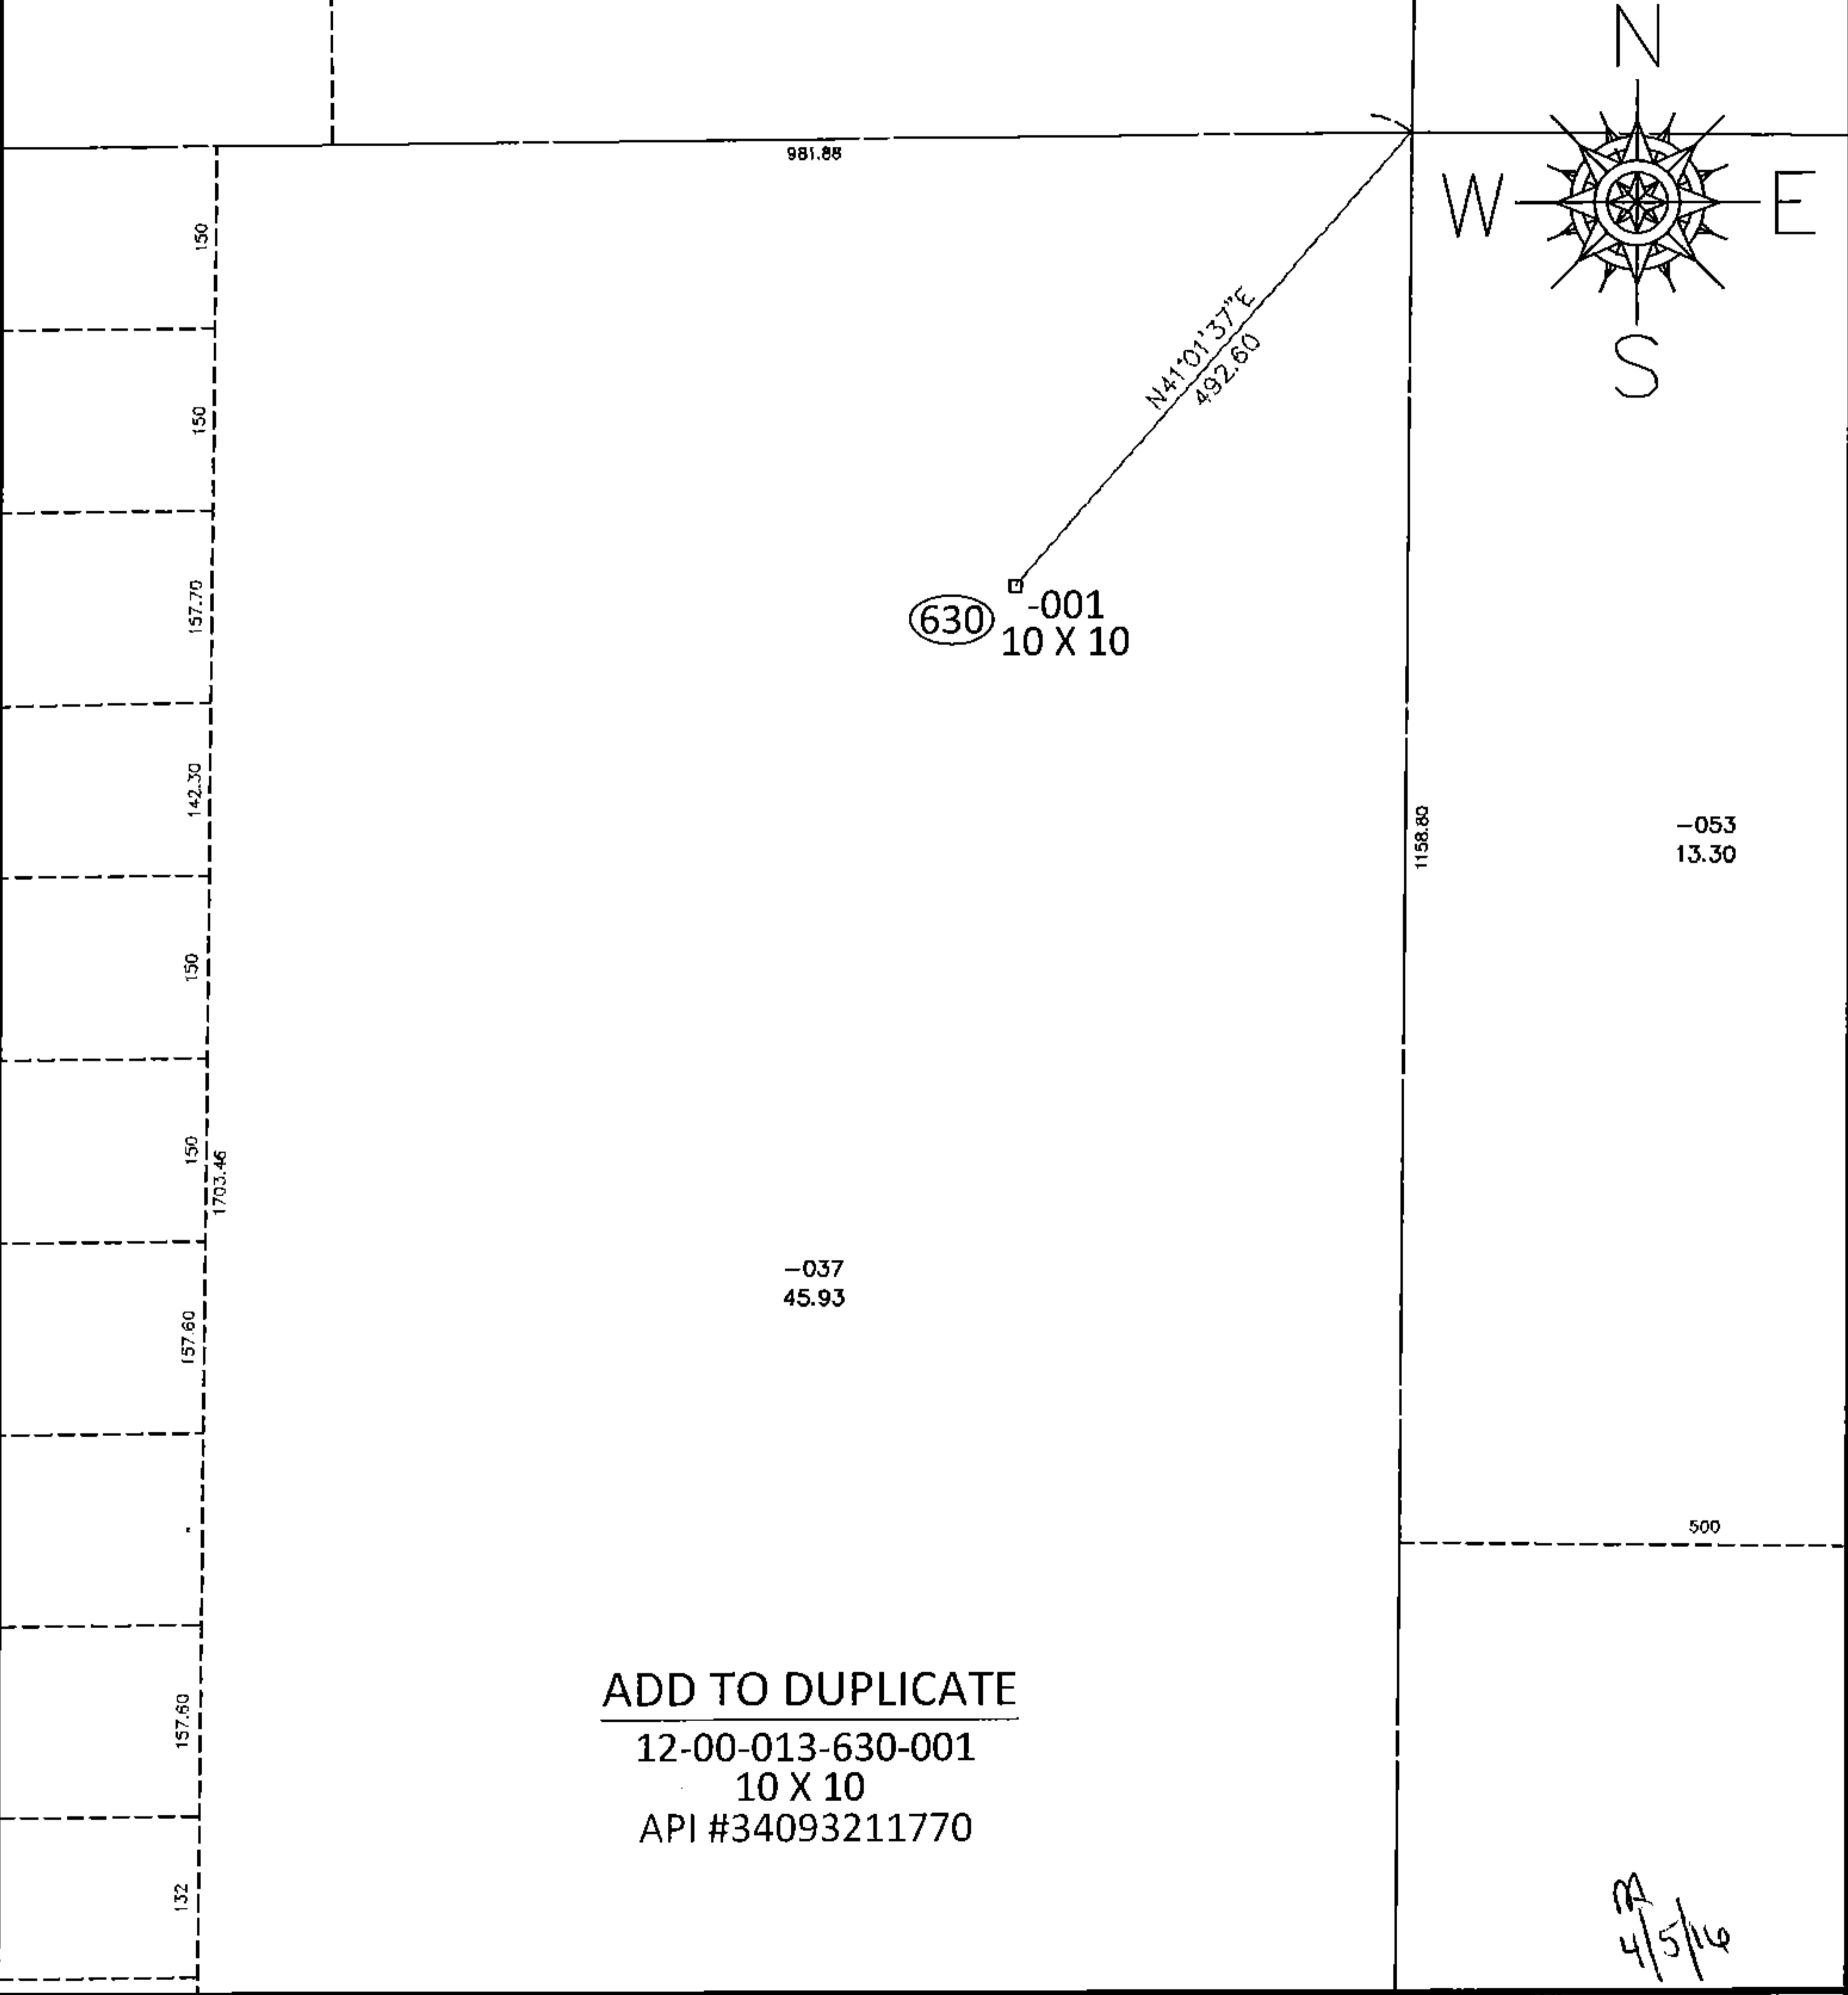

ADD TO DUPLICATE

12-00-013-630-001
10 X 10
API #34093211770

MA
4/5/14

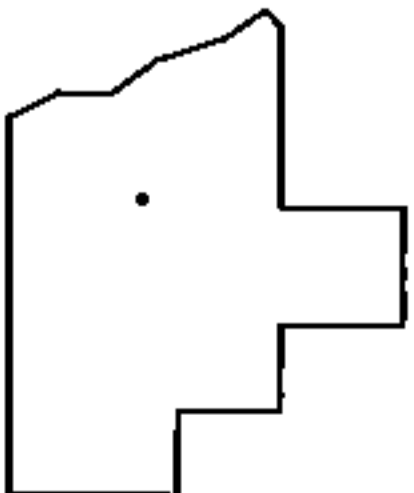

SPLITS/DEEDS PROCESSED

LORAIN COUNTY TAX MAP DEPARTMENT
226 MIDDLE AVE. ELYRIA, OHIO

SURVEYED BY: N/A

CLOSURE: N/A

MAP PAGE(S): 12-00-013-B

APPROVED BY: RRM DATE: 5-12-15

SCALE: 1" = 200 PRIOR INST.: _____