


PARENT PARCEL: 12-00-014-630-001

15-03197-A

CHILD PARCEL:

STARTING POINT:

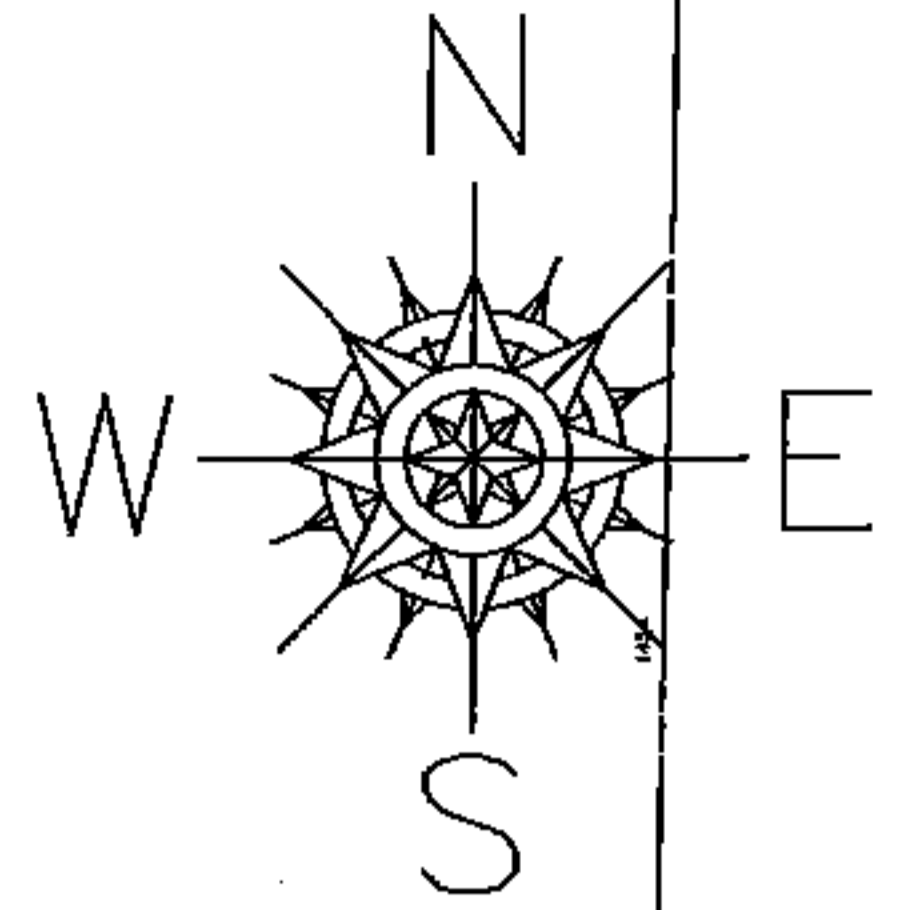

MAP CORRECTION ONLY


12-00-014-630-001

API #34093212190

NEEDS MOVED

002  
=

14

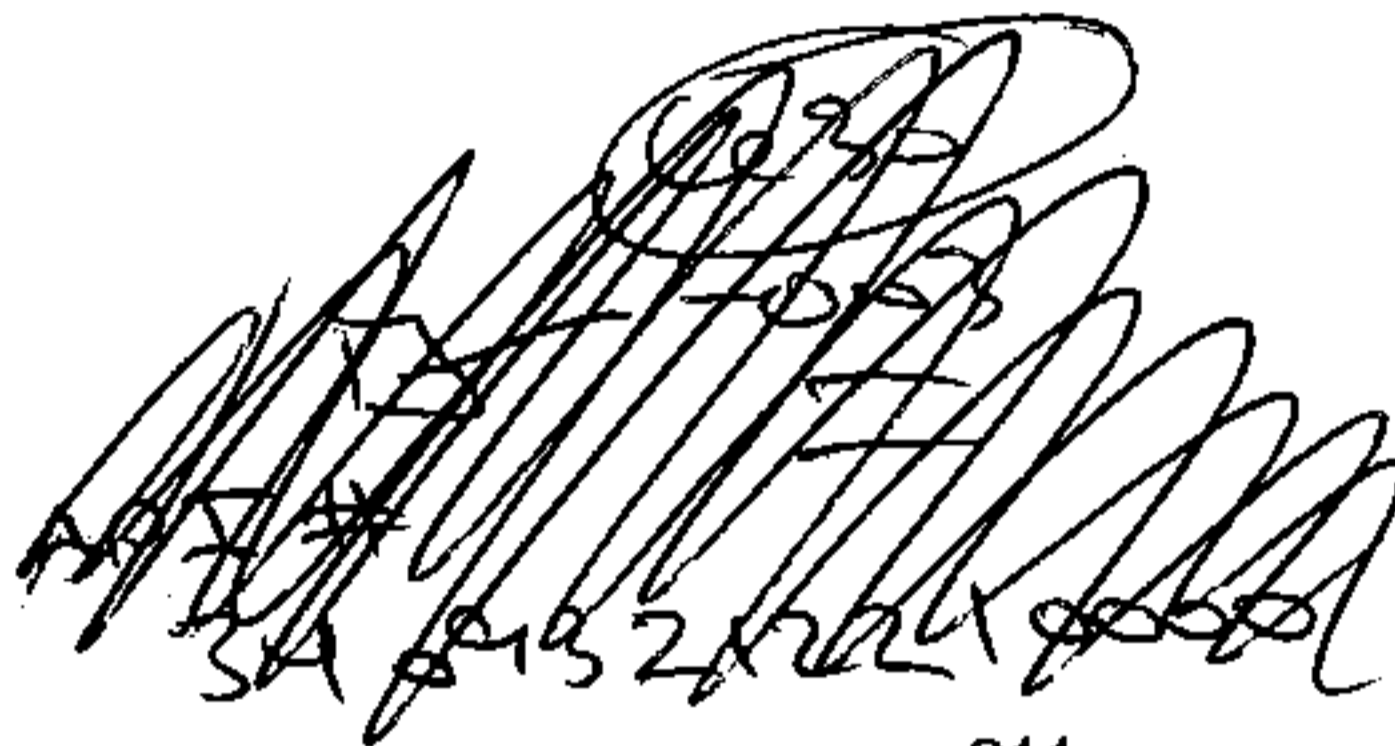

630  
X=001

-011  
69.76

630  
-001  
-002  
=

API #  
34093212190000

TA 12/10/15

DA  
5/13/15

SPLITS/DEEDS PROCESSED

LORAIN COUNTY TAX MAP DEPARTMENT  
226 MIDDLE AVE. ELYRIA, OHIO

SURVEYED BY: N/A

CLOSURE: N/A

MAP PAGE(S): 12-00-014-B

APPROVED BY: RRM DATE: 5-13-15

SCALE: 1" = 400

PRIOR INST.:

