


PARENT PARCEL: 05-00-040-106-101


CHILD PARCEL: 05-00-040-106-127, -128

STARTING POINT: CENTERLINE OF COOPER FOSTER RD & LEAVITT RD

13-03197

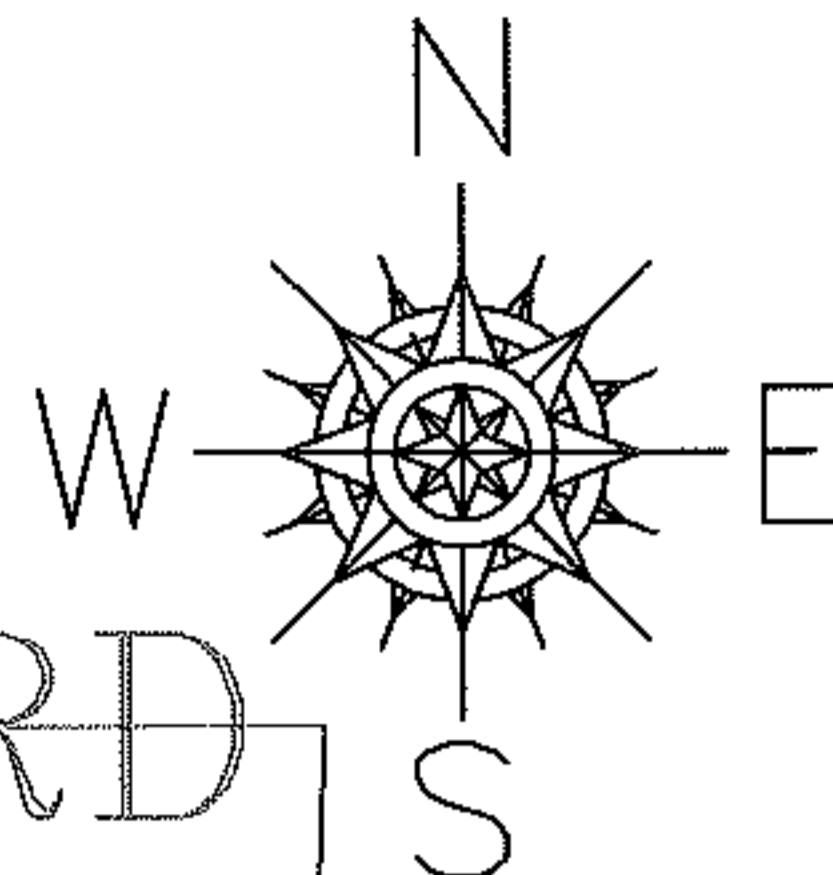

COOPER FOSTER RD

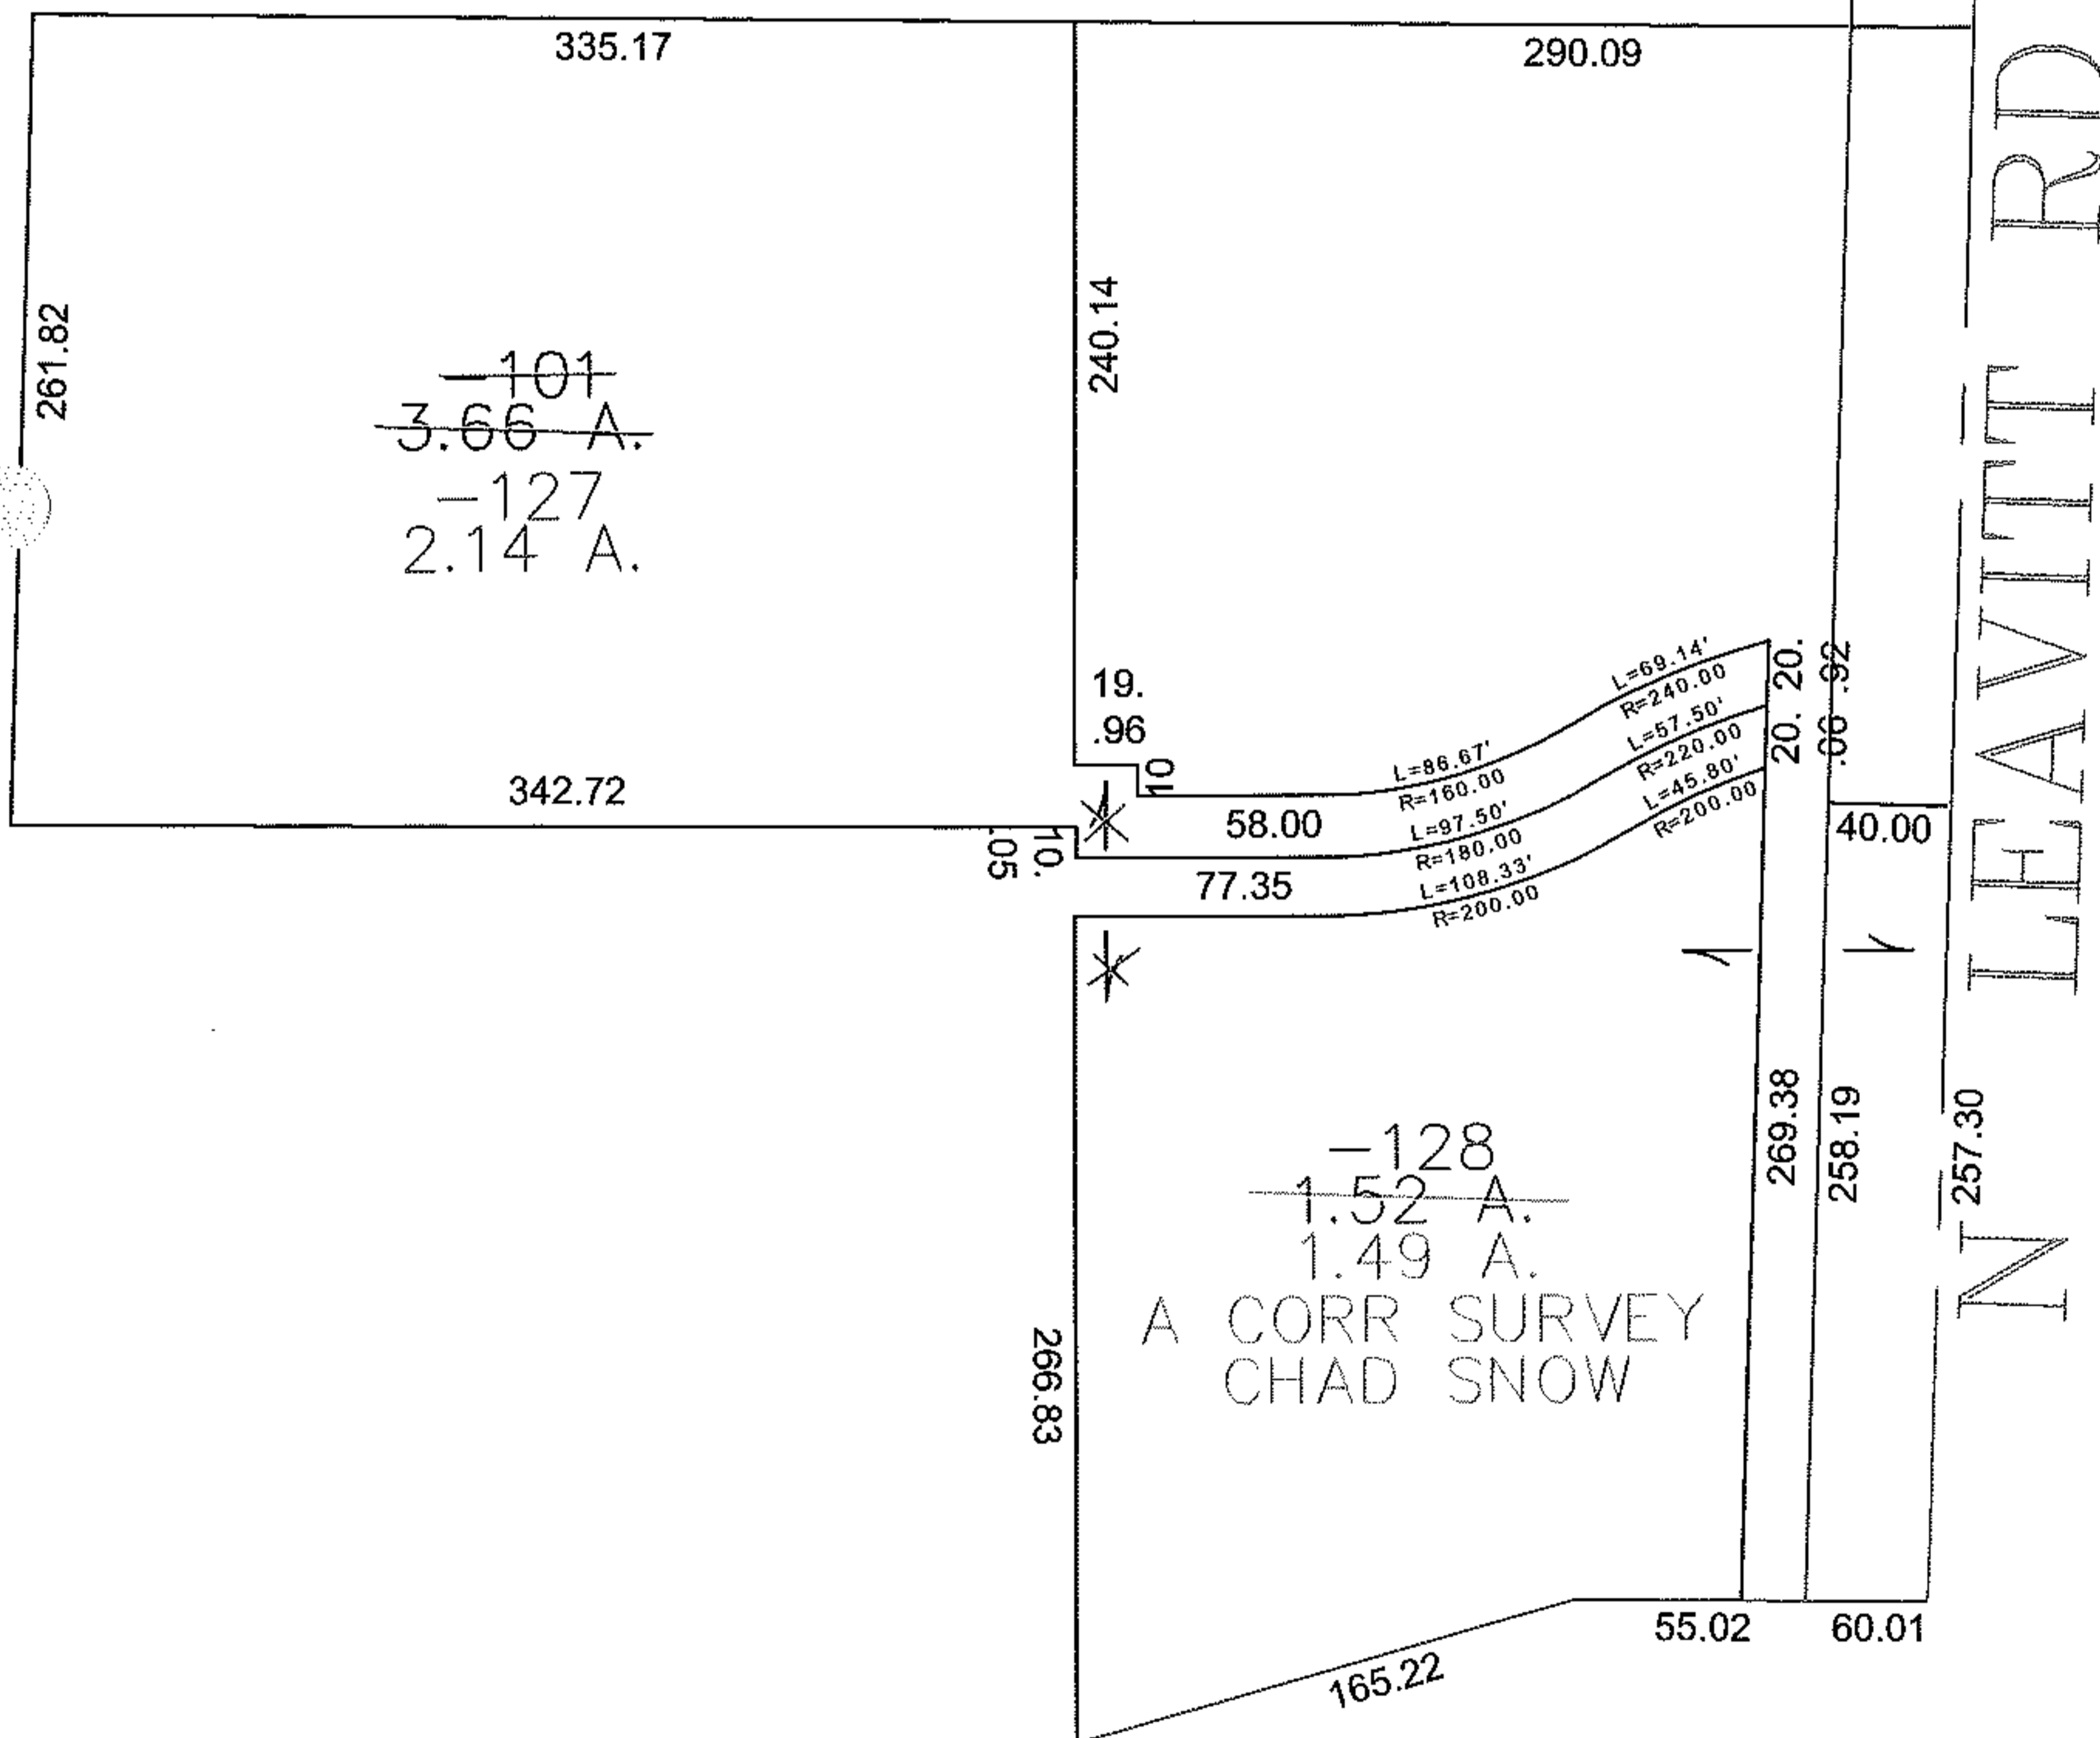

SPLITS/DEEDS PROCESSED

LORAIN COUNTY TAX MAP DEPARTMENT  
226 MIDDLE AVE. ELYRIA, OHIO

SURVEYED BY: CHAD SNOW  
 CLOSURE: 0.00 : 10,000  
 MAP PAGE(S): 05-00-040-B  
 APPROVED BY: JAH DATE: 10/29/2013  
 SCALE: 1" = 100 PRIOR INSTRUMENT: OR 1416/646