
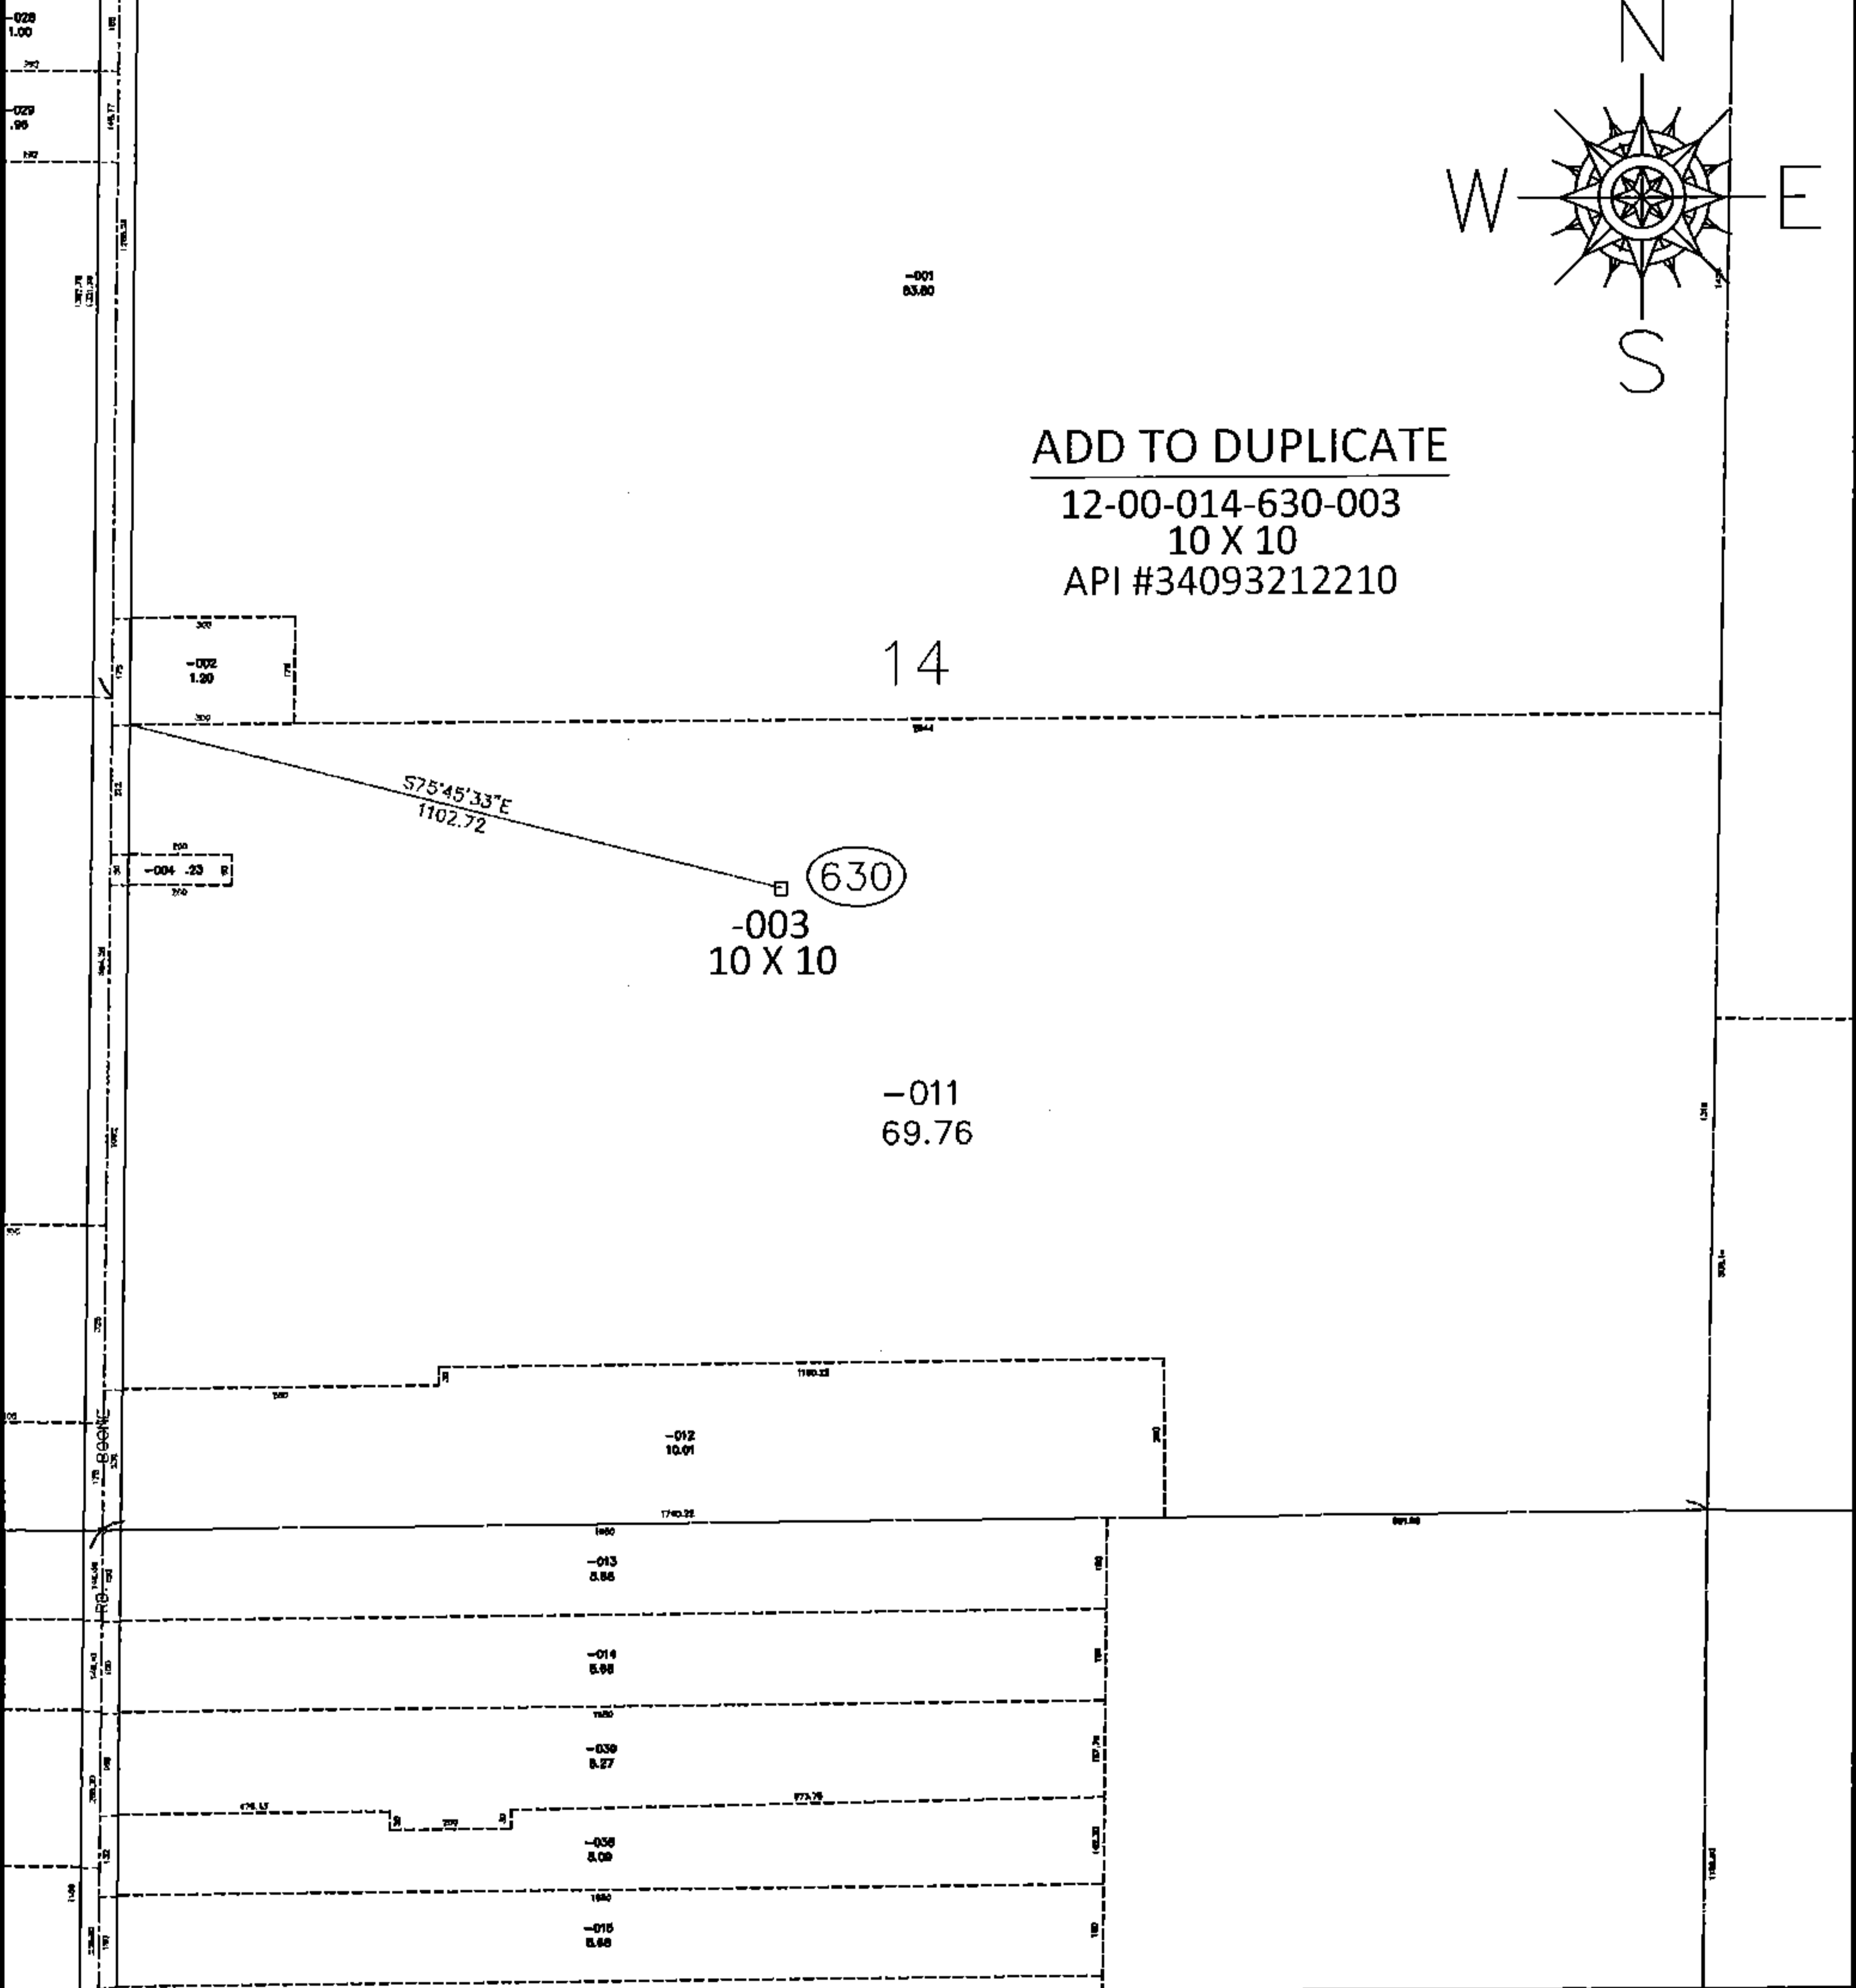


PARENT PARCEL: 12-00-014-000-011

CHILD PARCEL: 12-00-014-630-003

15-03198-A

STARTING POINT:

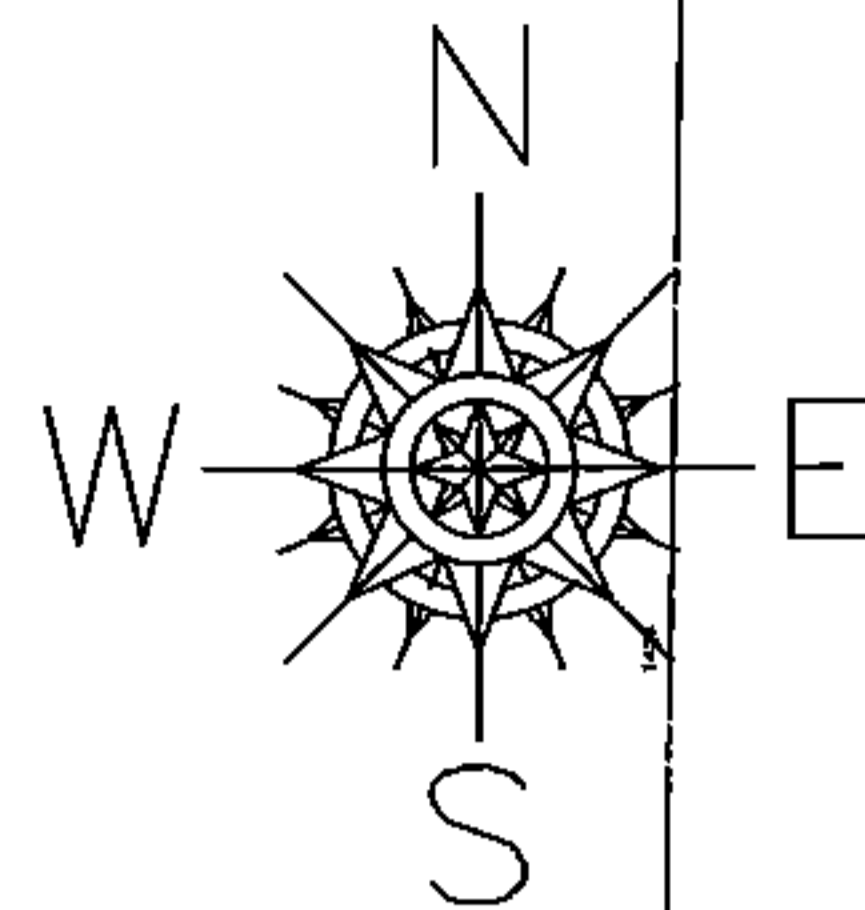

ADD TO DUPLICATE

12-00-014-630-003

10 X 10

API #34093212210

14

630

-003
10 X 10

-011
69.76

-012
10.01


-013
5.88

-014
5.98

-015
5.27

-016
5.09

-017
5.88

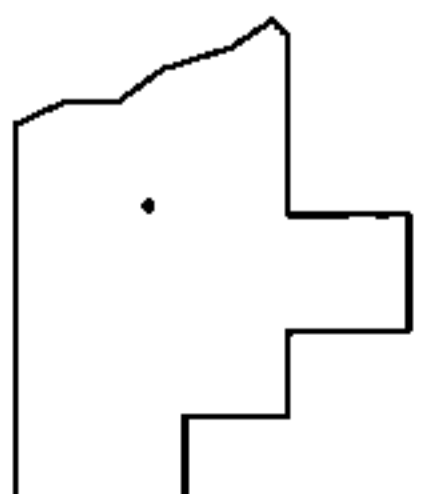

SPLITS/DEEDS PROCESSED

LORAIN COUNTY TAX MAP DEPARTMENT
226 MIDDLE AVE. ELYRIA, OHIO

SURVEYED BY: N/A

CLOSURE: N/A

MAP PAGE(S): 12-00-014-A

APPROVED BY: RRM DATE: 5-13-15

SCALE: 1" = 400

PRIOR INST.: