


PARENT PARCEL: 16-00-041-000-024, -034

CHILD PARCEL: 16-00-041-000-040

STARTING POINT: CENTERLINE OF CHAMBERLAIN RD & O.L. 41

13-03198

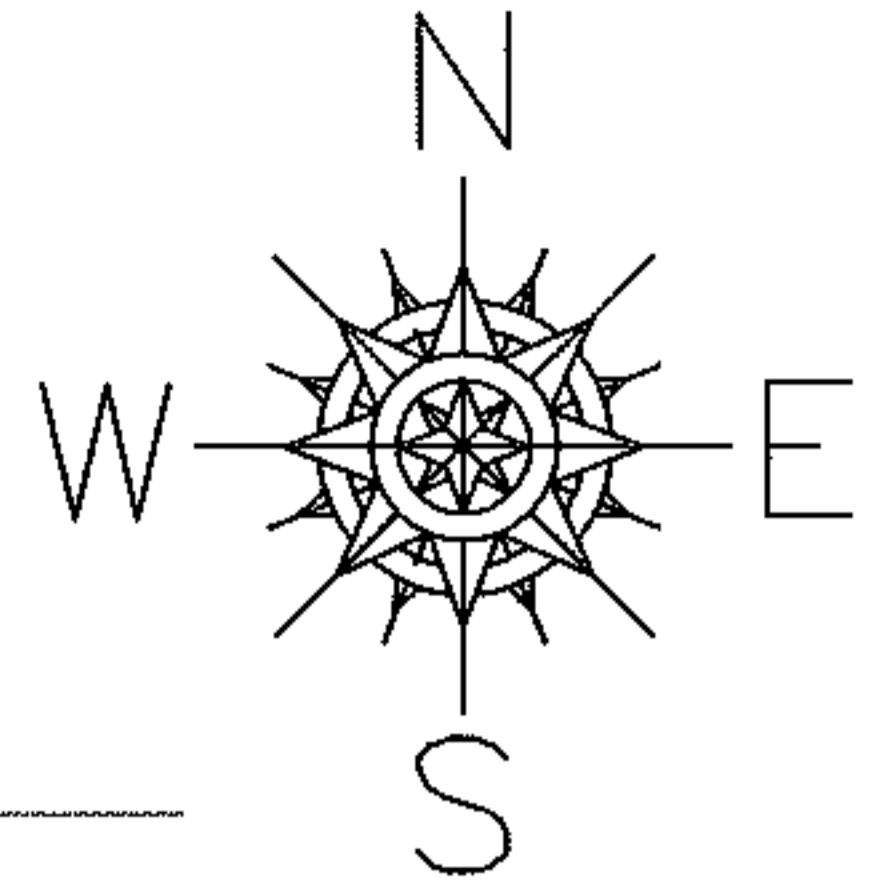

CHAMBERLAIN RD

200.00

O.L. 39

O.L. 41

217.00

217.00

~~-024~~  
~~1.00 A.~~

~~-040~~  
~~1.96 A.~~  
1.95 A.

400.00

351.00

A CORR SURVEY  
RICHARD CARLSON

~~-034~~  
~~0.96 A.~~

35.05

47.86

182.00

SPLITS/DEEDS PROCESSED

LORAIN COUNTY TAX MAP DEPARTMENT  
226 MIDDLE AVE. ELYRIA, OHIO

SURVEYED BY: RICHARD CARLSON

CLOSURE: 0.00 : 10.000

MAP PAGE(S): 16-A

APPROVED BY: JAH DATE: 10/30/2013

SCALE: 1" = 100 PRIOR INSTRUMENT: OR 444/207