
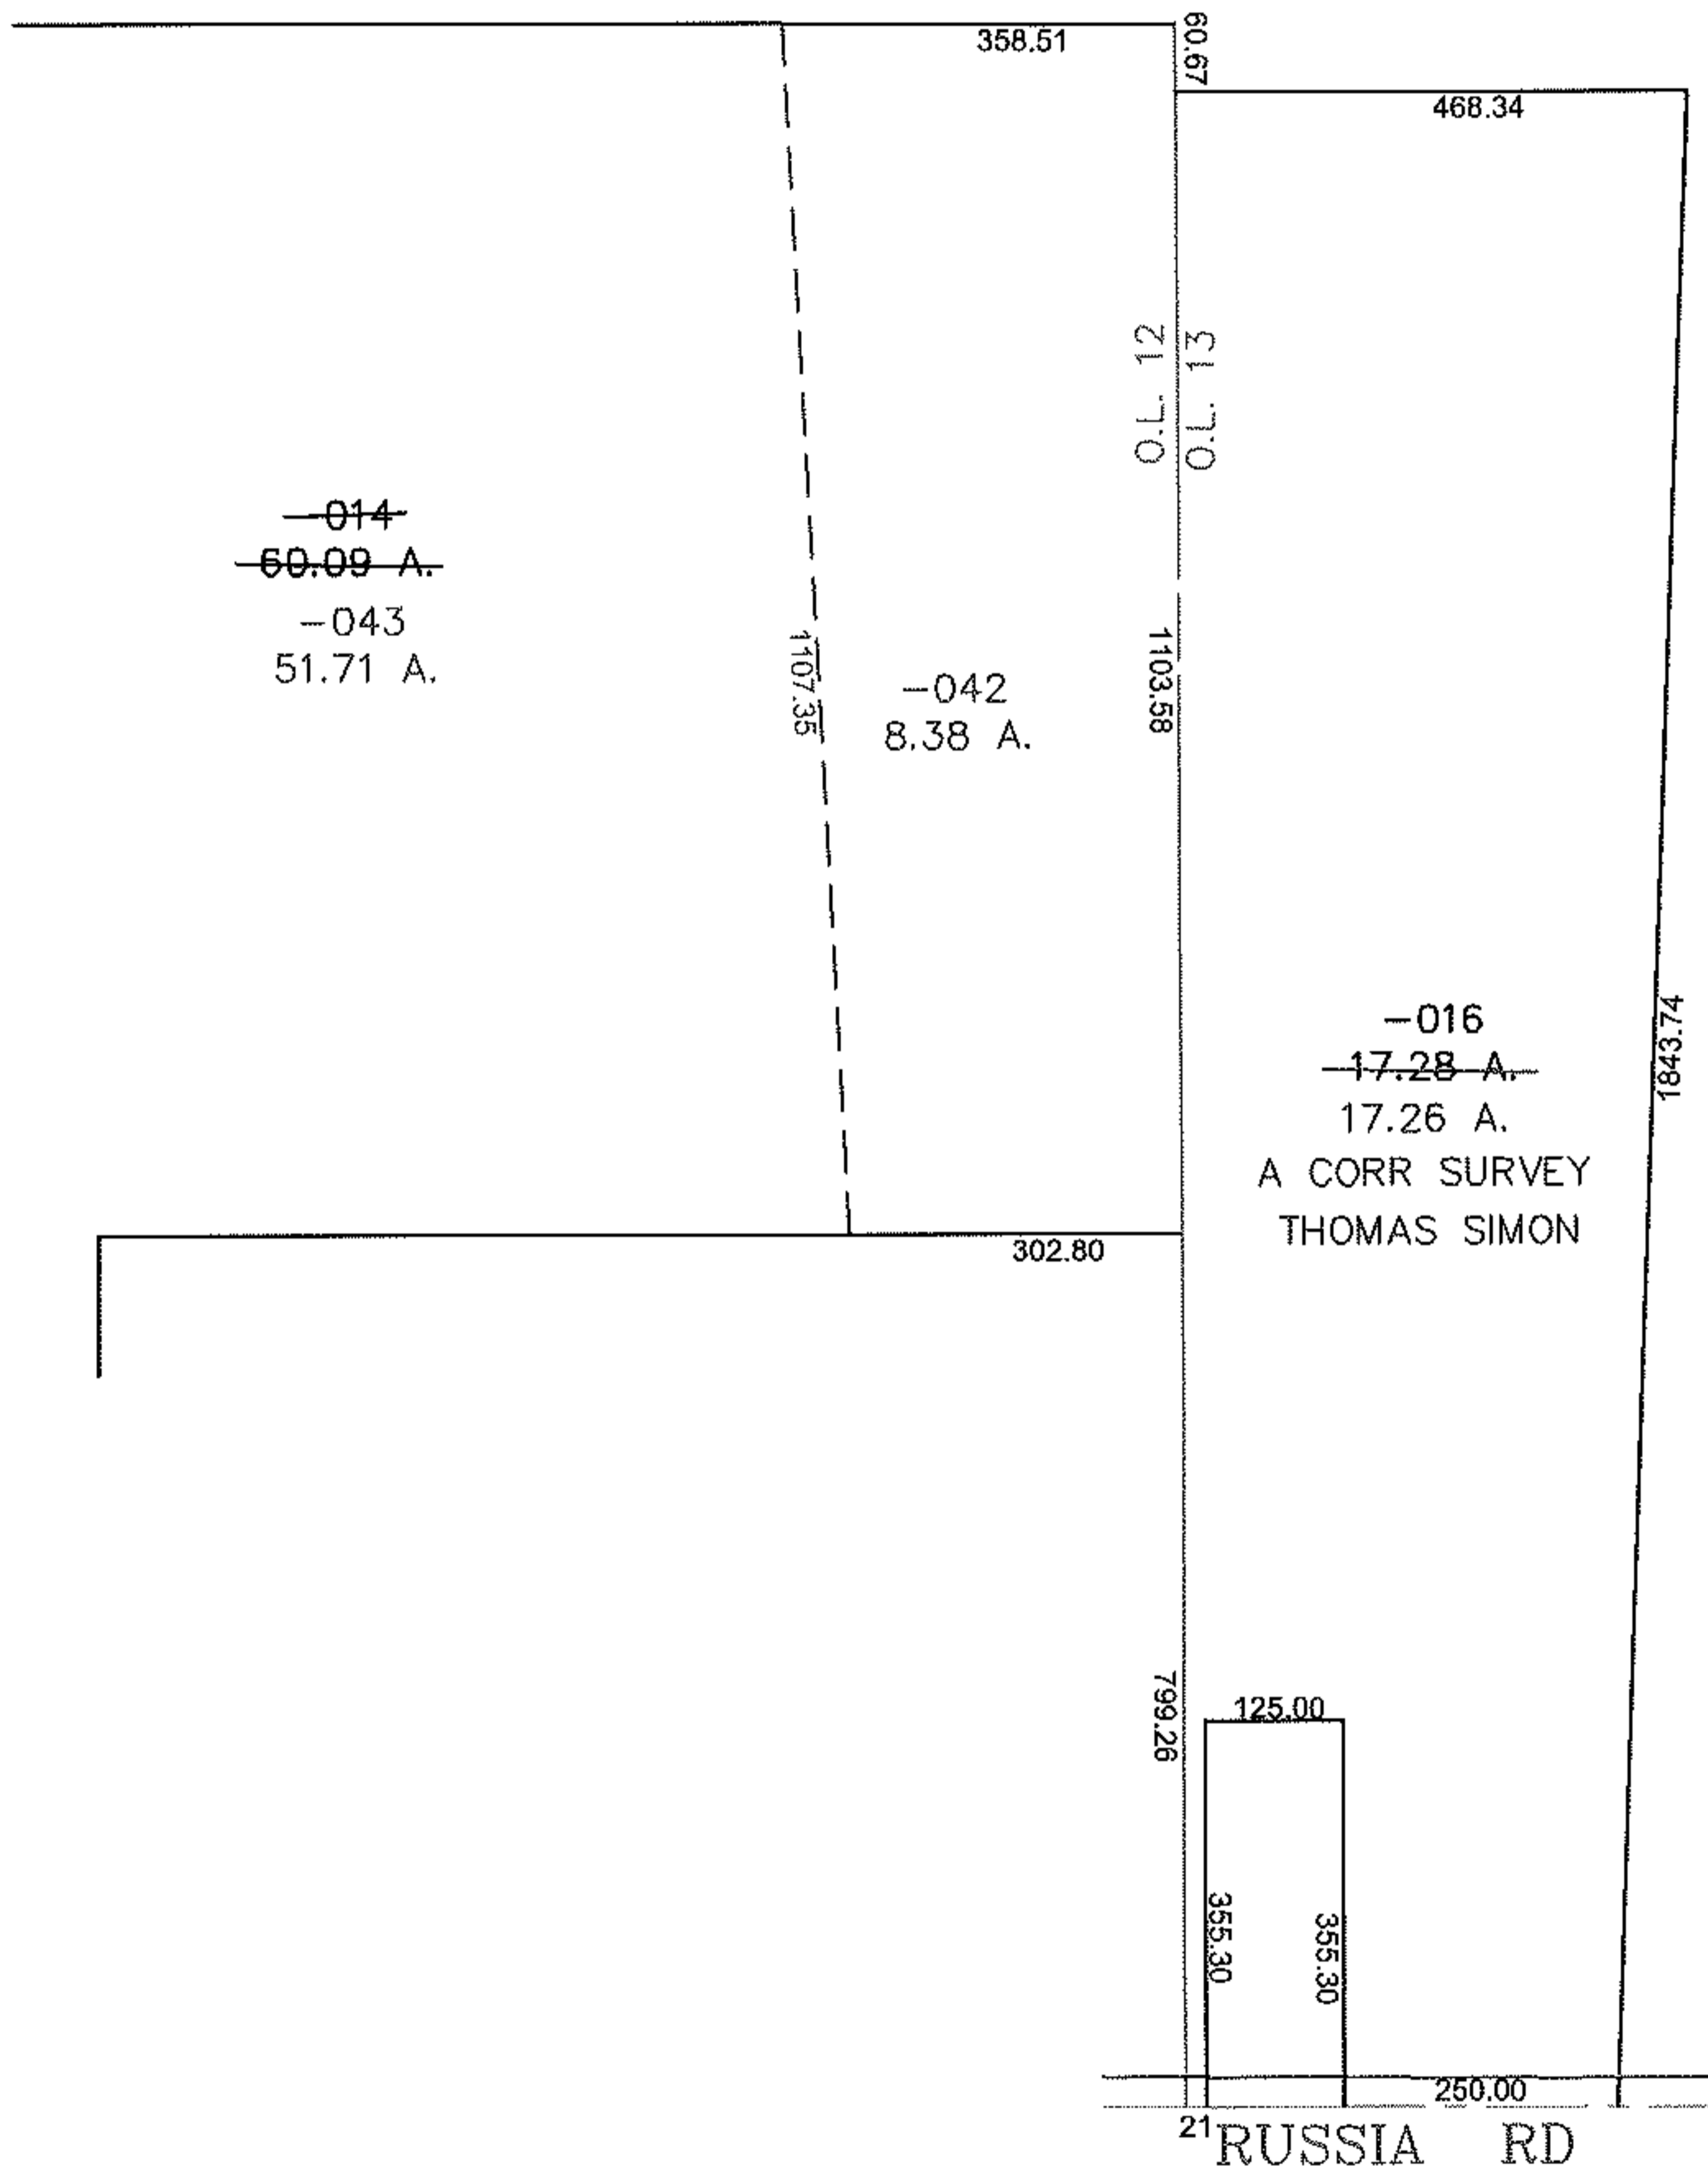


PARENT PARCEL: 09-00-012-000-014, 09-00-013-101-016

CHILD PARCEL: 09-00-012-000-042, -043

STARTING POINT: CENTERLINE OF RUSSIA RD & O.L. 12

13-03199

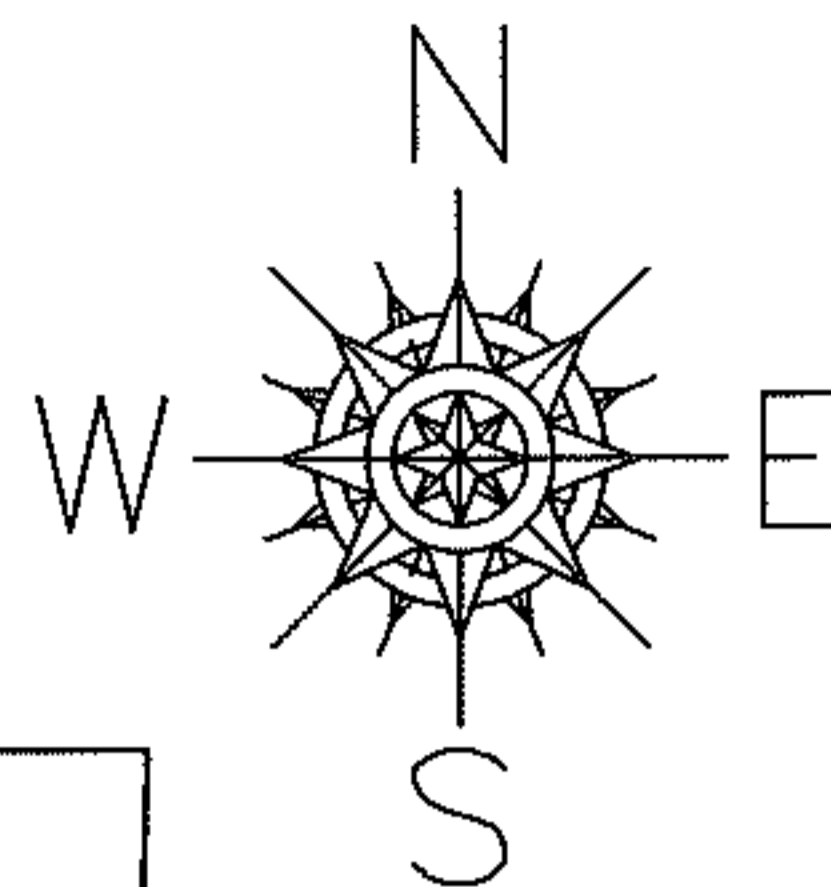

SPLITS/DEEDS PROCESSED

LORAIN COUNTY TAX MAP DEPARTMENT
226 MIDDLE AVE. ELYRIA, OHIO

SURVEYED BY: THOMAS SIMON

CLOSURE: 0.00 : 10,000

MAP PAGE(S): 09-00-012-A

APPROVED BY: JAH DATE: 10-30-2013

SCALE: 1" = 300 PRIOR INSTRUMENT: 19980581635