
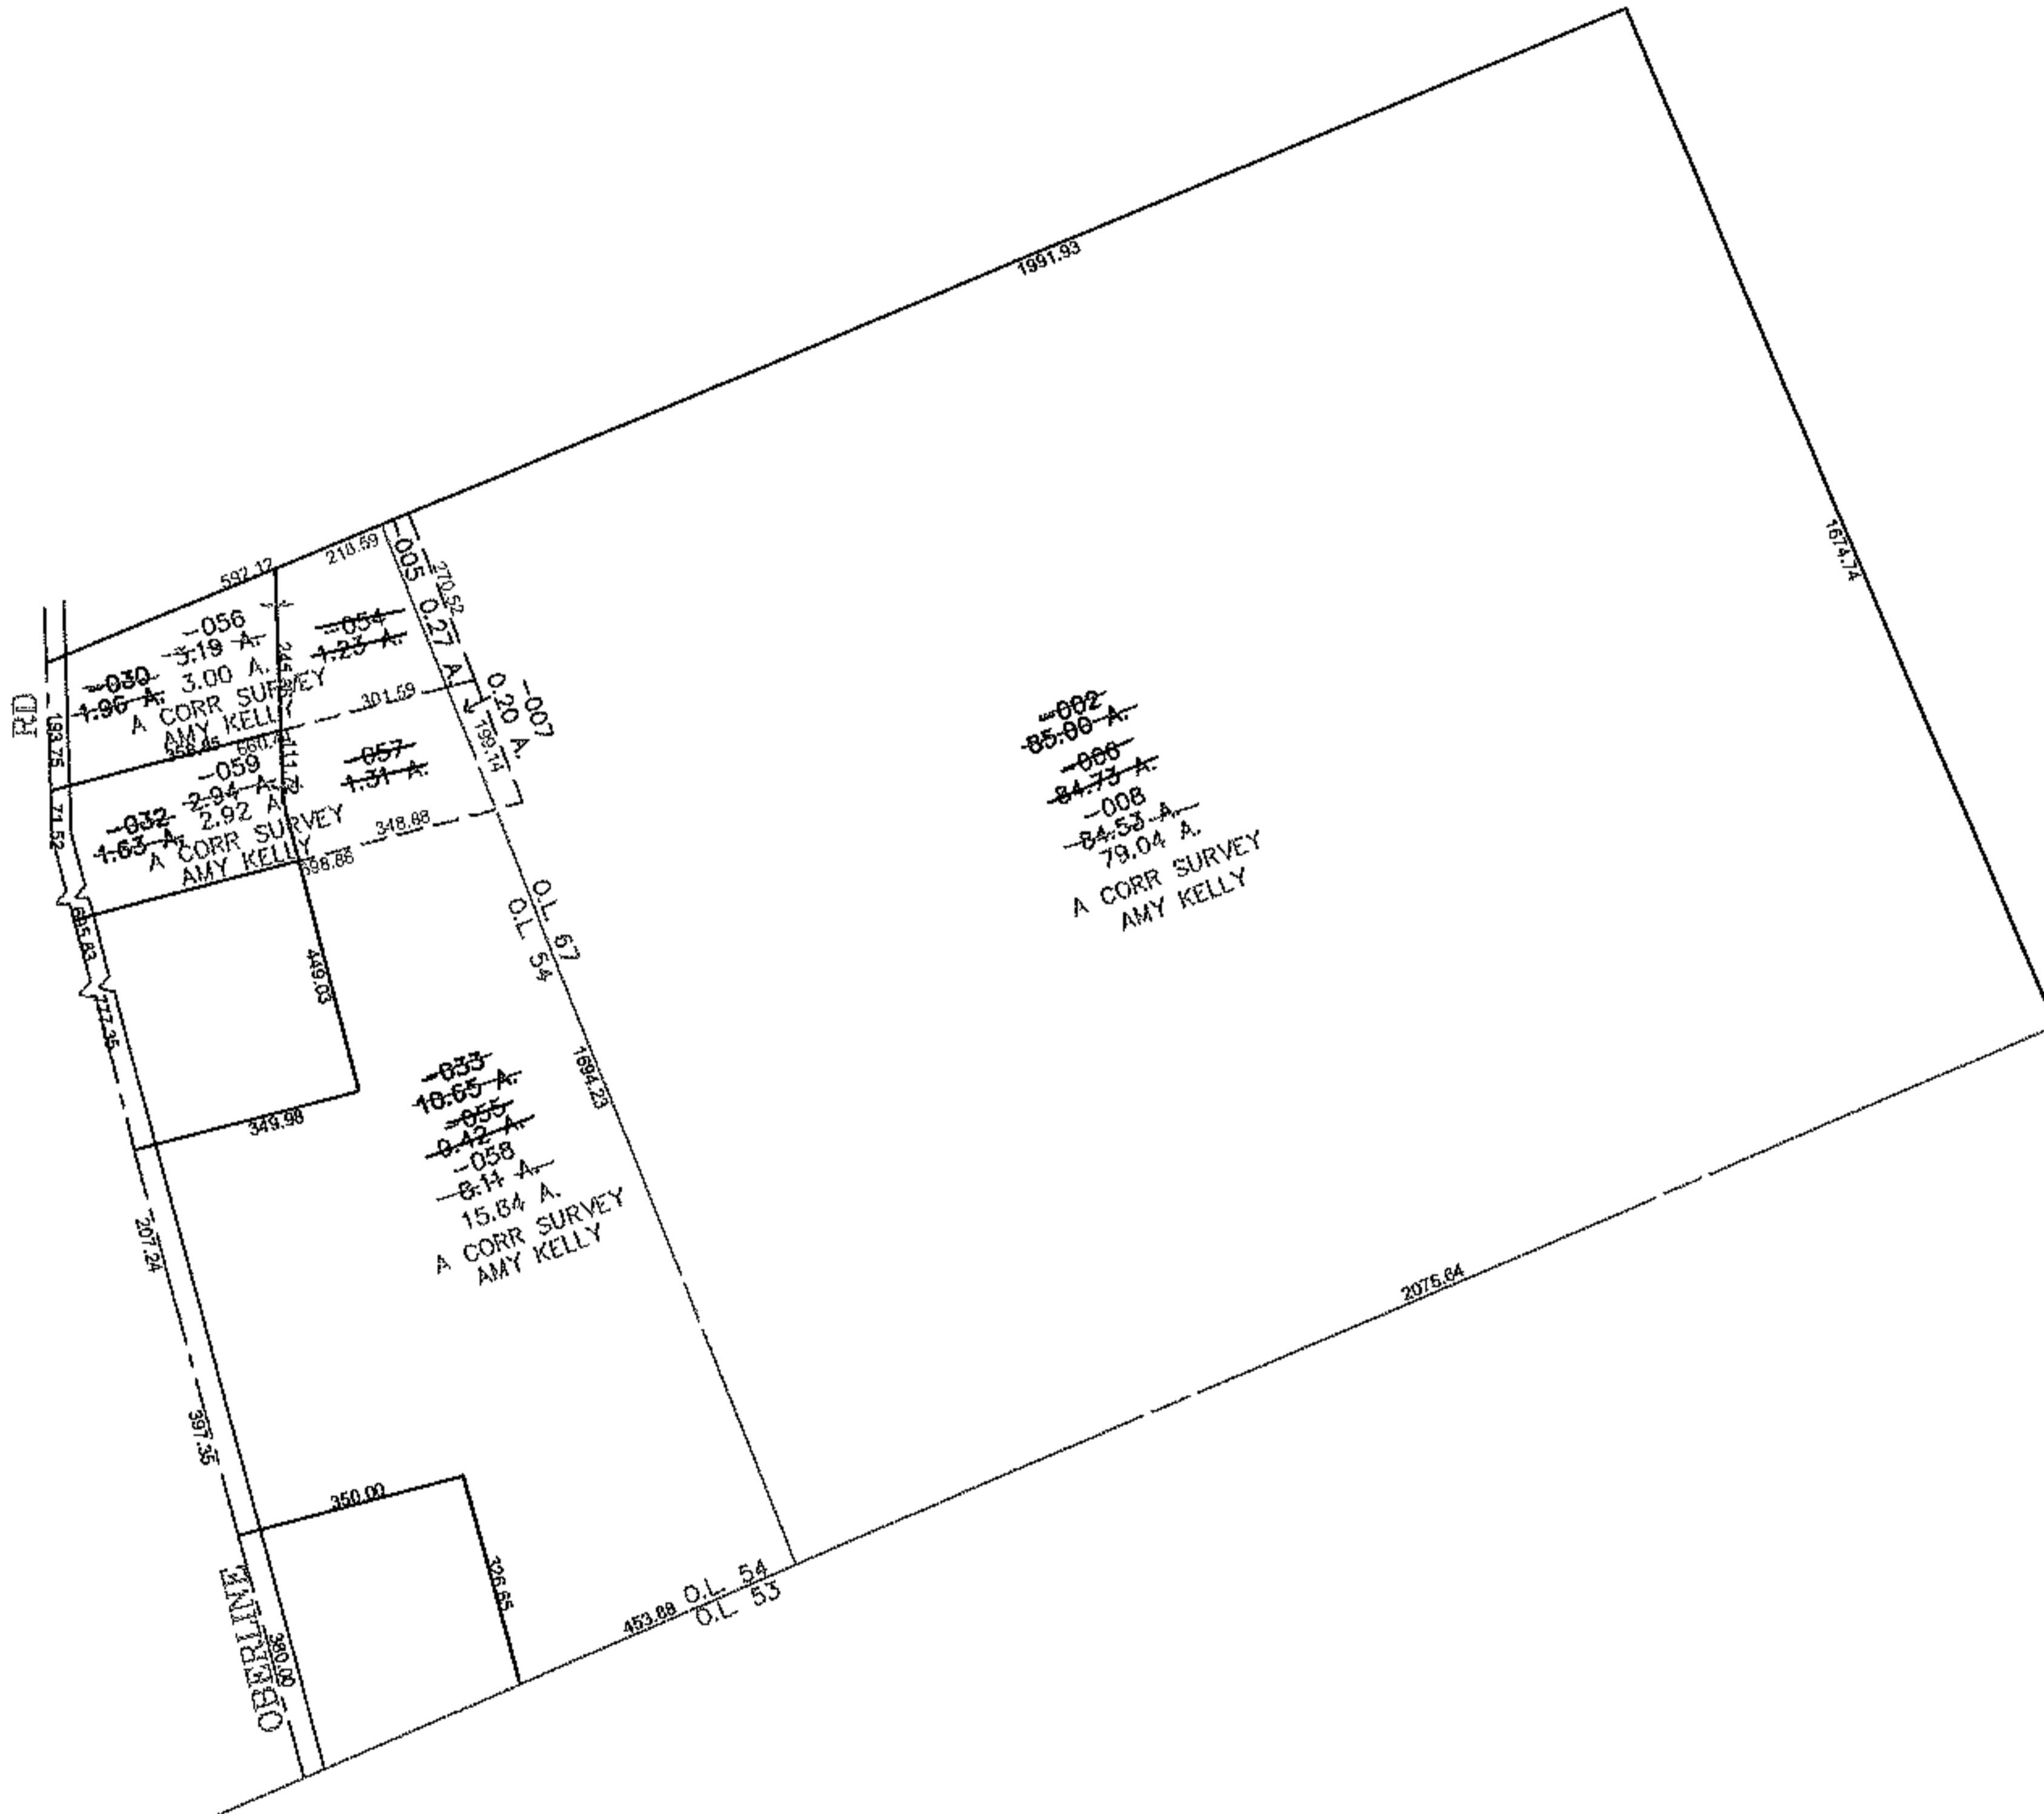


PARENT PARCEL: 05-00-054-000-033, 05-00-067-000-002

CHILD PARCEL: 05-00-054-000-054 THRU -058 05-00-067-000-005 THRU -008

STARTING POINT: CENTERLINE OF OBERLIN RD & O.L. 54

13-03200

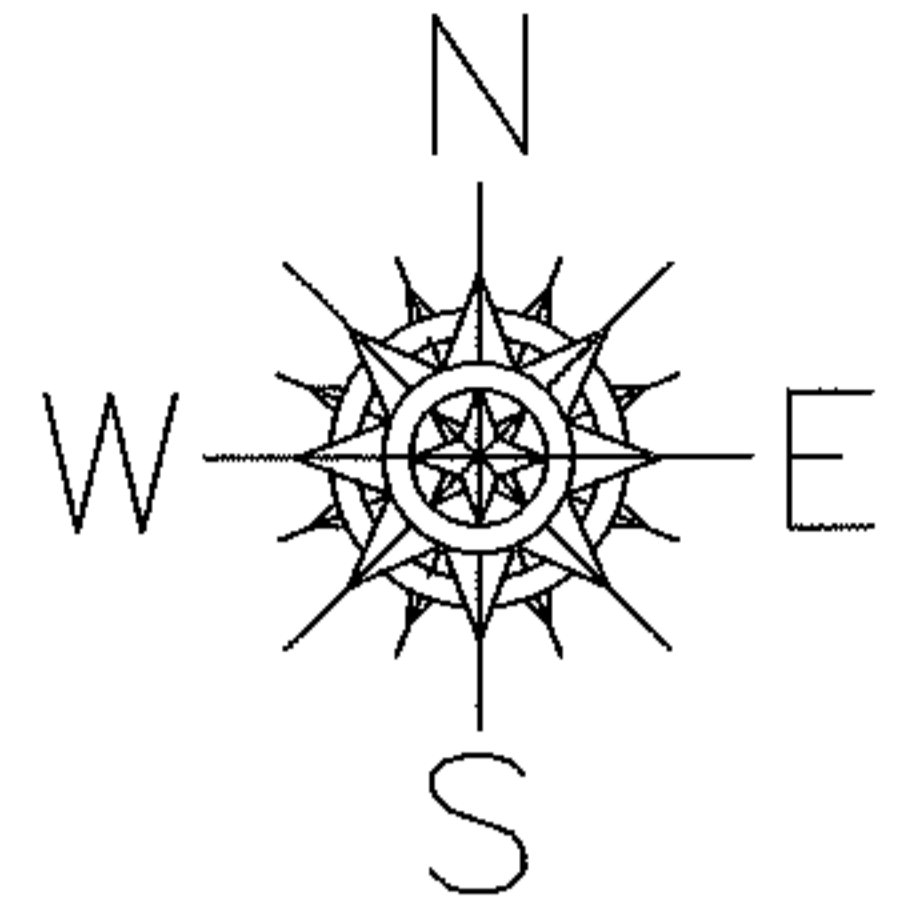

**SPLITS/DEEDS PROCESSED**

LORAIN COUNTY TAX MAP DEPARTMENT  
226 MIDDLE AVE. ELYRIA, OHIO

SURVEYED BY: AMY KELLY

CLOSURE: 0.00 : 10,000

MAP PAGE(S): 5-G

APPROVED BY: JAH DATE: 11/4/2013

SCALE: 1" = 500 PRIOR INST.: 20040032328

