
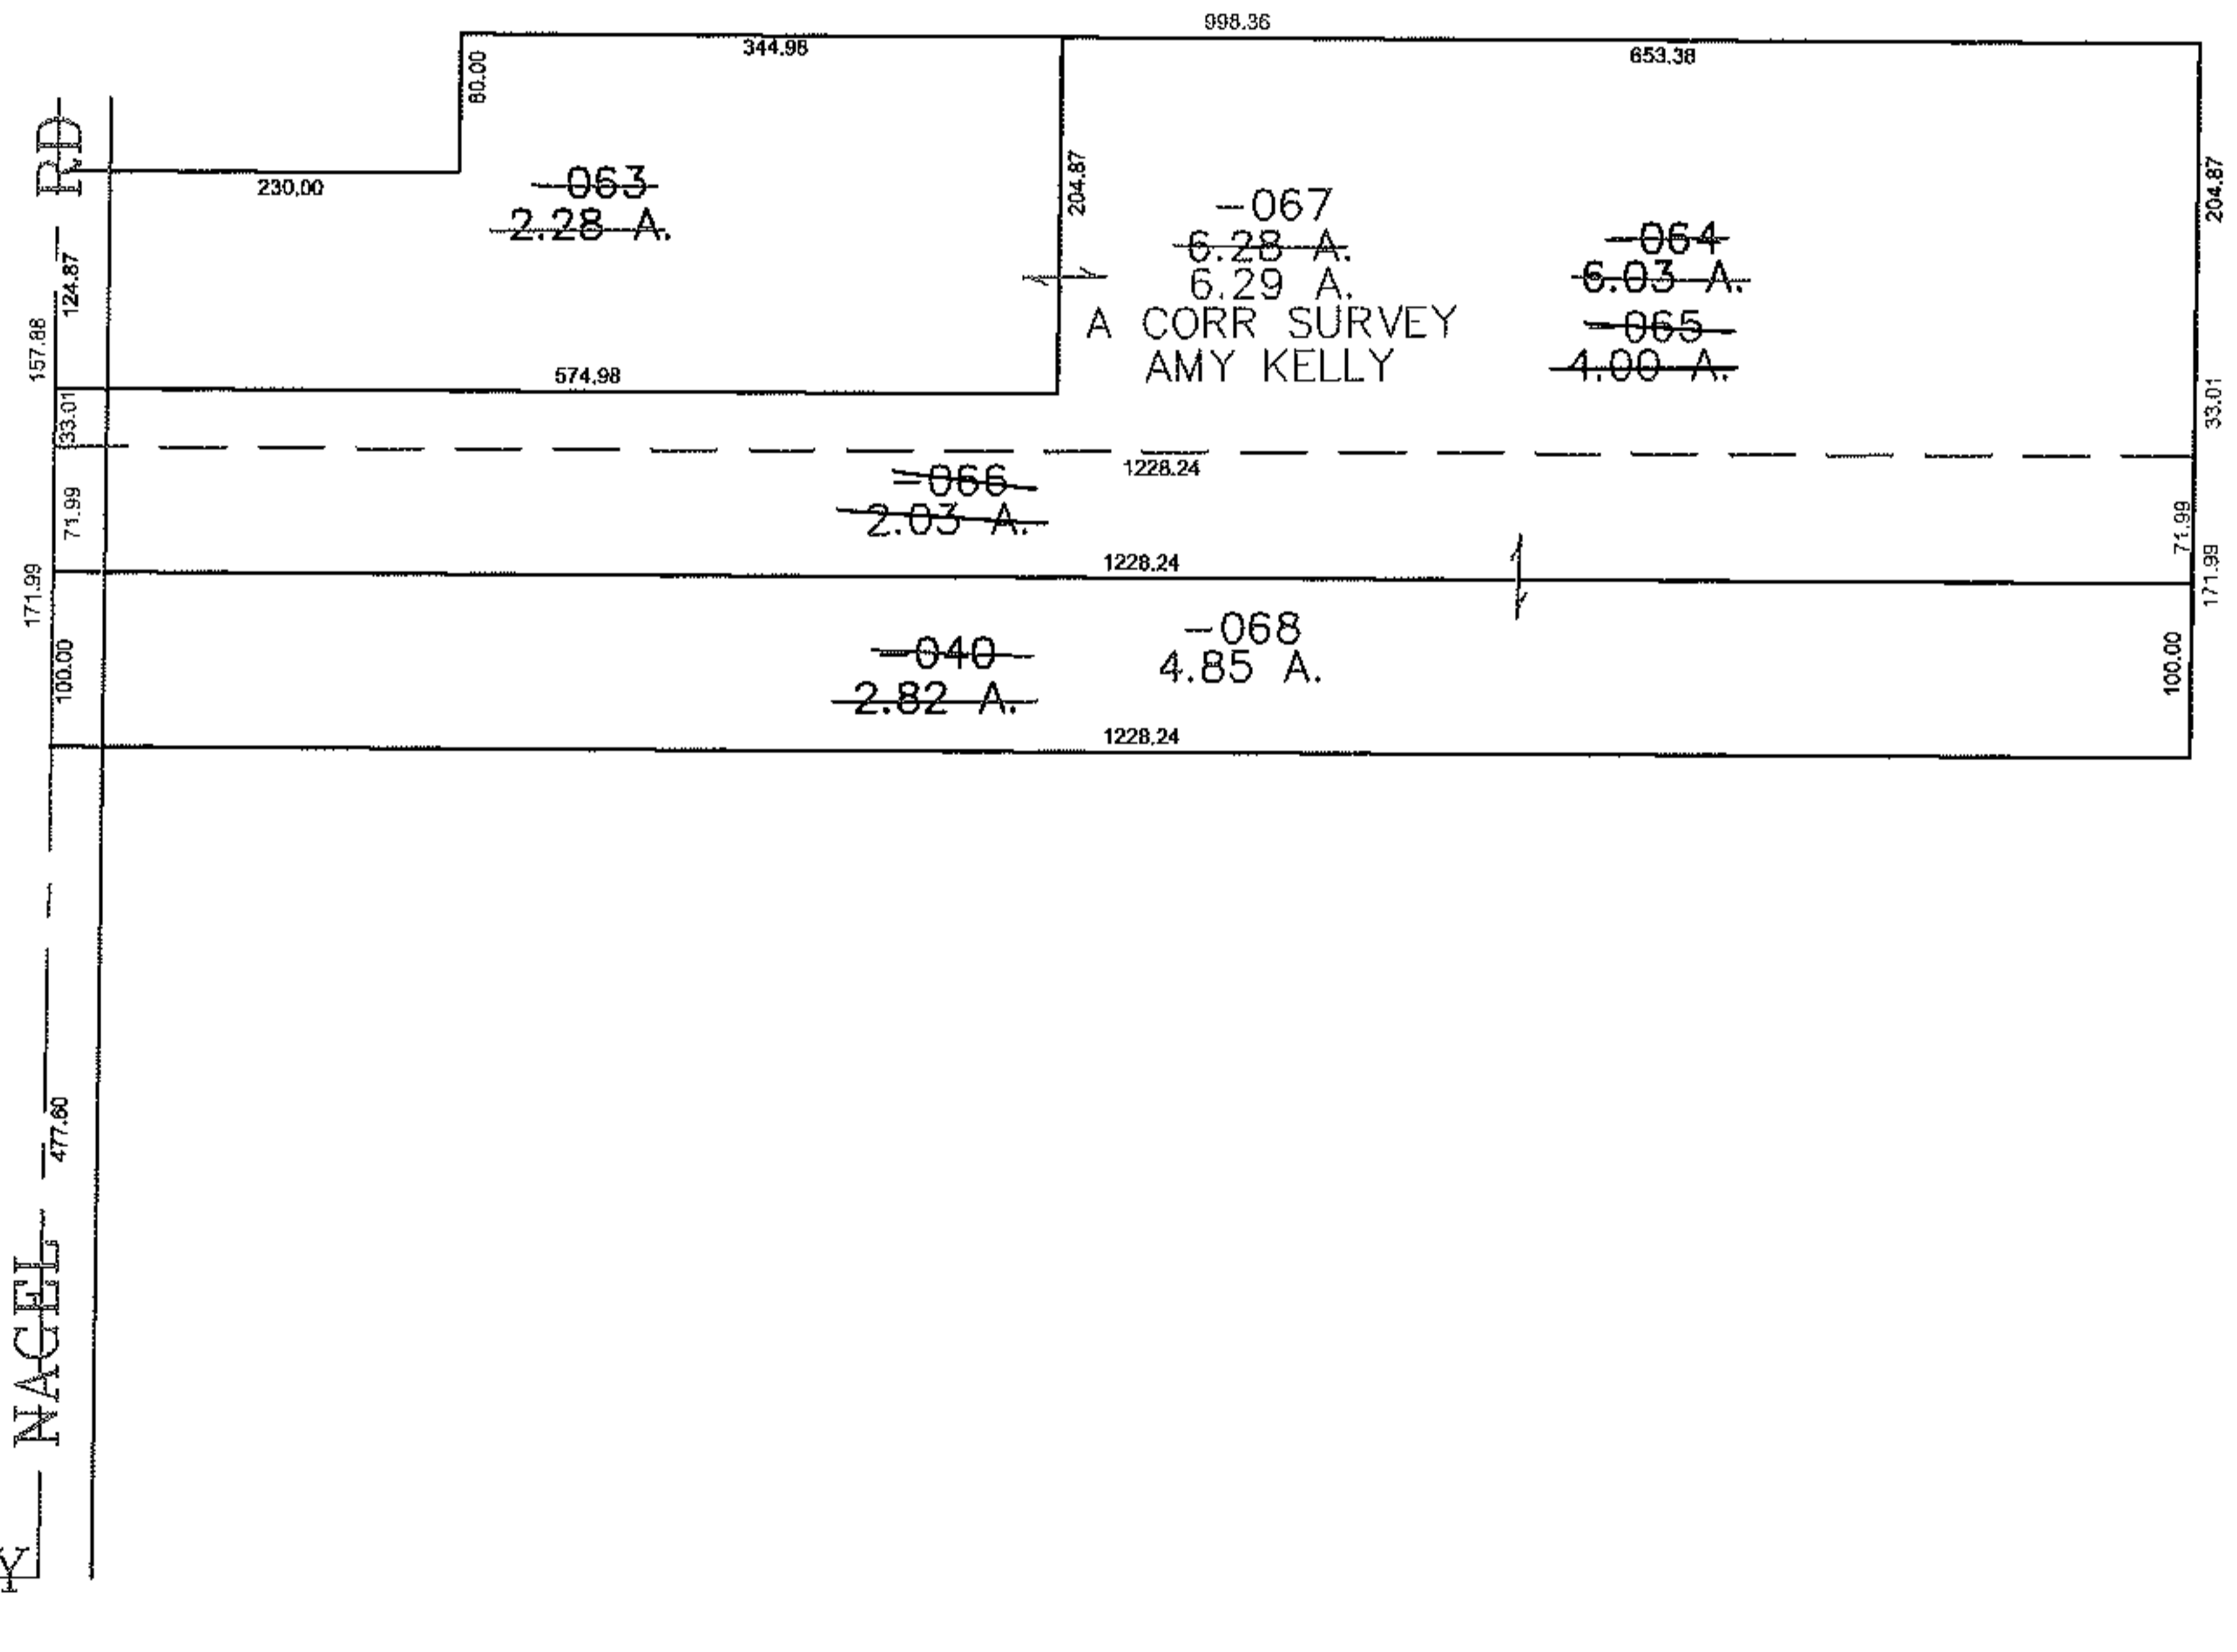


PARENT PARCEL: 04-00-026-103-064, -063, -040

CHILD PARCEL: 04-00-026-103-065 THRU -068

STARTING POINT: CENTERLINE OF NAGEL RD & HAWKSURY CT

13-03201

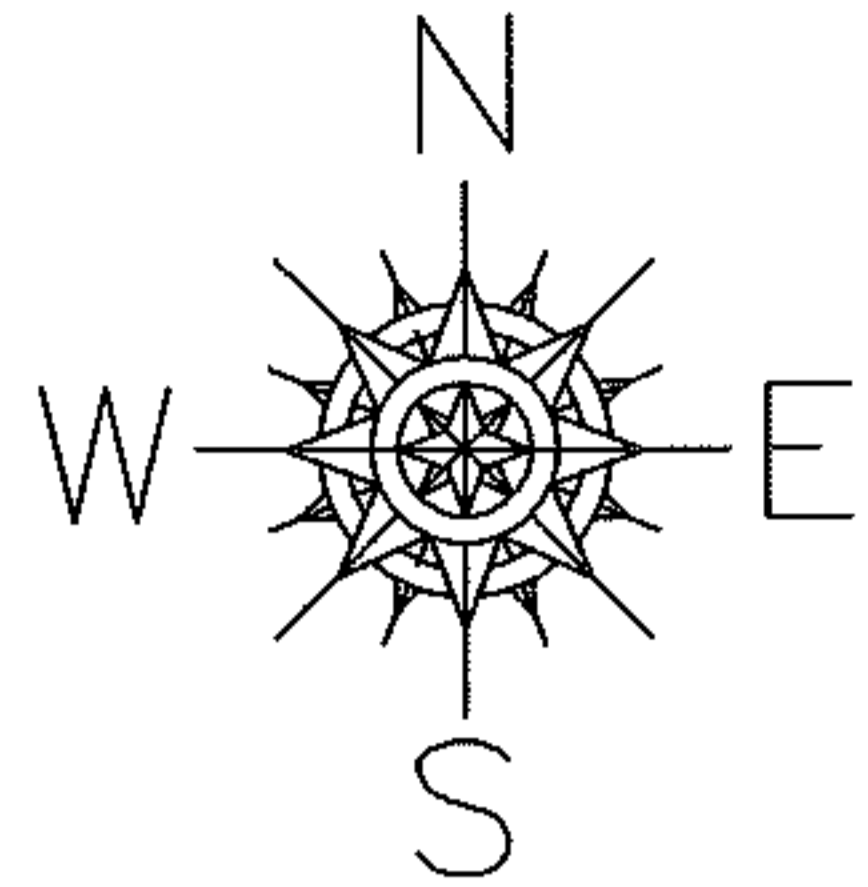

SPLITS/DEEDS PROCESSED

LORAIN COUNTY TAX MAP DEPARTMENT
226 MIDDLE AVE. ELYRIA, OHIO

SURVEYED BY: AMY KELLY

CLOSURE: 0.00 : 10.000

MAP PAGE(S): 04-00-026

APPROVED BY: JAH DATE: 11/5/2013

SCALE: 1" = 200 PRIOR INSTRUMENT: 20120425949