
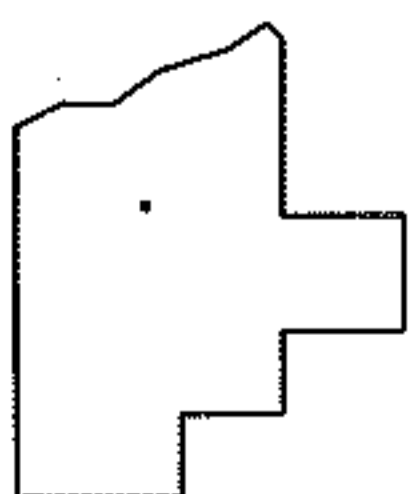
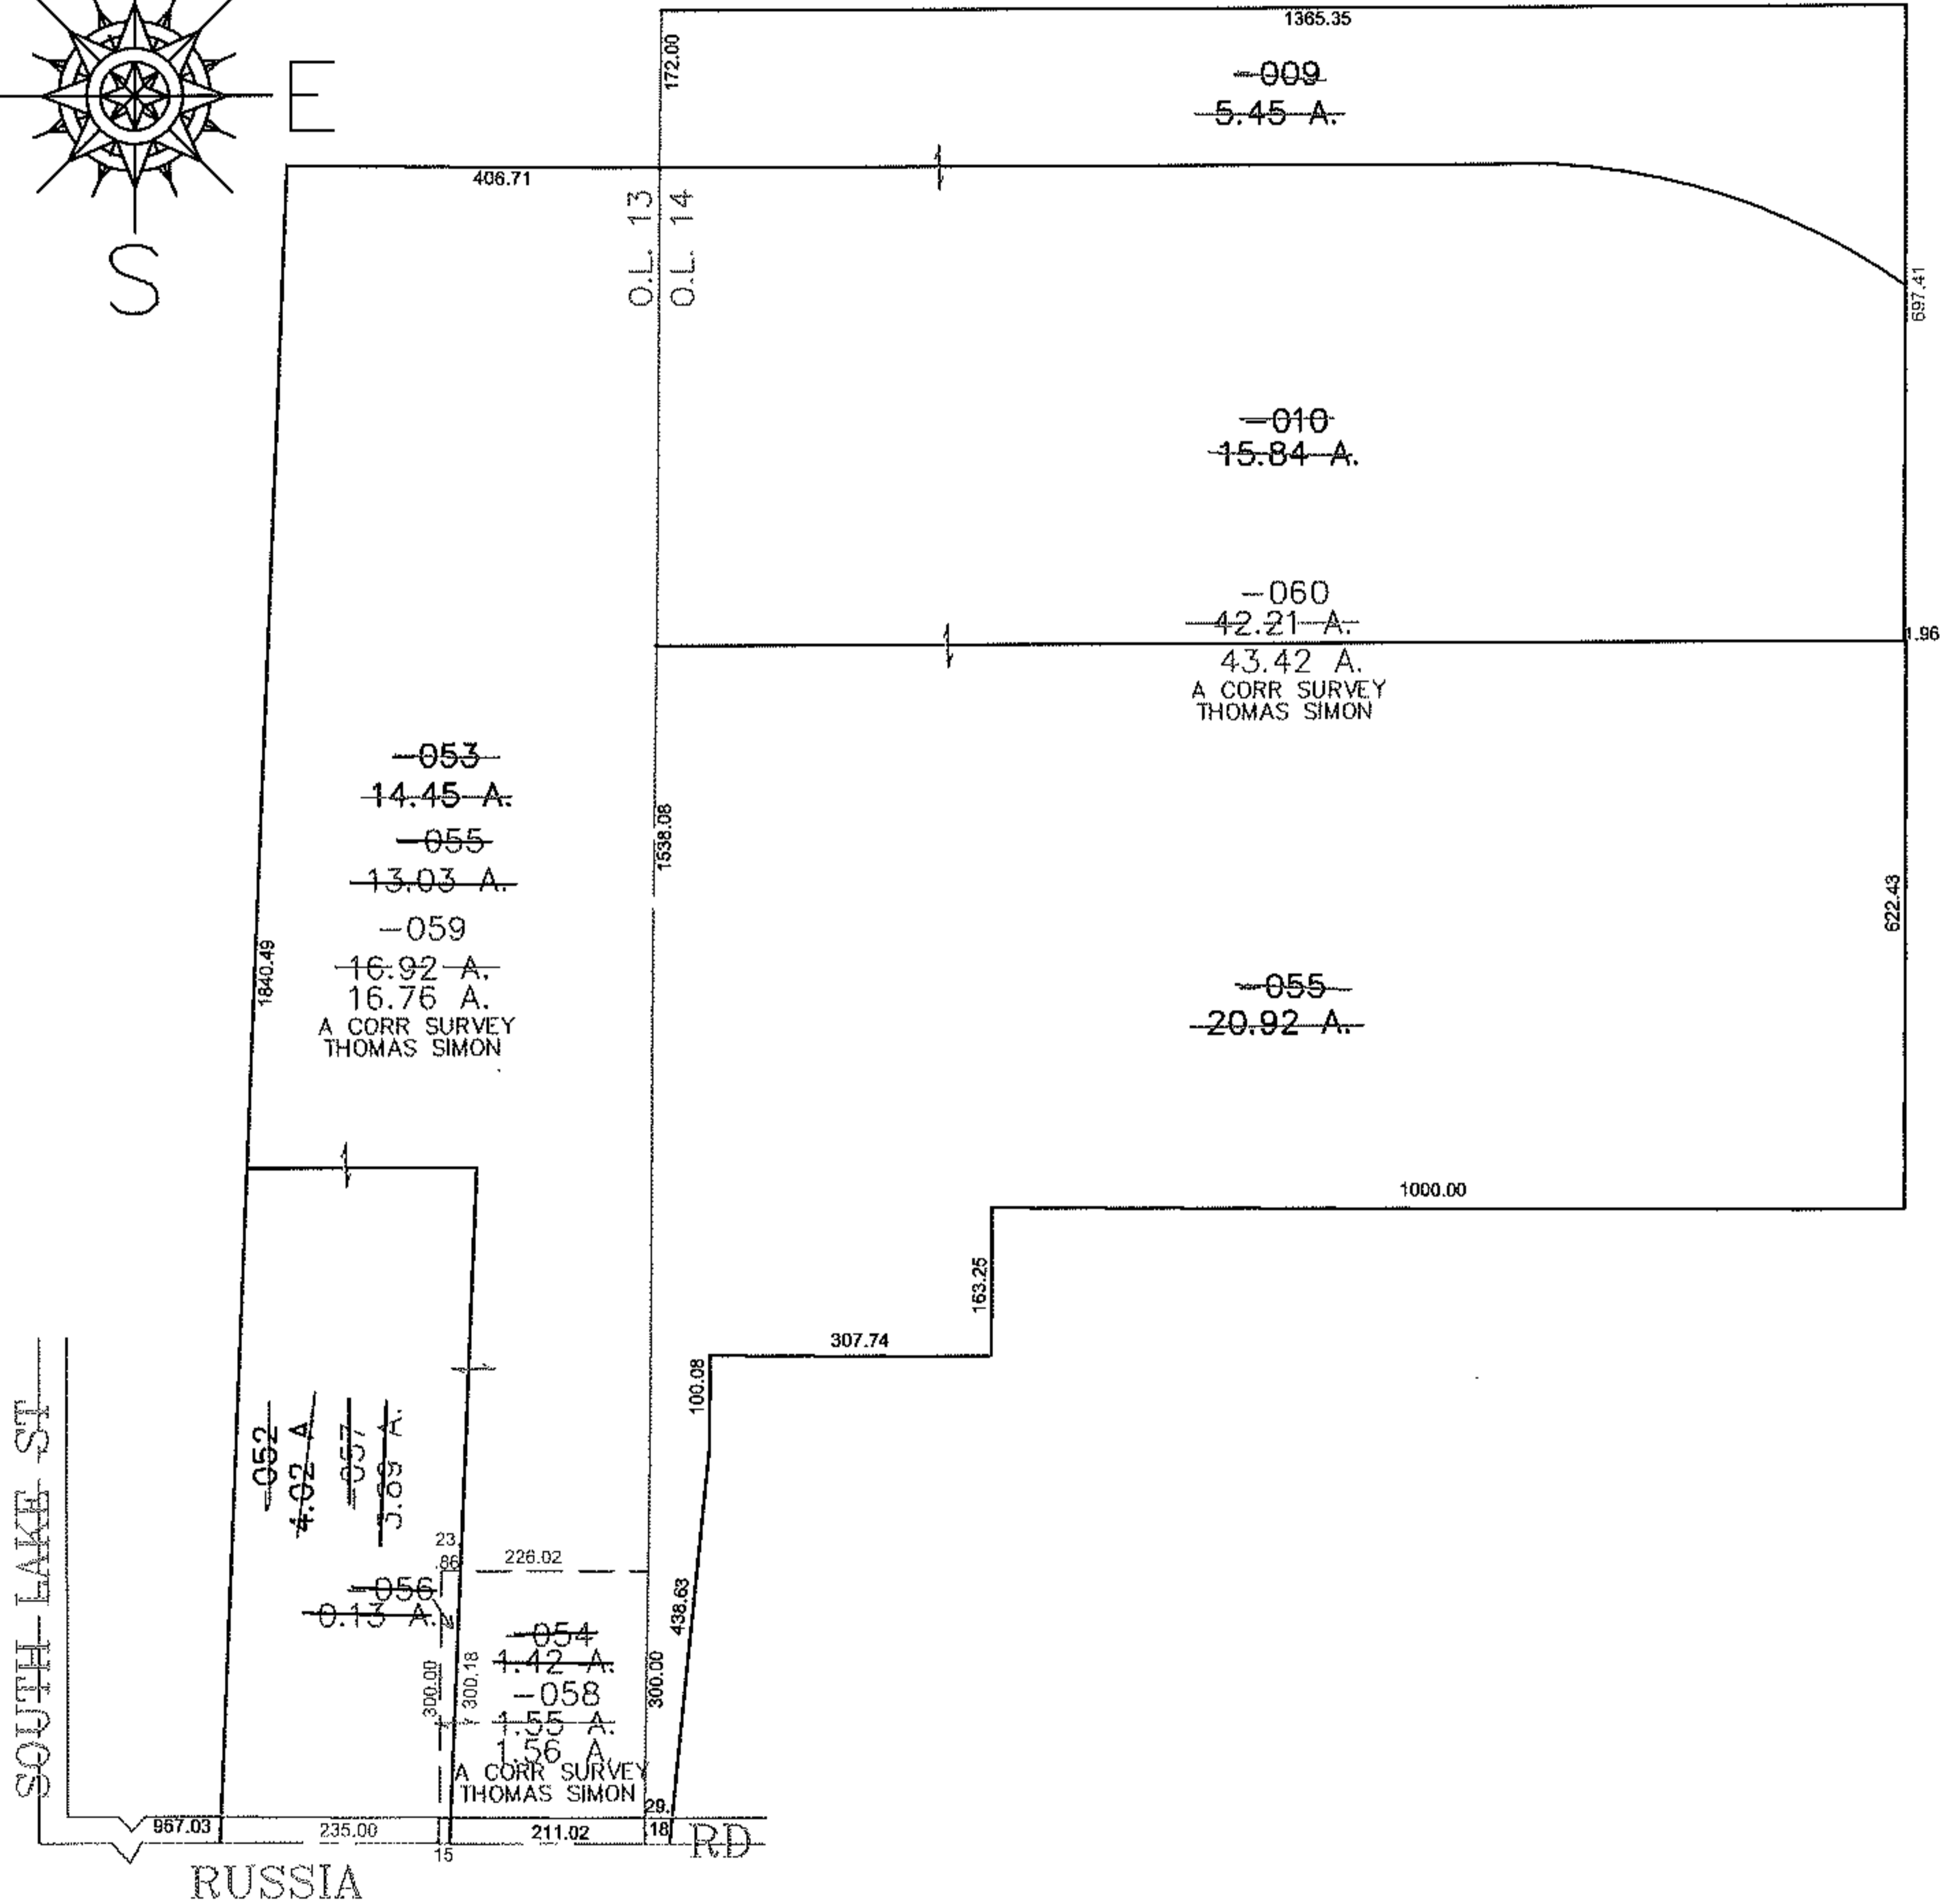


PARENT PARCEL: 09-00-013-102-053, -052, 09-00-014-101-009, -010, -055  
 CHILD PARCEL: 09-00-013-102-054 THUR -059, 09-00-014-101-060  
 STARTING POINT: CENTERLINE OF RUSSIA RD & SOUTH LAKE ST

13-03202

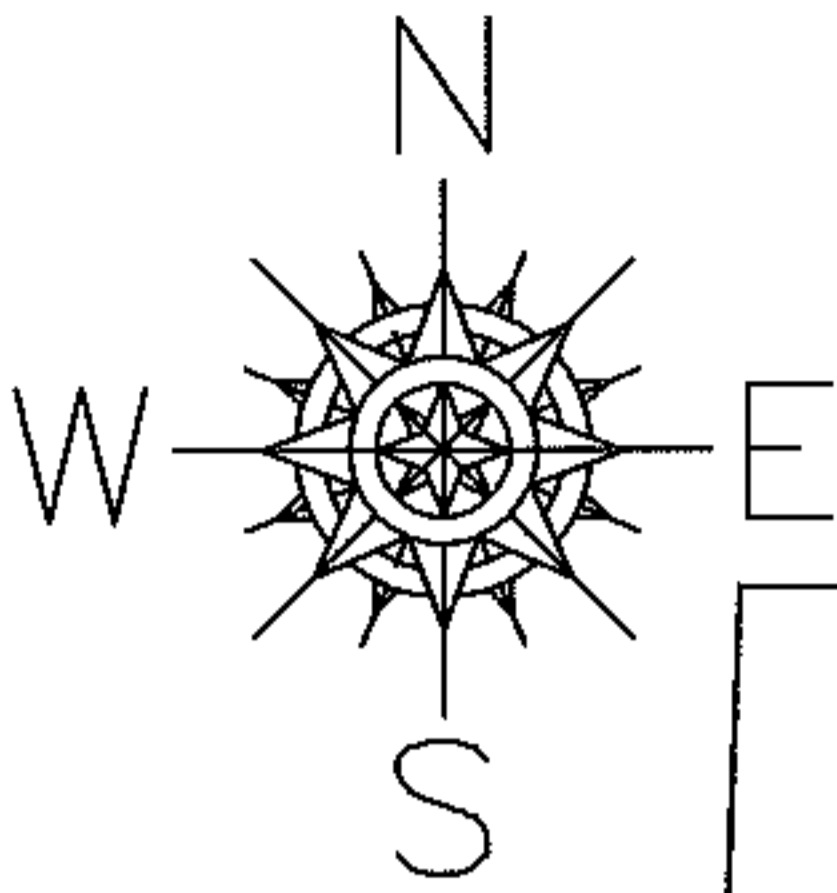

**SPLITS/DEEDS PROCESSED**  
 LORAIN COUNTY TAX MAP DEPARTMENT  
 226 MIDDLE AVE. ELYRIA, OHIO

SURVEYED BY: THOMAS SIMON  
 CLOSURE: 0.00 : 10,000  
 MAP PAGE(S): 09-00-013-B  
 APPROVED BY: JAH DATE: 11/12/2013  
 SCALE: 1" = 300 PRIOR INSTRUMENT: 20080257599