
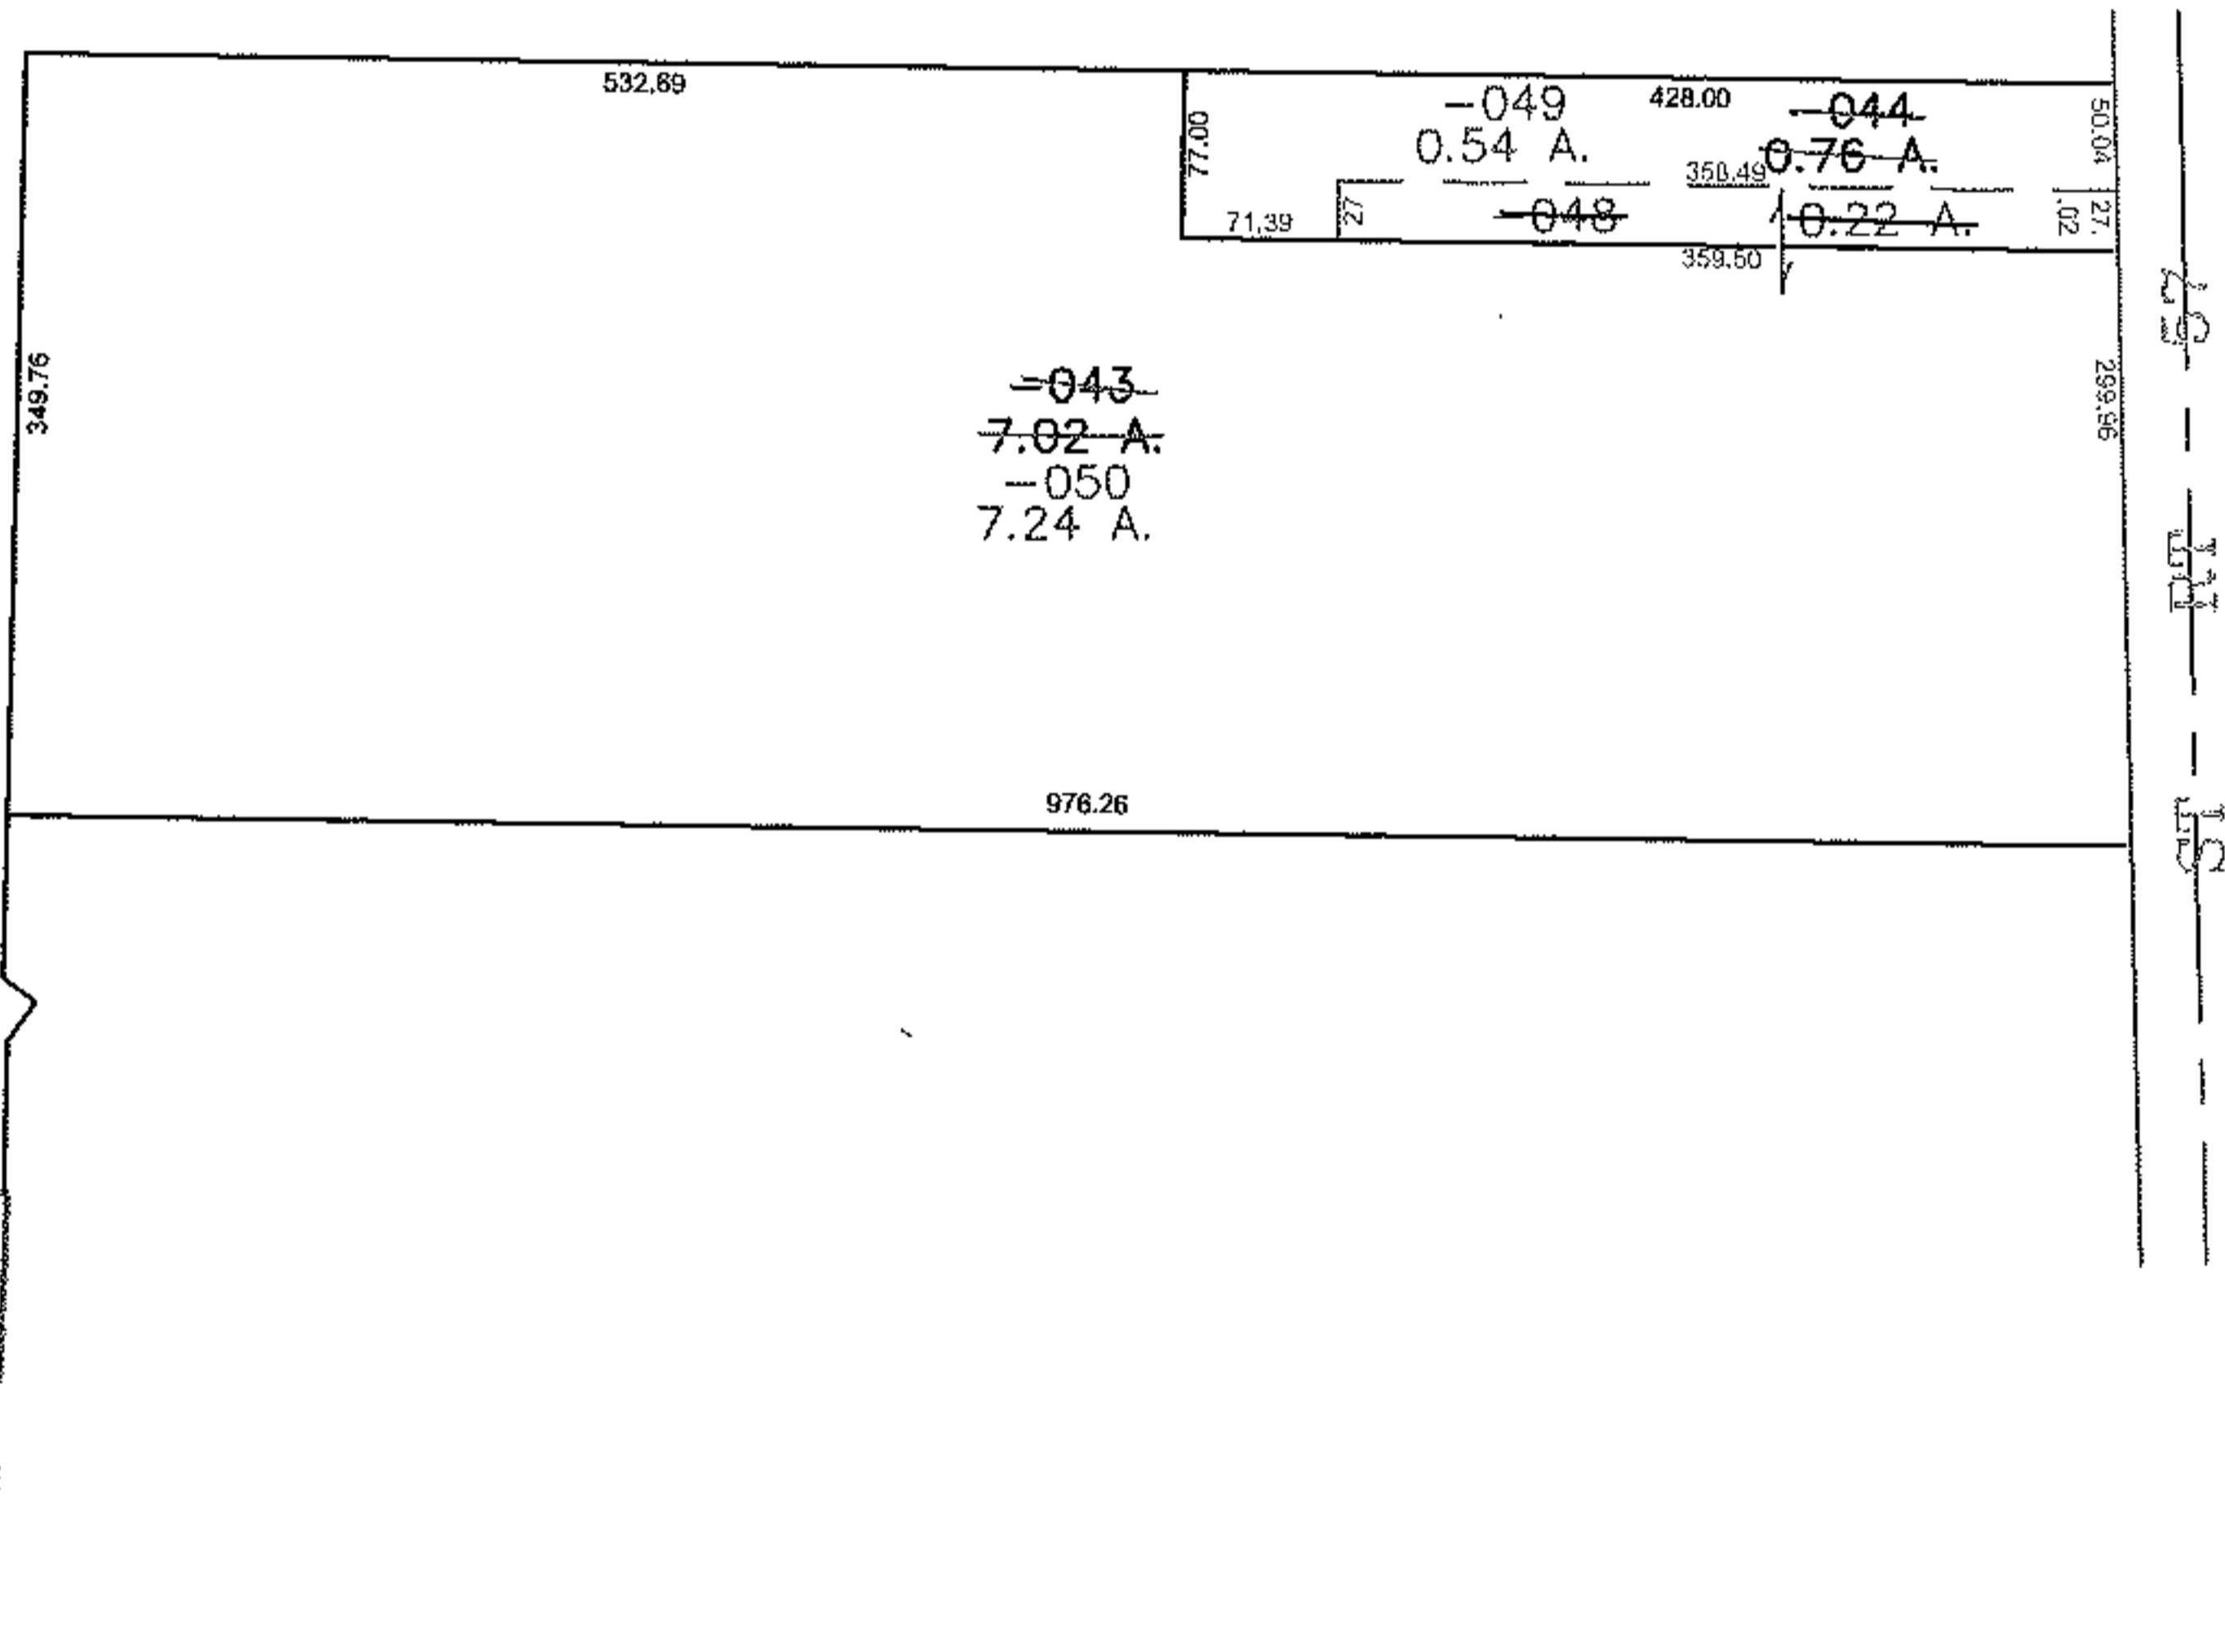


PARENT PARCEL: 03-00-104-101-043, -044


CHILD PARCEL: 03-00-104-101-048, -049, -050

STARTING POINT: NORHTEAST CORNER OF RIDGE-VUE ADDITION

13-03203

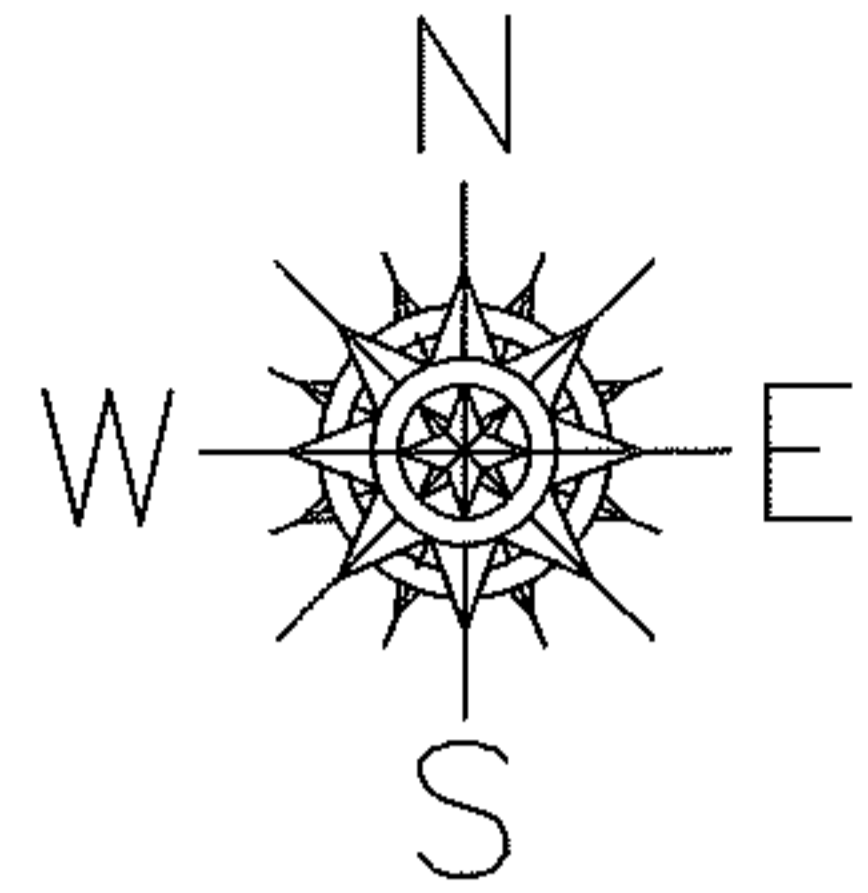

RIDGE-VUE ADD  
VOL 8 PG 21

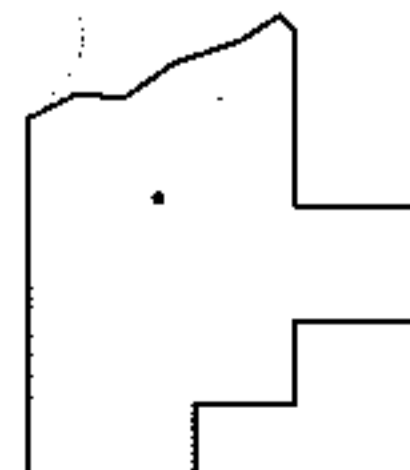

**SPLITS/DEEDS PROCESSED**  
LORAIN COUNTY TAX MAP DEPARTMENT  
226 MIDDLE AVE. ELYRIA, OHIO

SURVEYED BY: CHRISTOPHER TOMKO  
CLOSURE: 0.00 : 10,000  
MAP PAGE(S): 03-00-104-A  
APPROVED BY: JAH DATE: 11/22/2013  
SCALE: 1" = 200 PRIOR INSTRUMENT: 20100326945