
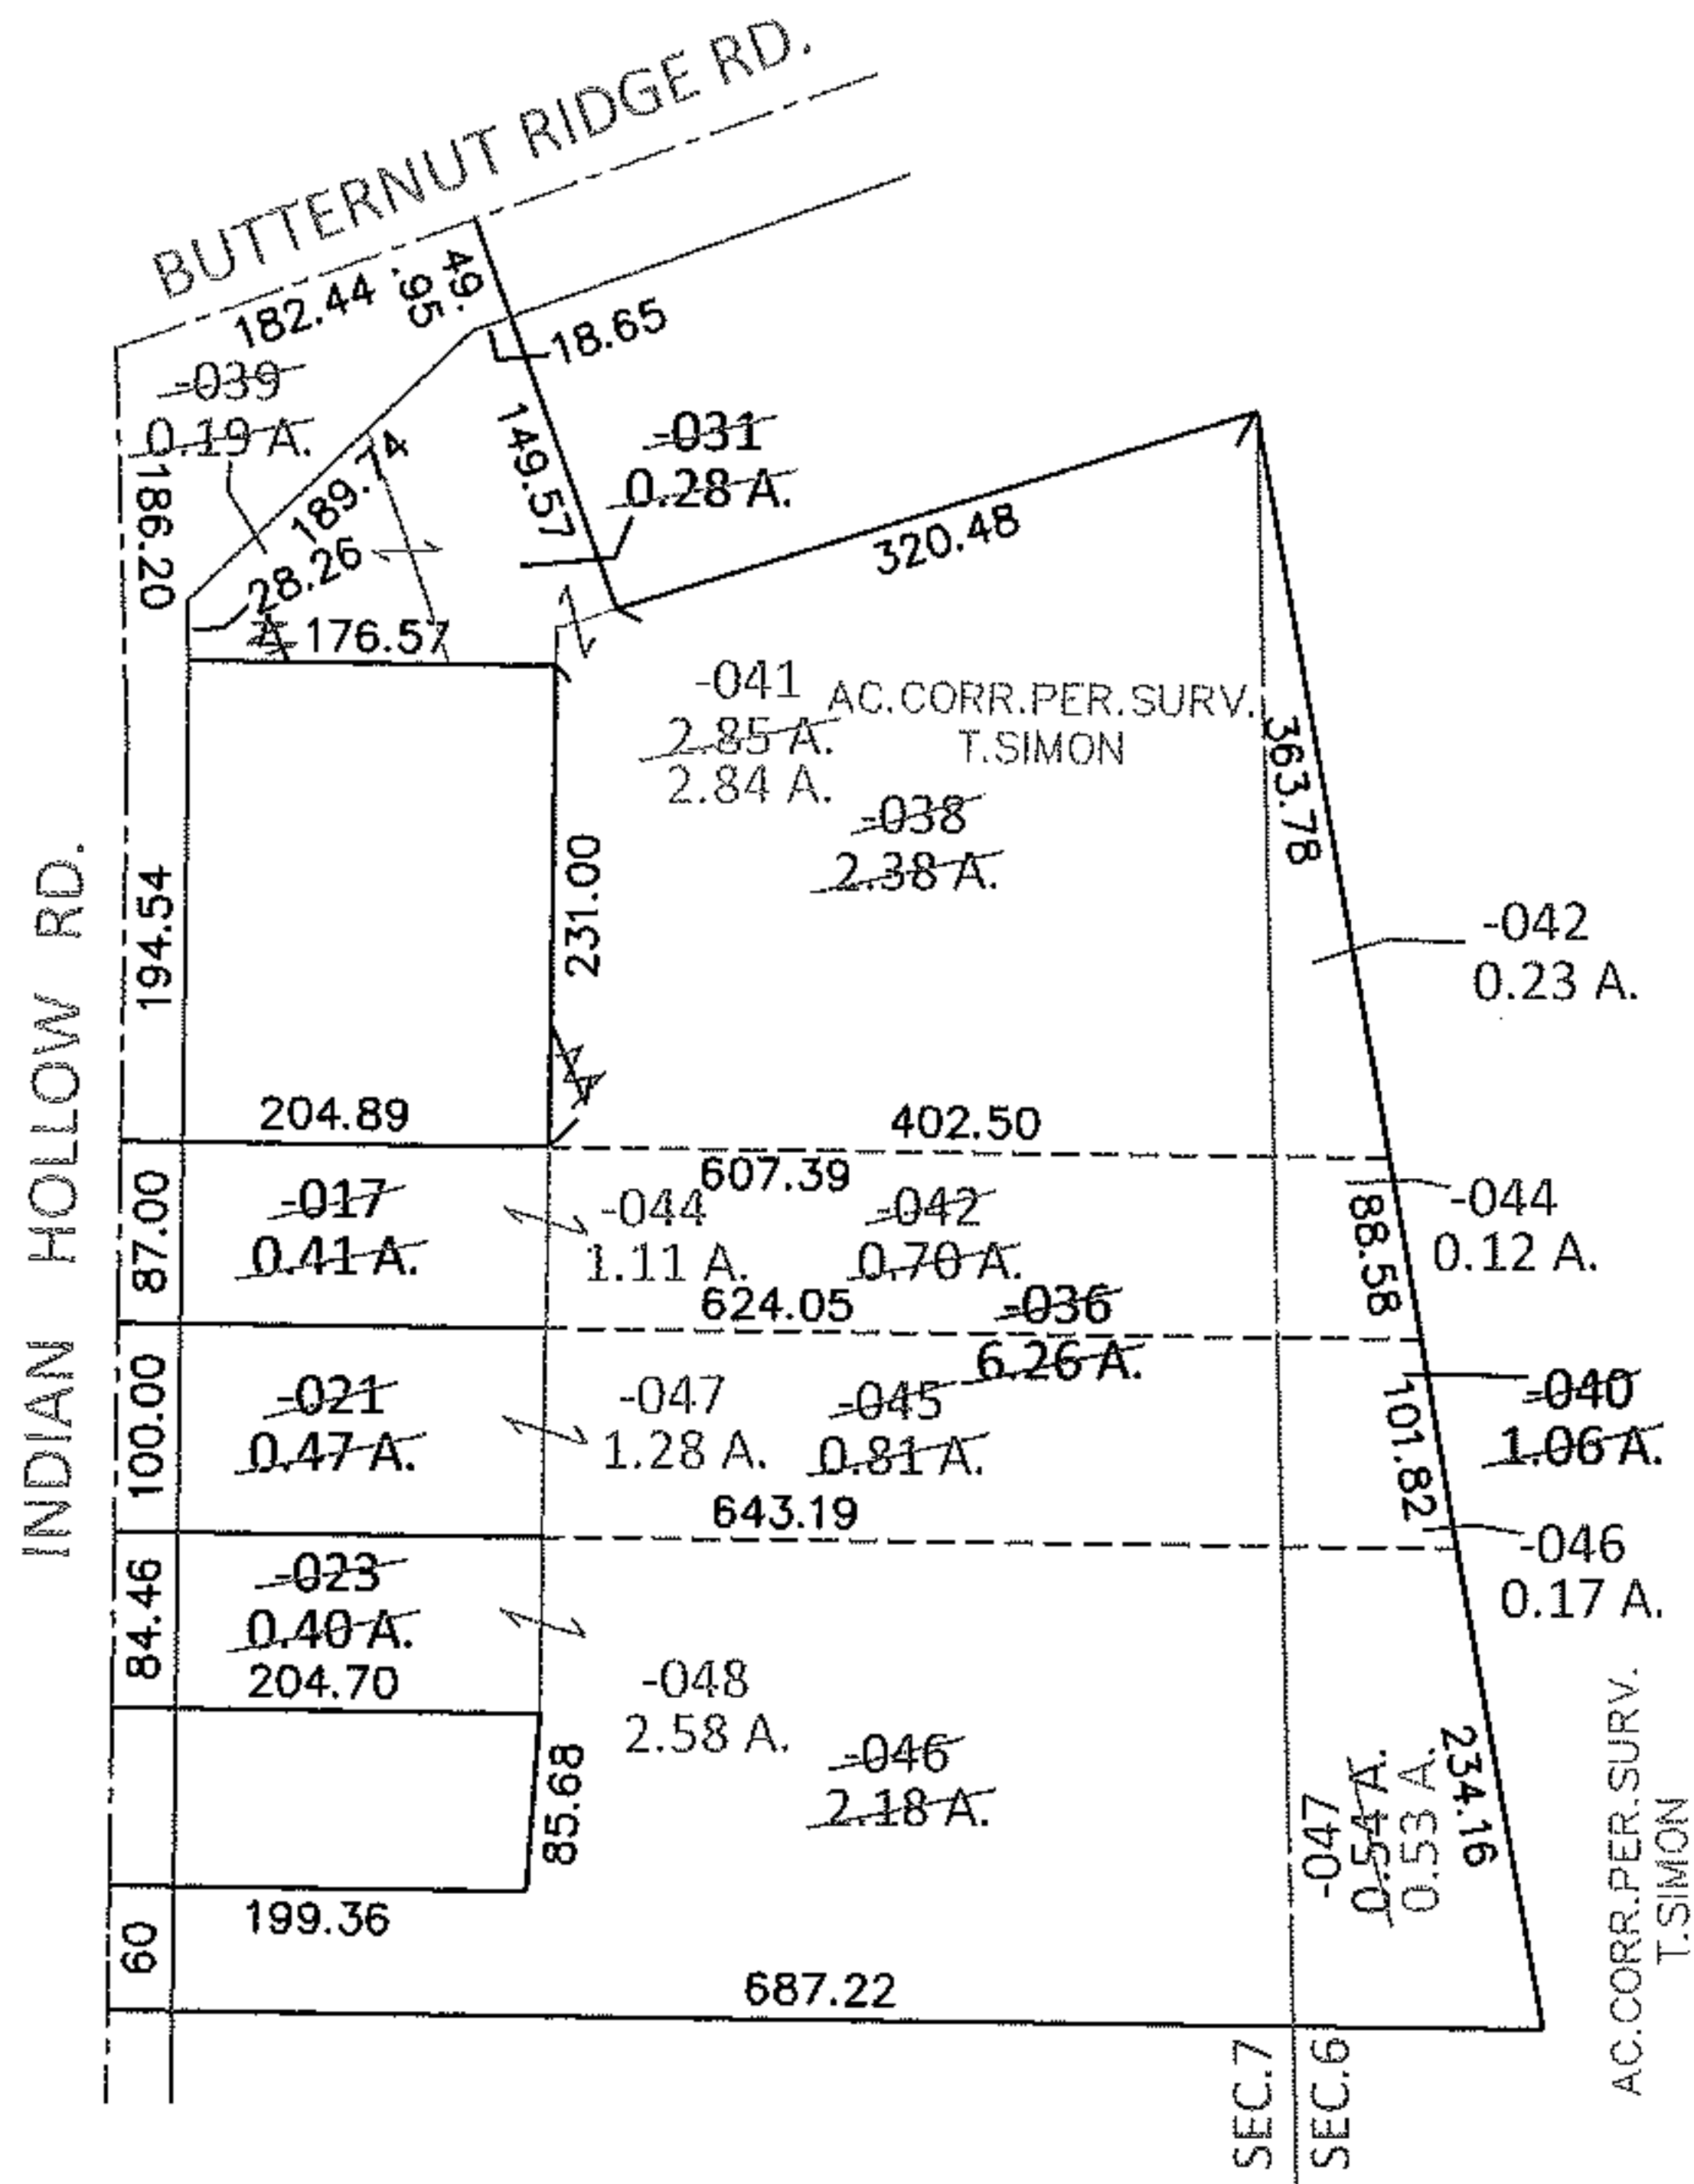


PARENT PARCEL: 10-00-006-119-040, 10-00-007-110-017, -021, -023, -031, -036

CHILD PARCEL: 10-00-006-119-042 THRU -047, 10-00-007-110-038 THRU -048


STARTING POINT: INTERSECTION OF C/L OF BUTTERNUT RIDGE RD. AND C/L OF INIDAN HOLLOW RD.

13-03204

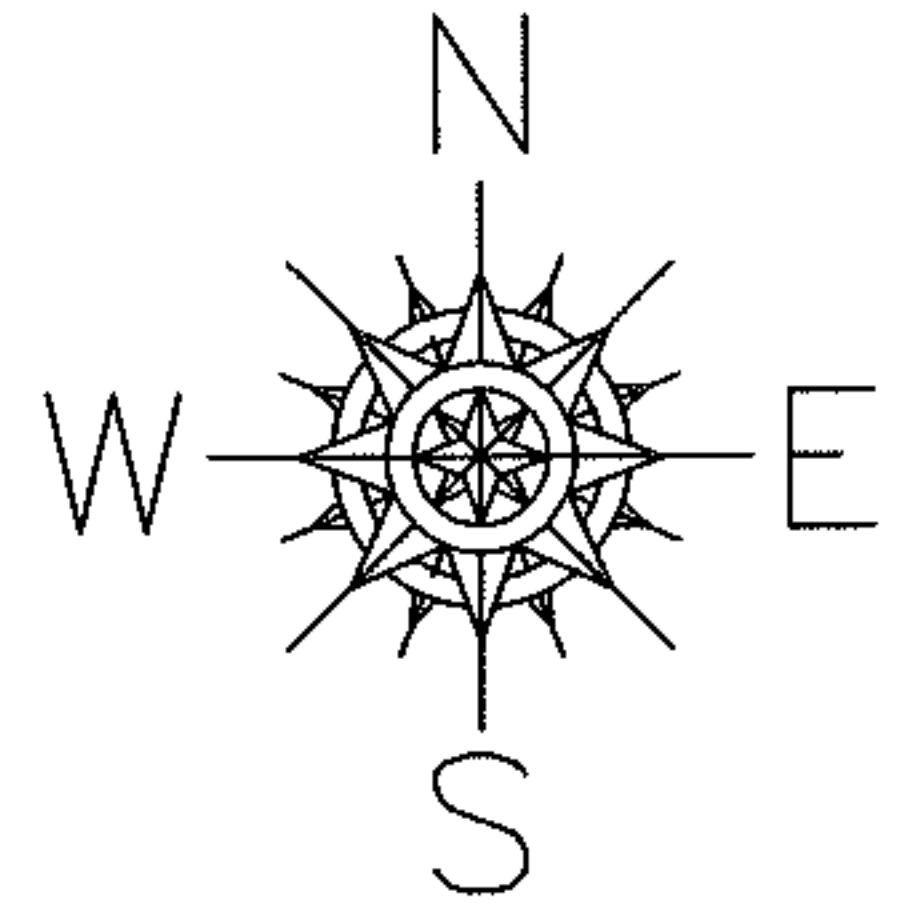

REMAINDERS

10-00-007-110-040	3.69 A.	10-00-006-119-043	0.83 A.
10-00-007-110-043	2.99 A.	10-00-006-119-045	0.71 A.

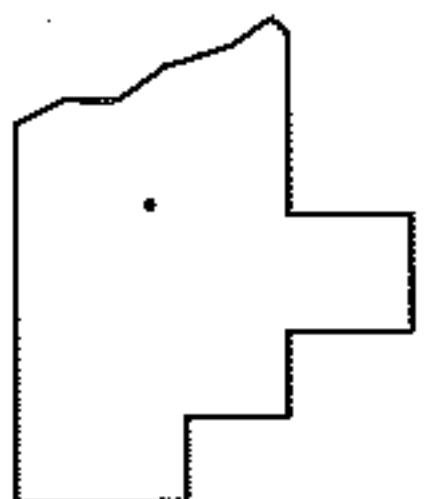

SPLITS/DEEDS PROCESSED

LORAIN COUNTY TAX MAP DEPARTMENT
226 MIDDLE AVE. ELYRIA, OHIO

SURVEYED BY: THOMAS A. SIMON
 CLOSURE: .01:10,000
 MAP PAGE(S): 10-00-007-H
 APPROVED BY: RRM DATE: 12-6-13
 SCALE: 1"=200 PRIOR INST.: