
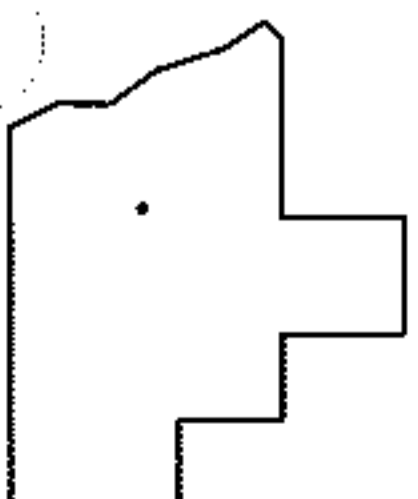
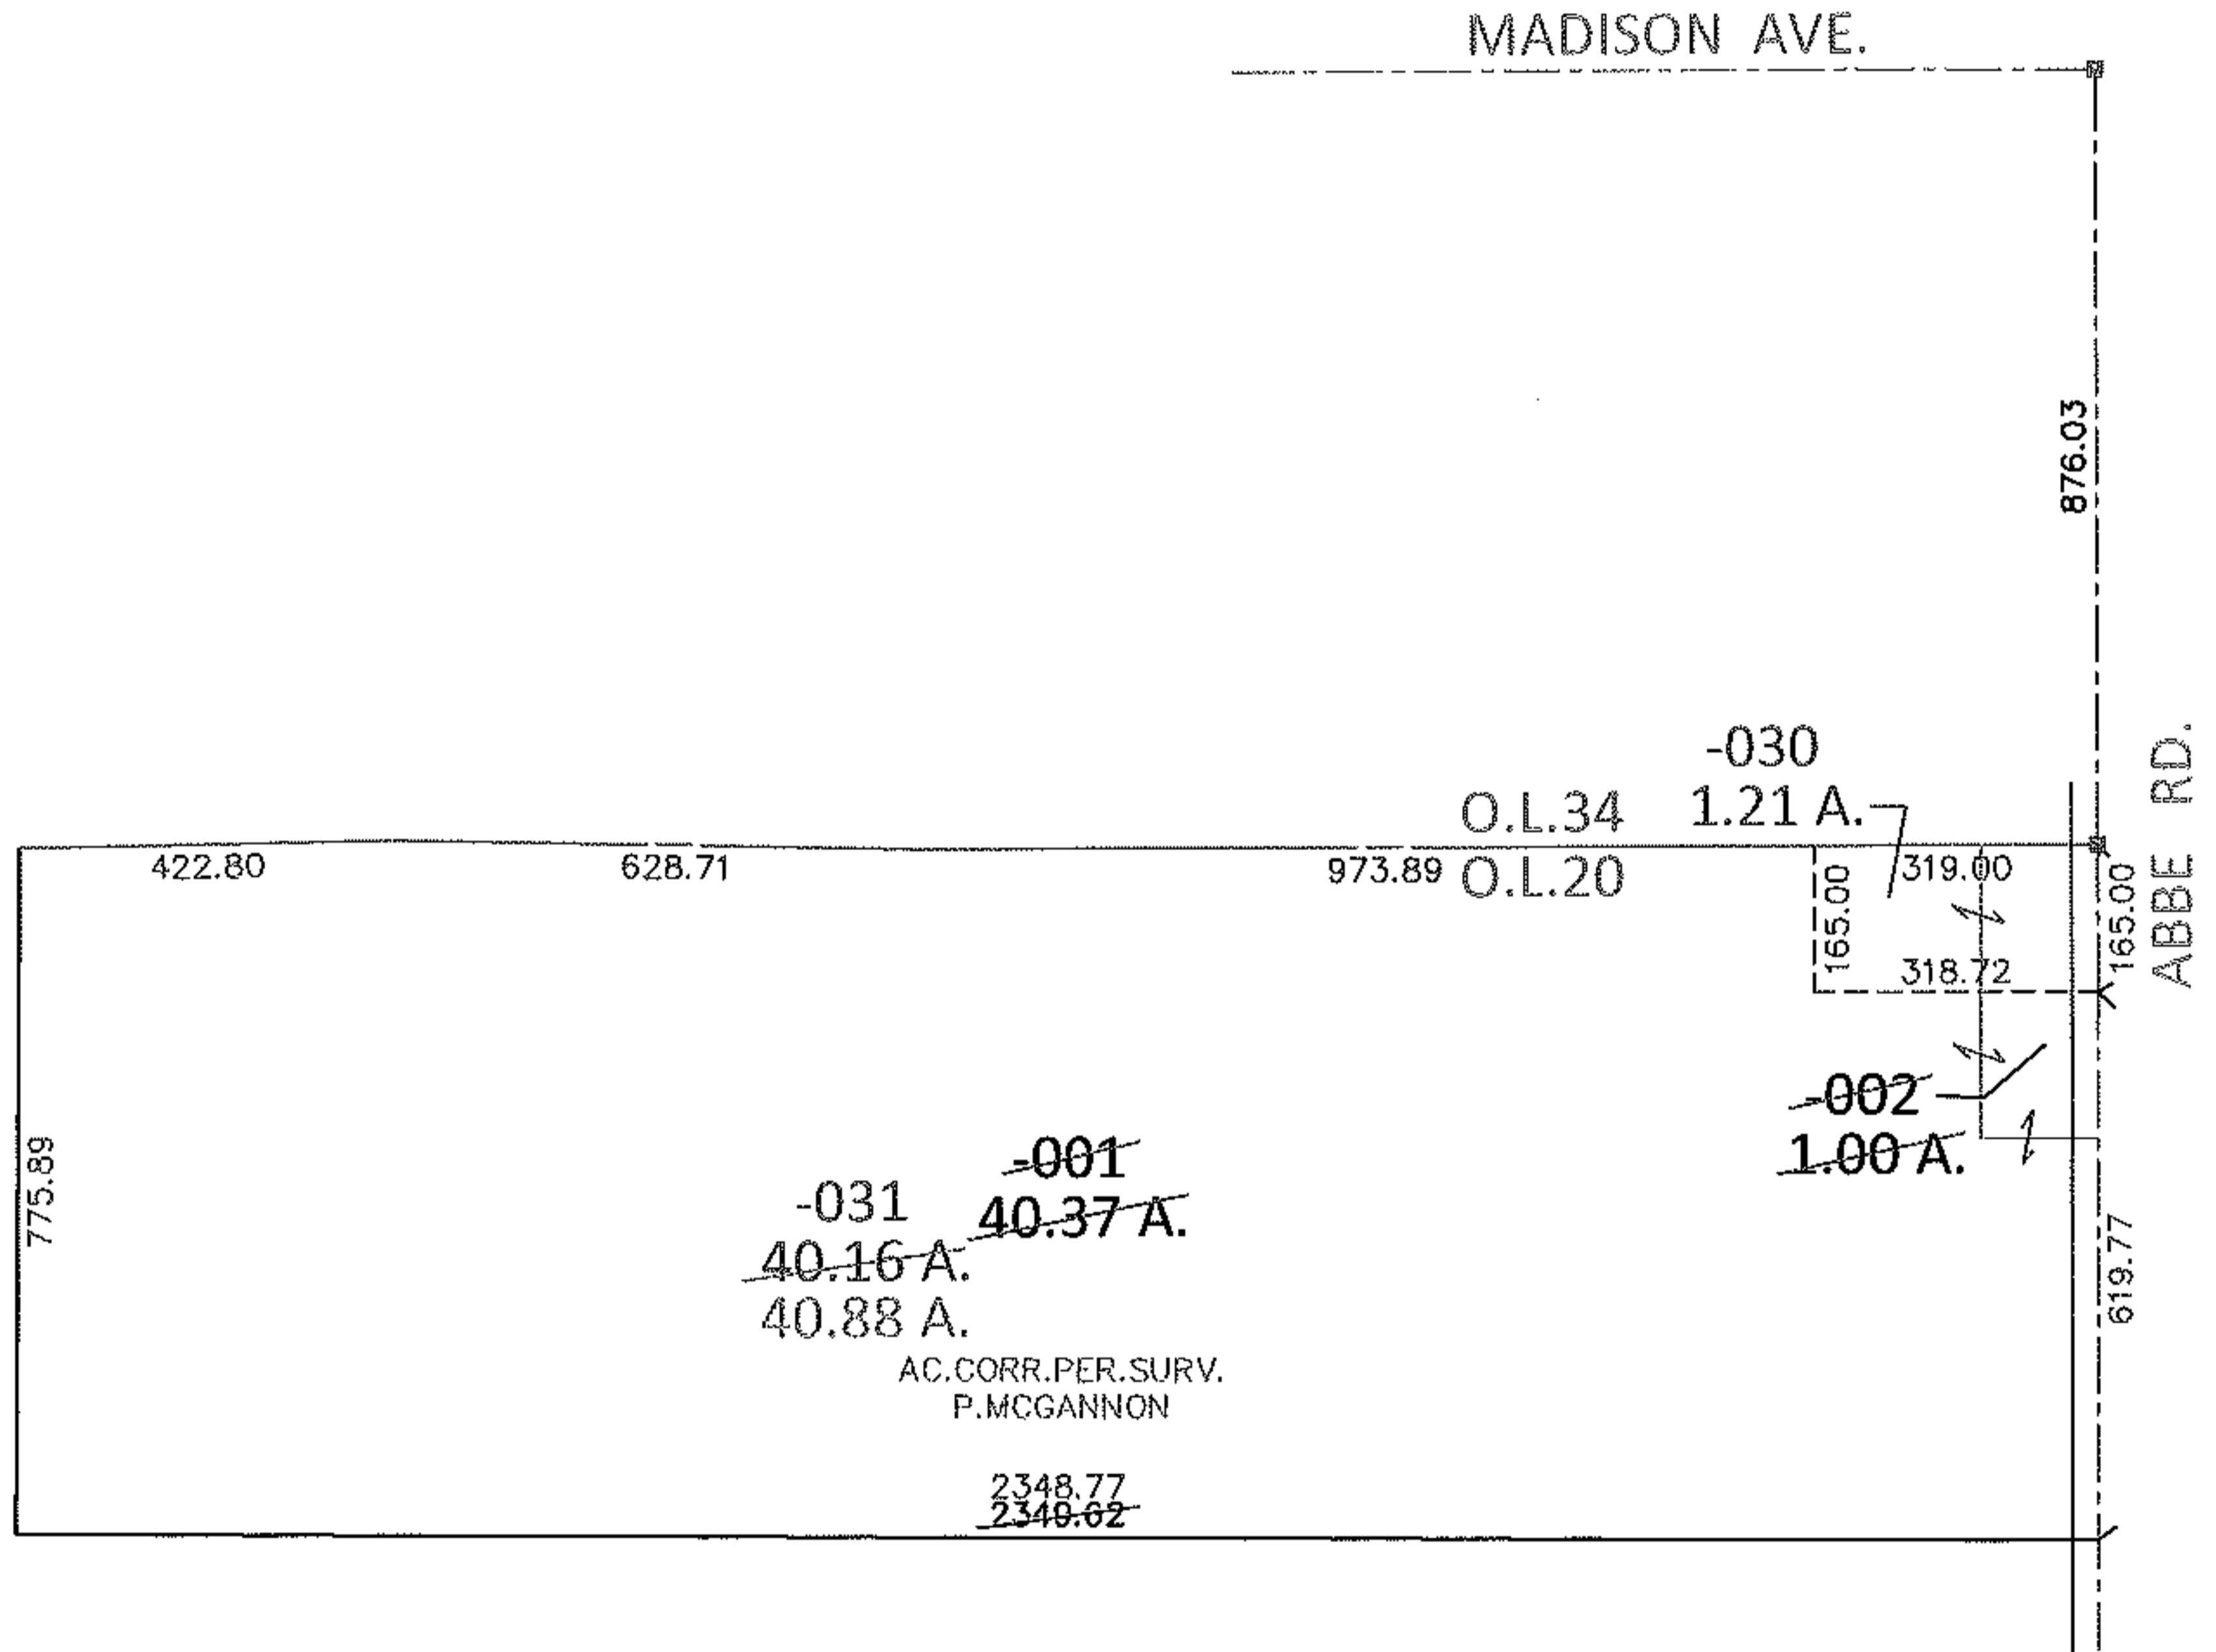


PARENT PARCEL: 03-00-020-000-001, -002

CHILD PARCEL: 03-00-020-000-030, -031

13-03206

STARTING POINT: AT A MON BOX AT THE NORTHEAST CORNER OF O.L.20

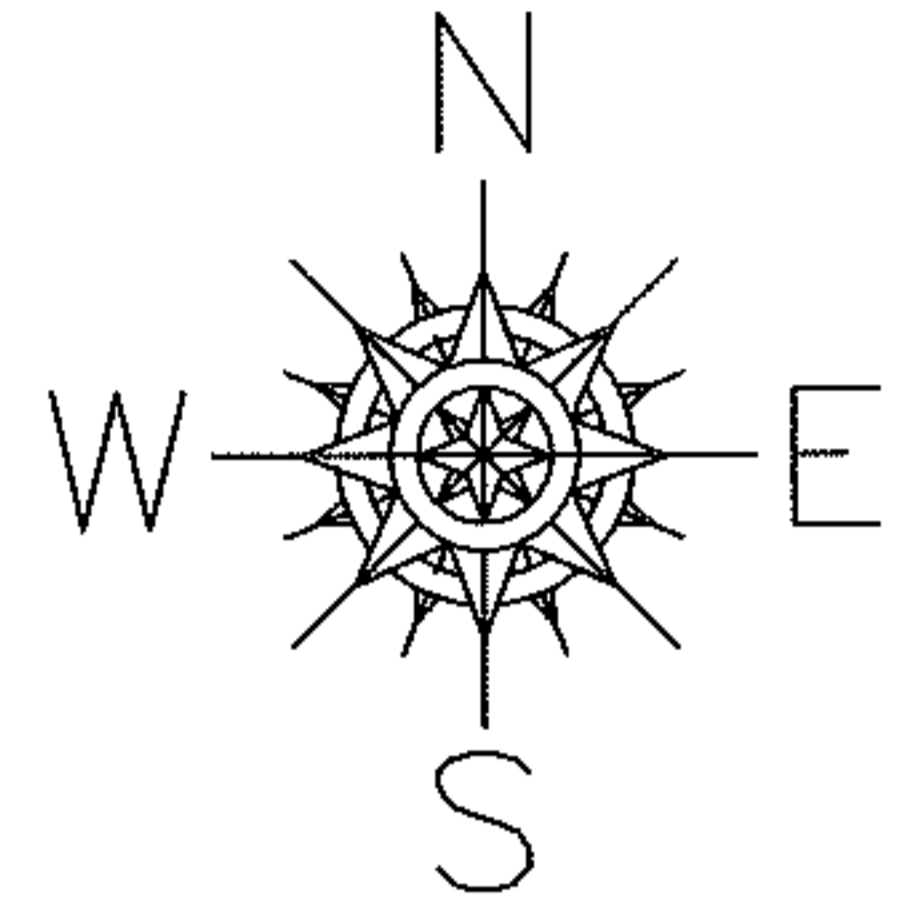

**SPLITS/DEEDS PROCESSED**

LORAIN COUNTY TAX MAP DEPARTMENT  
226 MIDDLE AVE. ELYRIA, OHIO

SURVEYED BY: PATRICK A. MCGANNON

CLOSURE: .01:10,000

MAP PAGE(S): 3-00-020-A & B

APPROVED BY: RRM DATE: 11-26-13

SCALE: 1" = 400 PRIOR INST.: 20130461796