
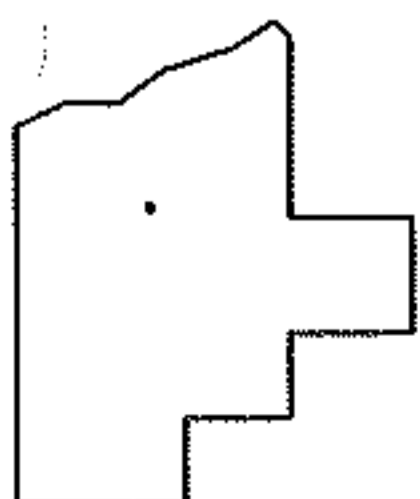
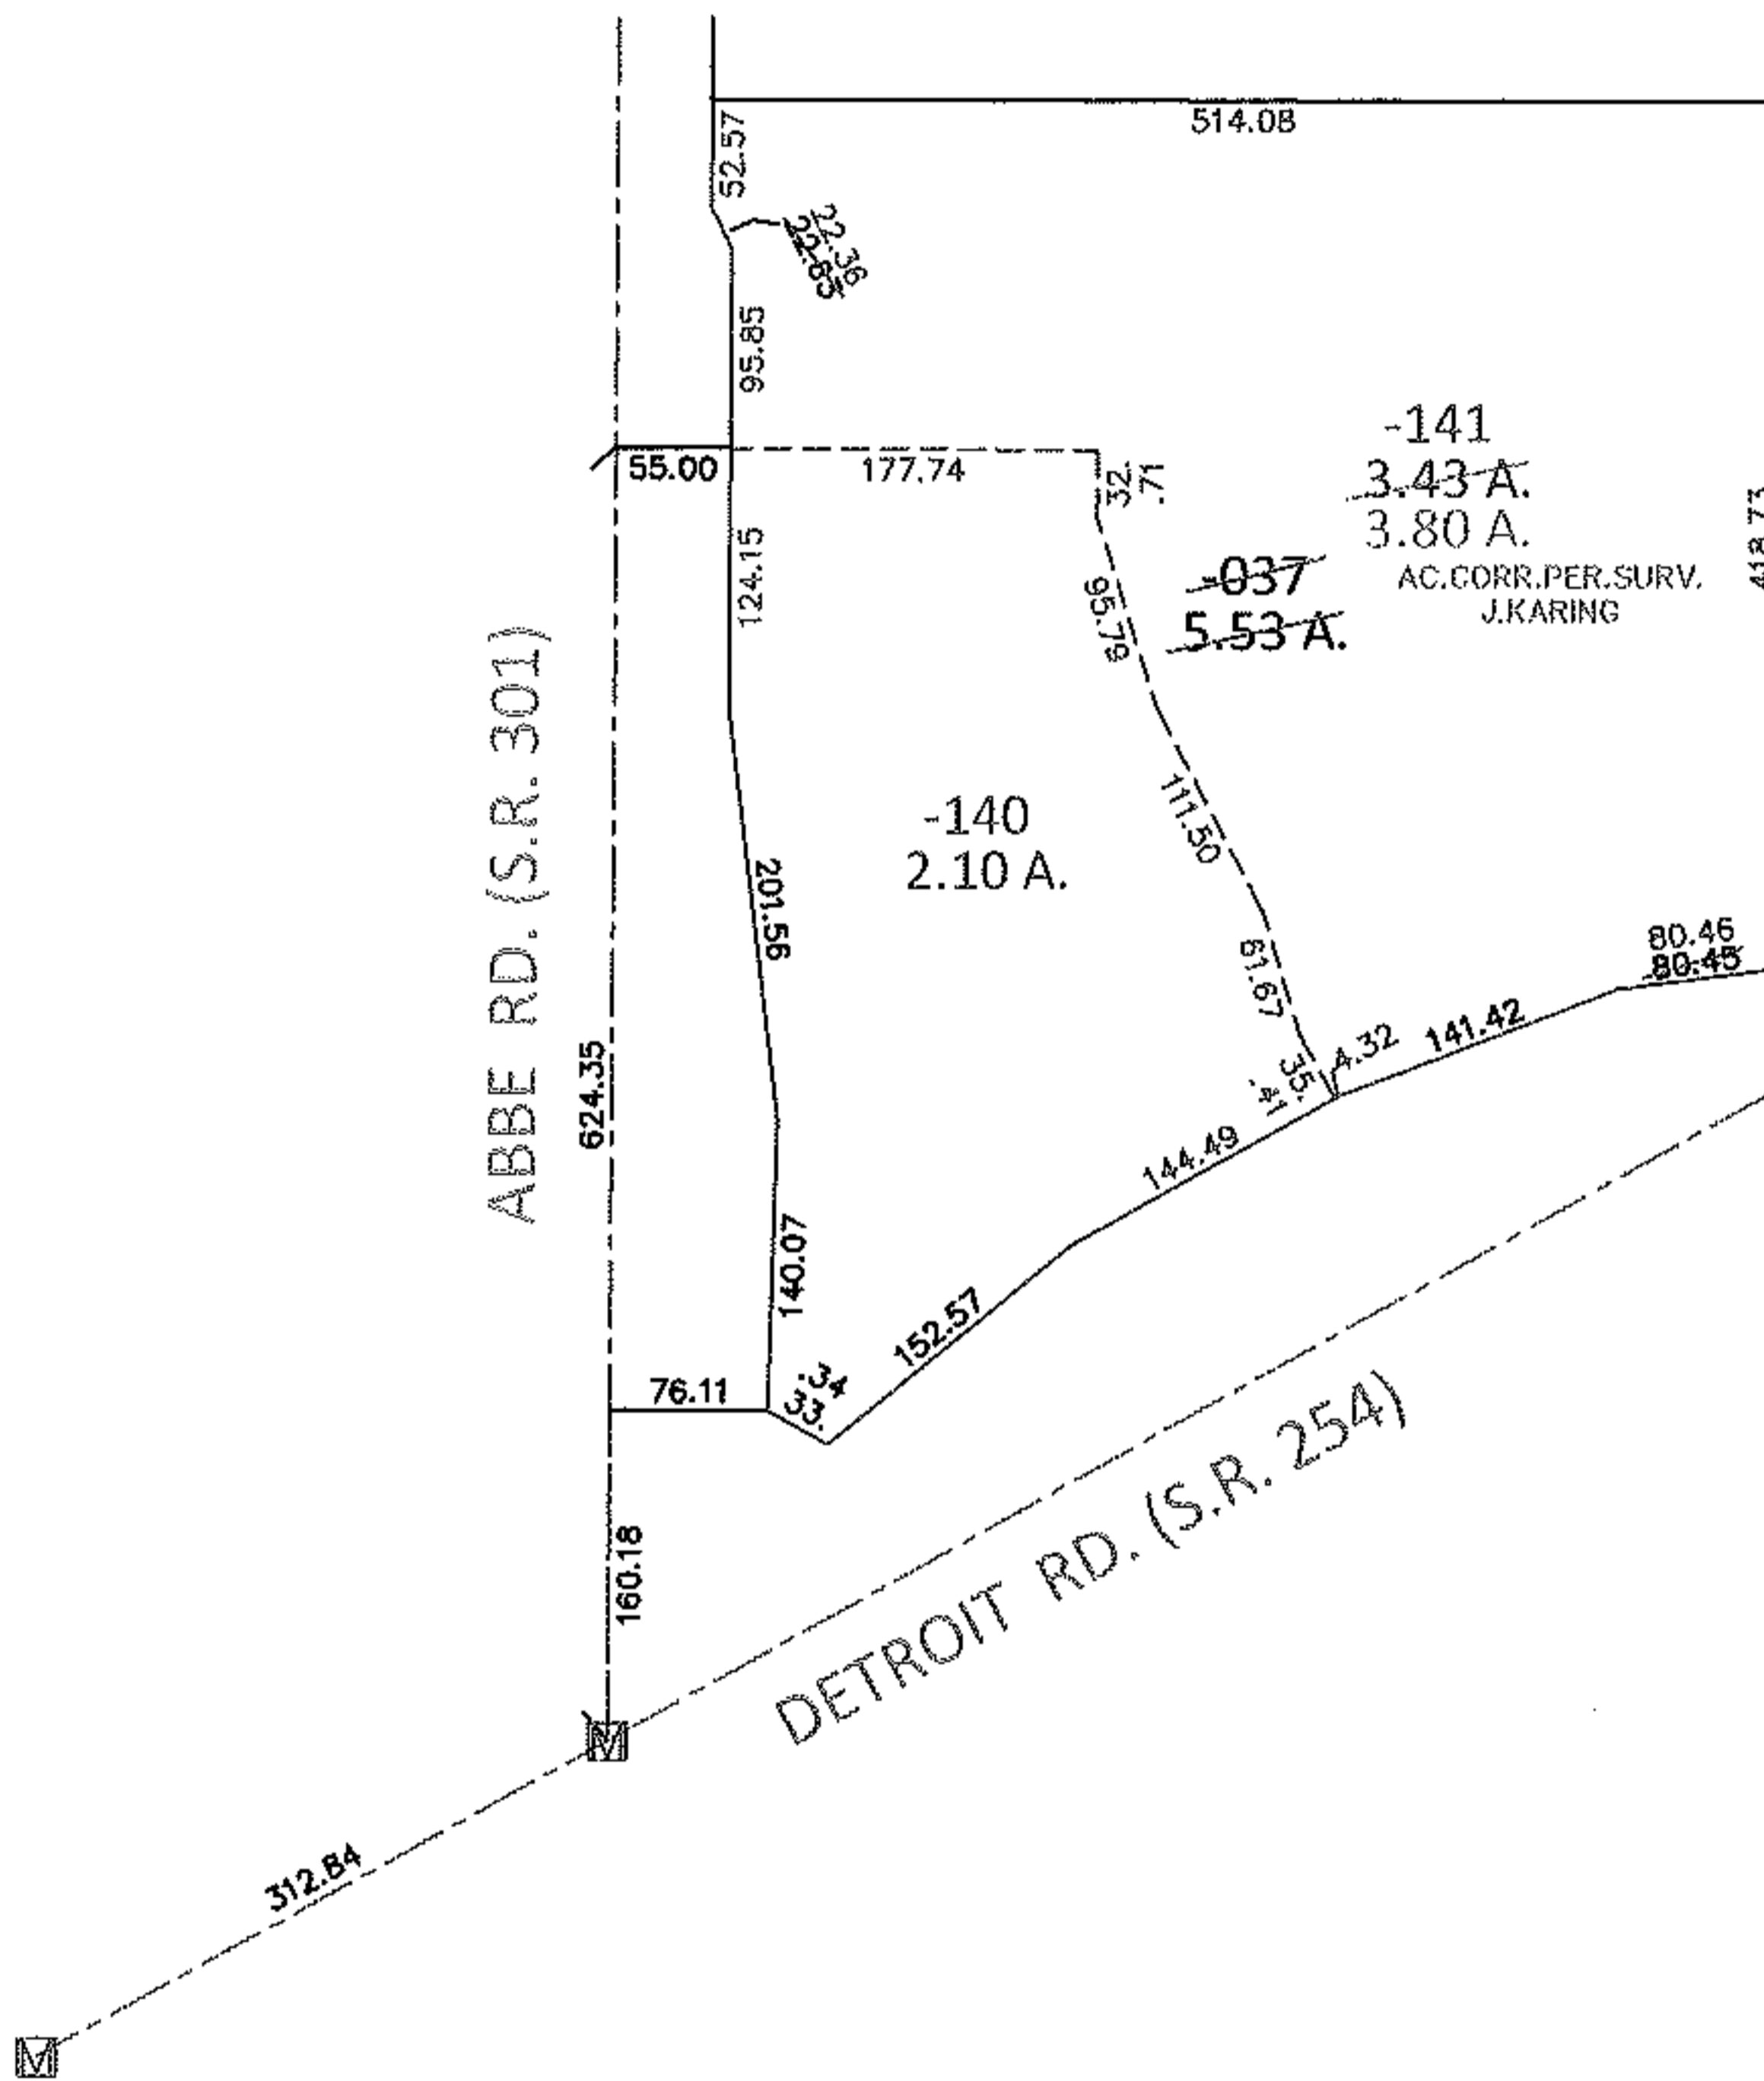


PARENT PARCEL: 03-00-002-101-037

CHILD PARCEL: 03-00-002-101-140, -141

13-03207

STARTING POINT: AT A MON BOX AT THE INTERSECTION OF C/L OF DETROIT RD. AND C/L OF ABBE RD.

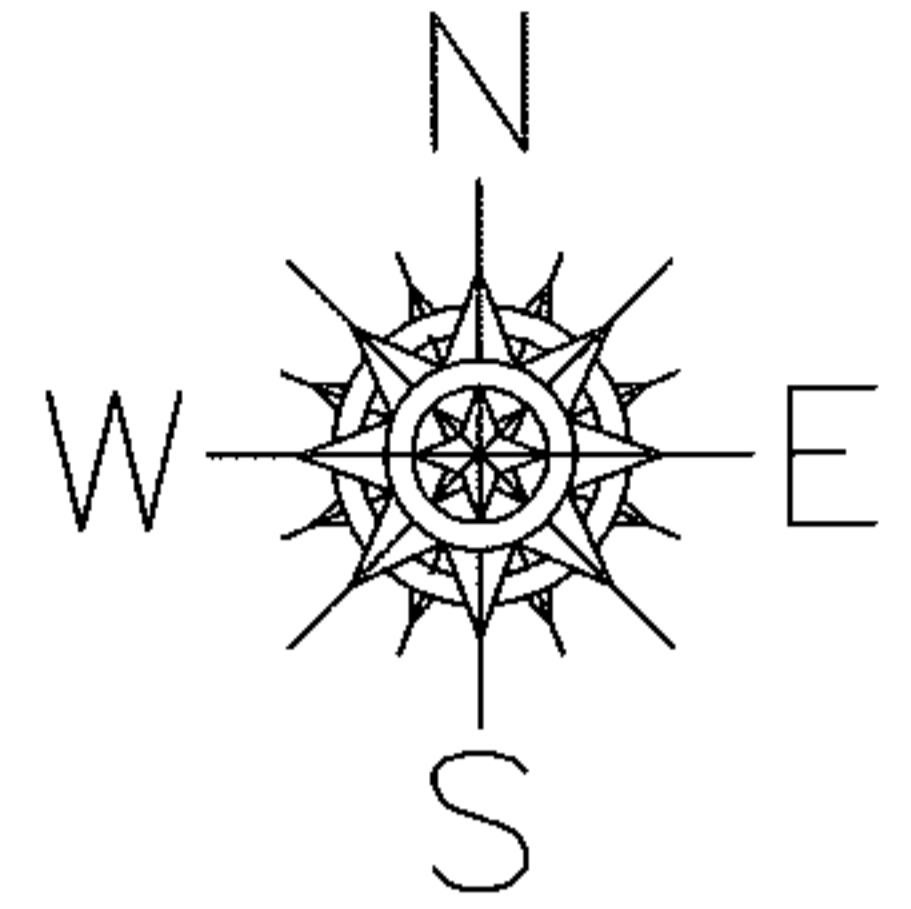

SPLITS/DEEDS PROCESSED

LORAIN COUNTY TAX MAP DEPARTMENT
226 MIDDLE AVE. ELYRIA, OHIO

SURVEYED BY: JAMES E. KARING

CLOSURE: .01:10,000

MAP PAGE(S): 3-00-002-A

APPROVED BY: RRM DATE: 11-27-13

SCALE: 1" = 200 PRIOR INST.: 20090302486