
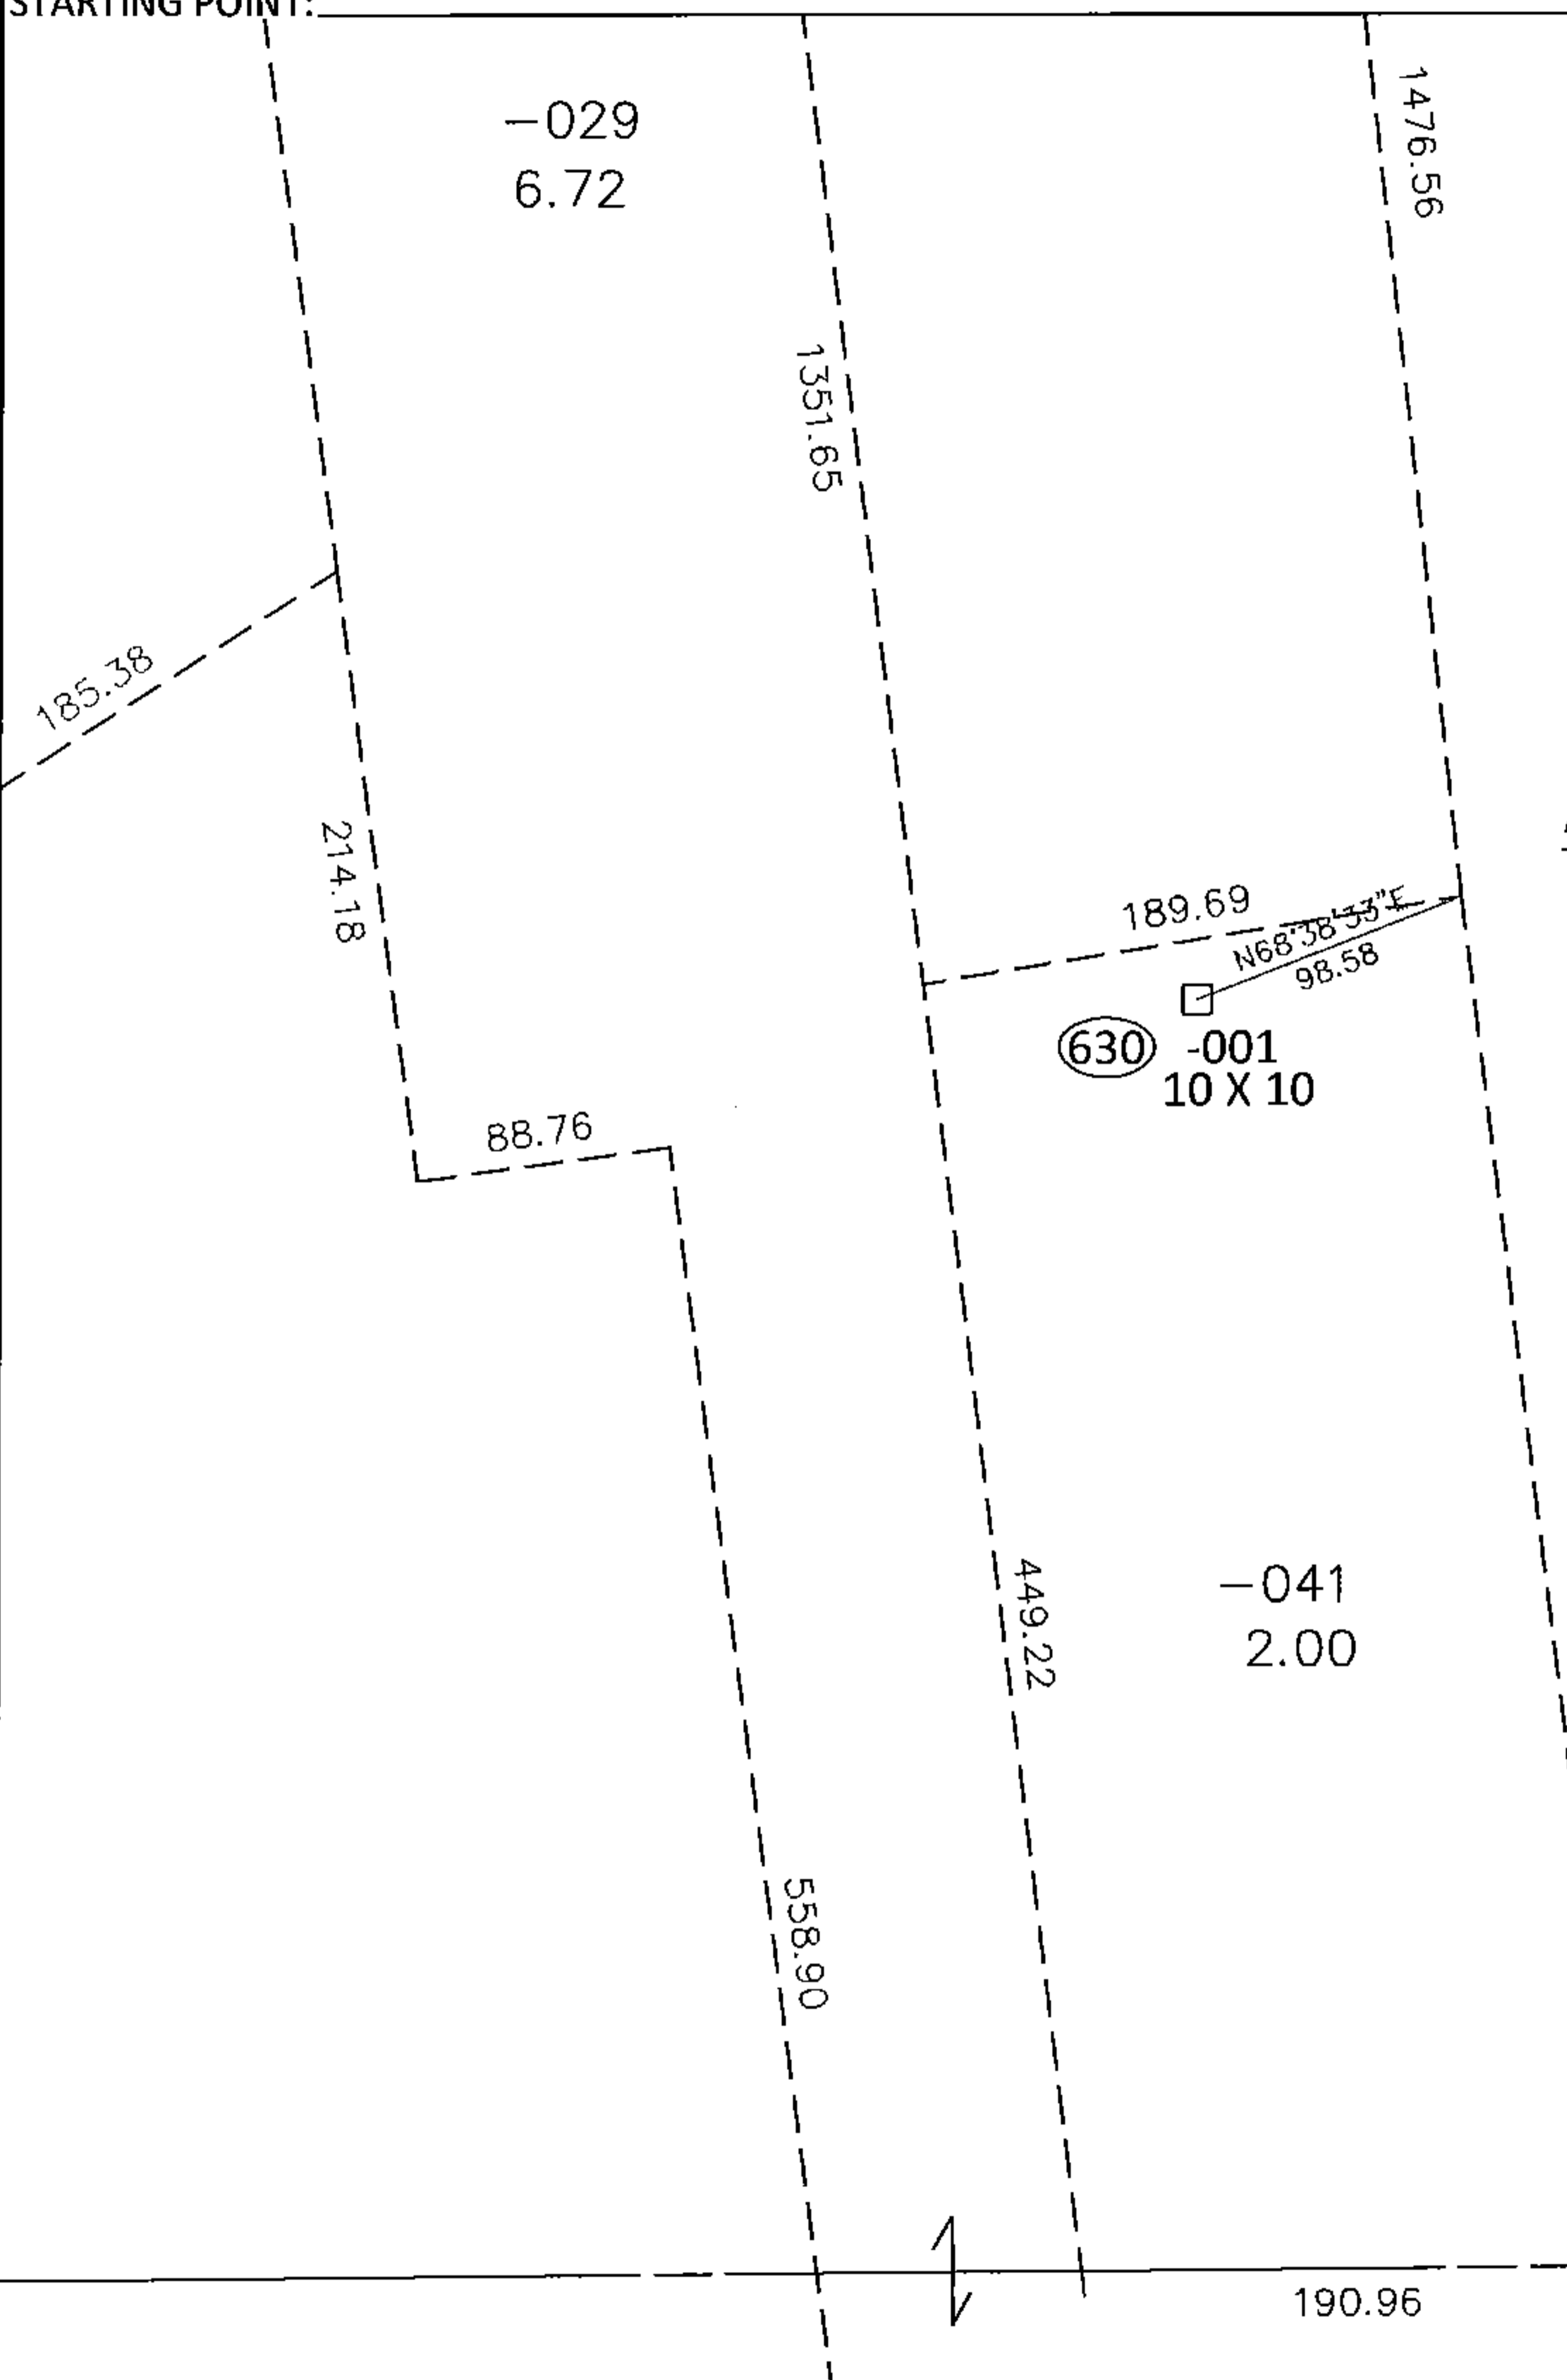


PARENT PARCEL: 12-00-048-000-041

CHILD PARCEL: 12-00-048-630-001

15-03212-A


STARTING POINT:

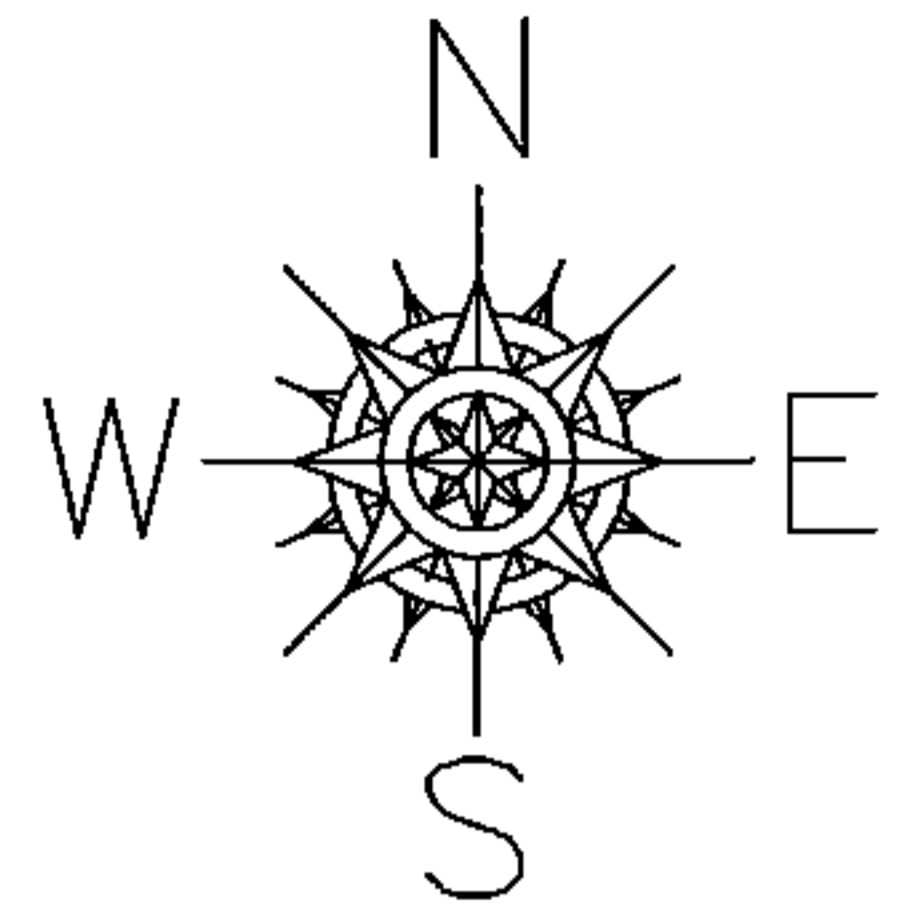

ADD TO DUPLICATE

12-00-048-630-001
10 X 10
API #34093212840

RM
4/12/16
47.71

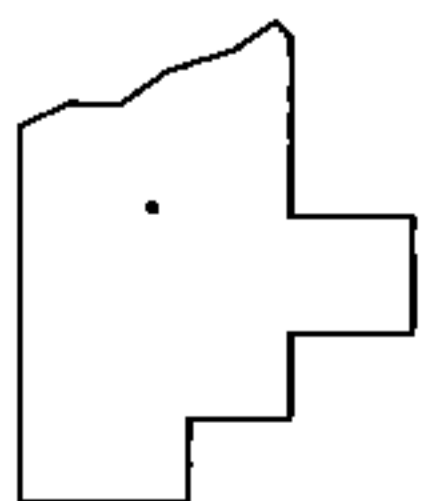

SPLITS/DEEDS PROCESSED

LORAIN COUNTY TAX MAP DEPARTMENT
226 MIDDLE AVE. ELYRIA, OHIO

SURVEYED BY: N/A
CLOSURE: N/A
MAP PAGE(S): 12-00-048-A
APPROVED BY: RRM DATE: 5-18-15
SCALE: 1"= 100 PRIOR INST.: _____