


PARENT PARCEL: 12-00-048-000-038

CHILD PARCEL: 12-00-048-630-005

15-03213-A

STARTING POINT:

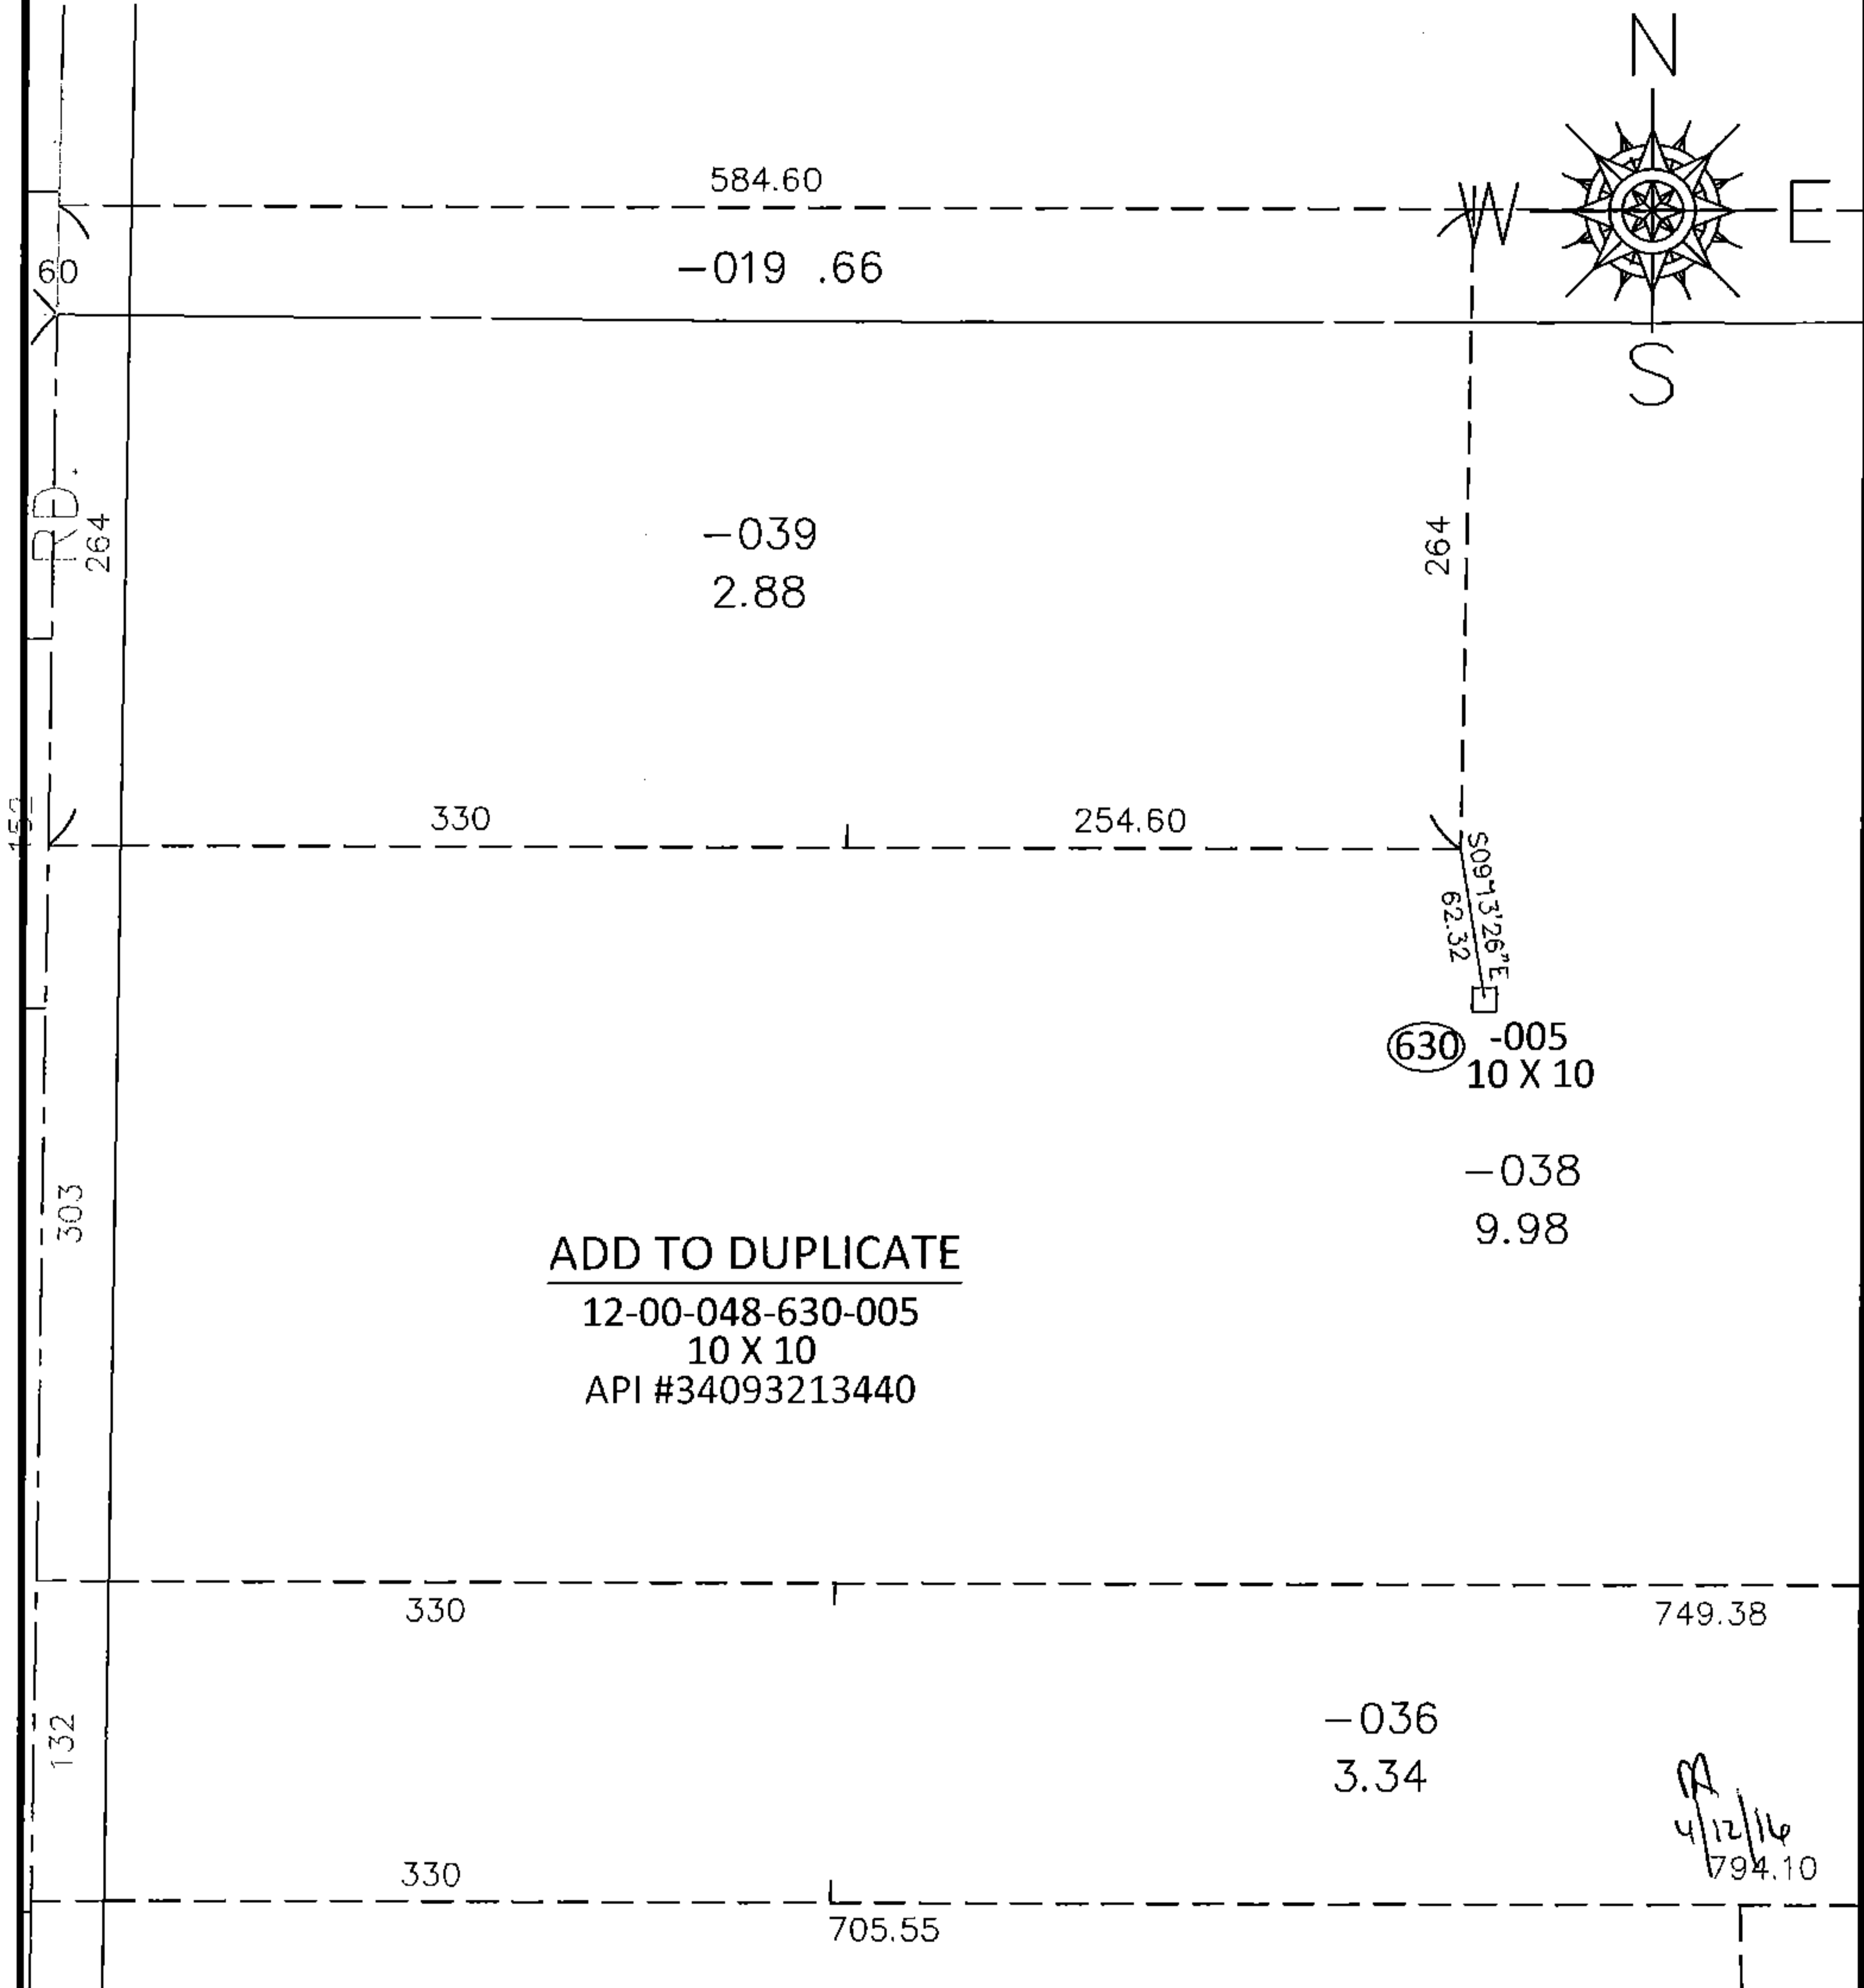

ADD TO DUPLICATE


12-00-048-630-005
10 X 10
API #34093213440

(630) -005
10 X 10

-038
9.98

-036
3.34

RM
4/12/16
794.10

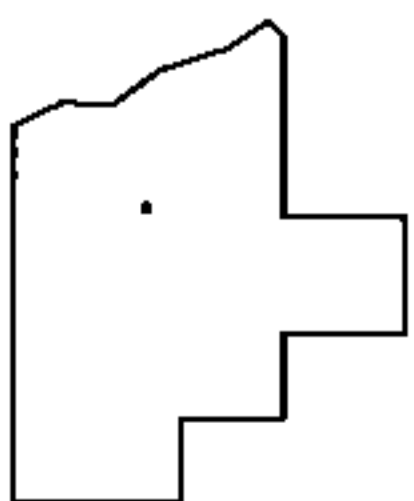

SPLITS/DEEDS PROCESSED

LORAIN COUNTY TAX MAP DEPARTMENT
226 MIDDLE AVE. ELYRIA, OHIO

SURVEYED BY: N/A
CLOSURE: N/A
MAP PAGE(S): 12-00-048-A
APPROVED BY: RRM DATE: 5-18-15
SCALE: 1"= 100 PRIOR INST.: