


PARENT PARCEL: 12-00-061-000-015, -051

CHILD PARCEL: 12-00-061-000-090

STARTING POINT: CENTERLINE OF SPRAGUE RD & SIDELINE OF STATION RD.

14-03215

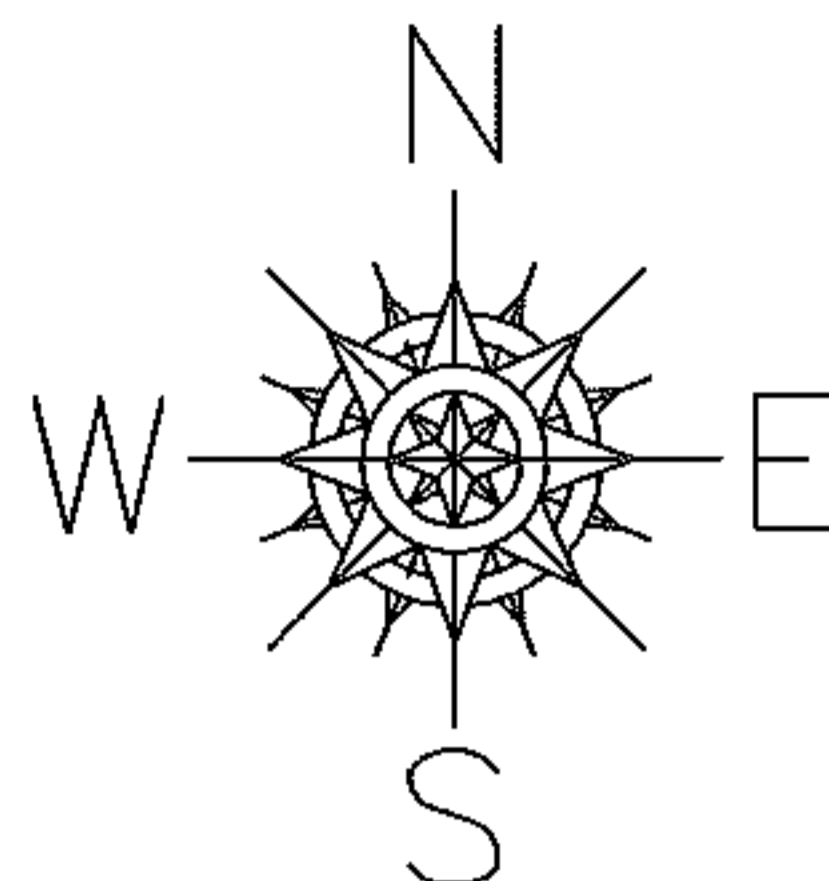

SPRAGUE RD

STATION RD

1176.96

236.00

536.43

537.60

~~1.84 A.~~

~~1.06 A.~~

1.090

~~2.90 A.~~

2.91 A.

A CORR SURVEY  
GEORGE HOFFMAN

~~0.51~~

~~0.15~~

235.99

SPLITS/DEEDS PROCESSED

LORAIN COUNTY TAX MAP DEPARTMENT  
226 MIDDLE AVE. ELYRIA, OHIO

SURVEYED BY: GEORGE HOFFMAN

CLOSURE: 0.00 : 10,000

MAP PAGE(S): 12-00-061-B

APPROVED BY: JAH DATE: 1-10-2014

SCALE: 1" = 100 PRIOR INSTRUMENT: 20120425527