
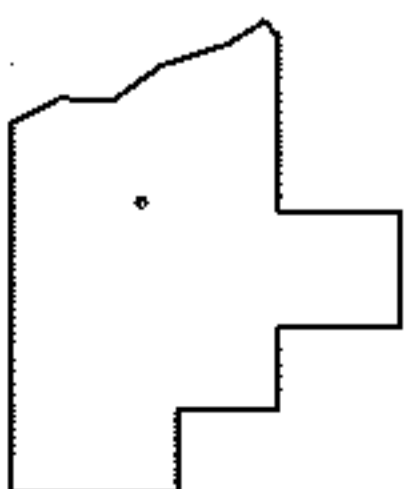
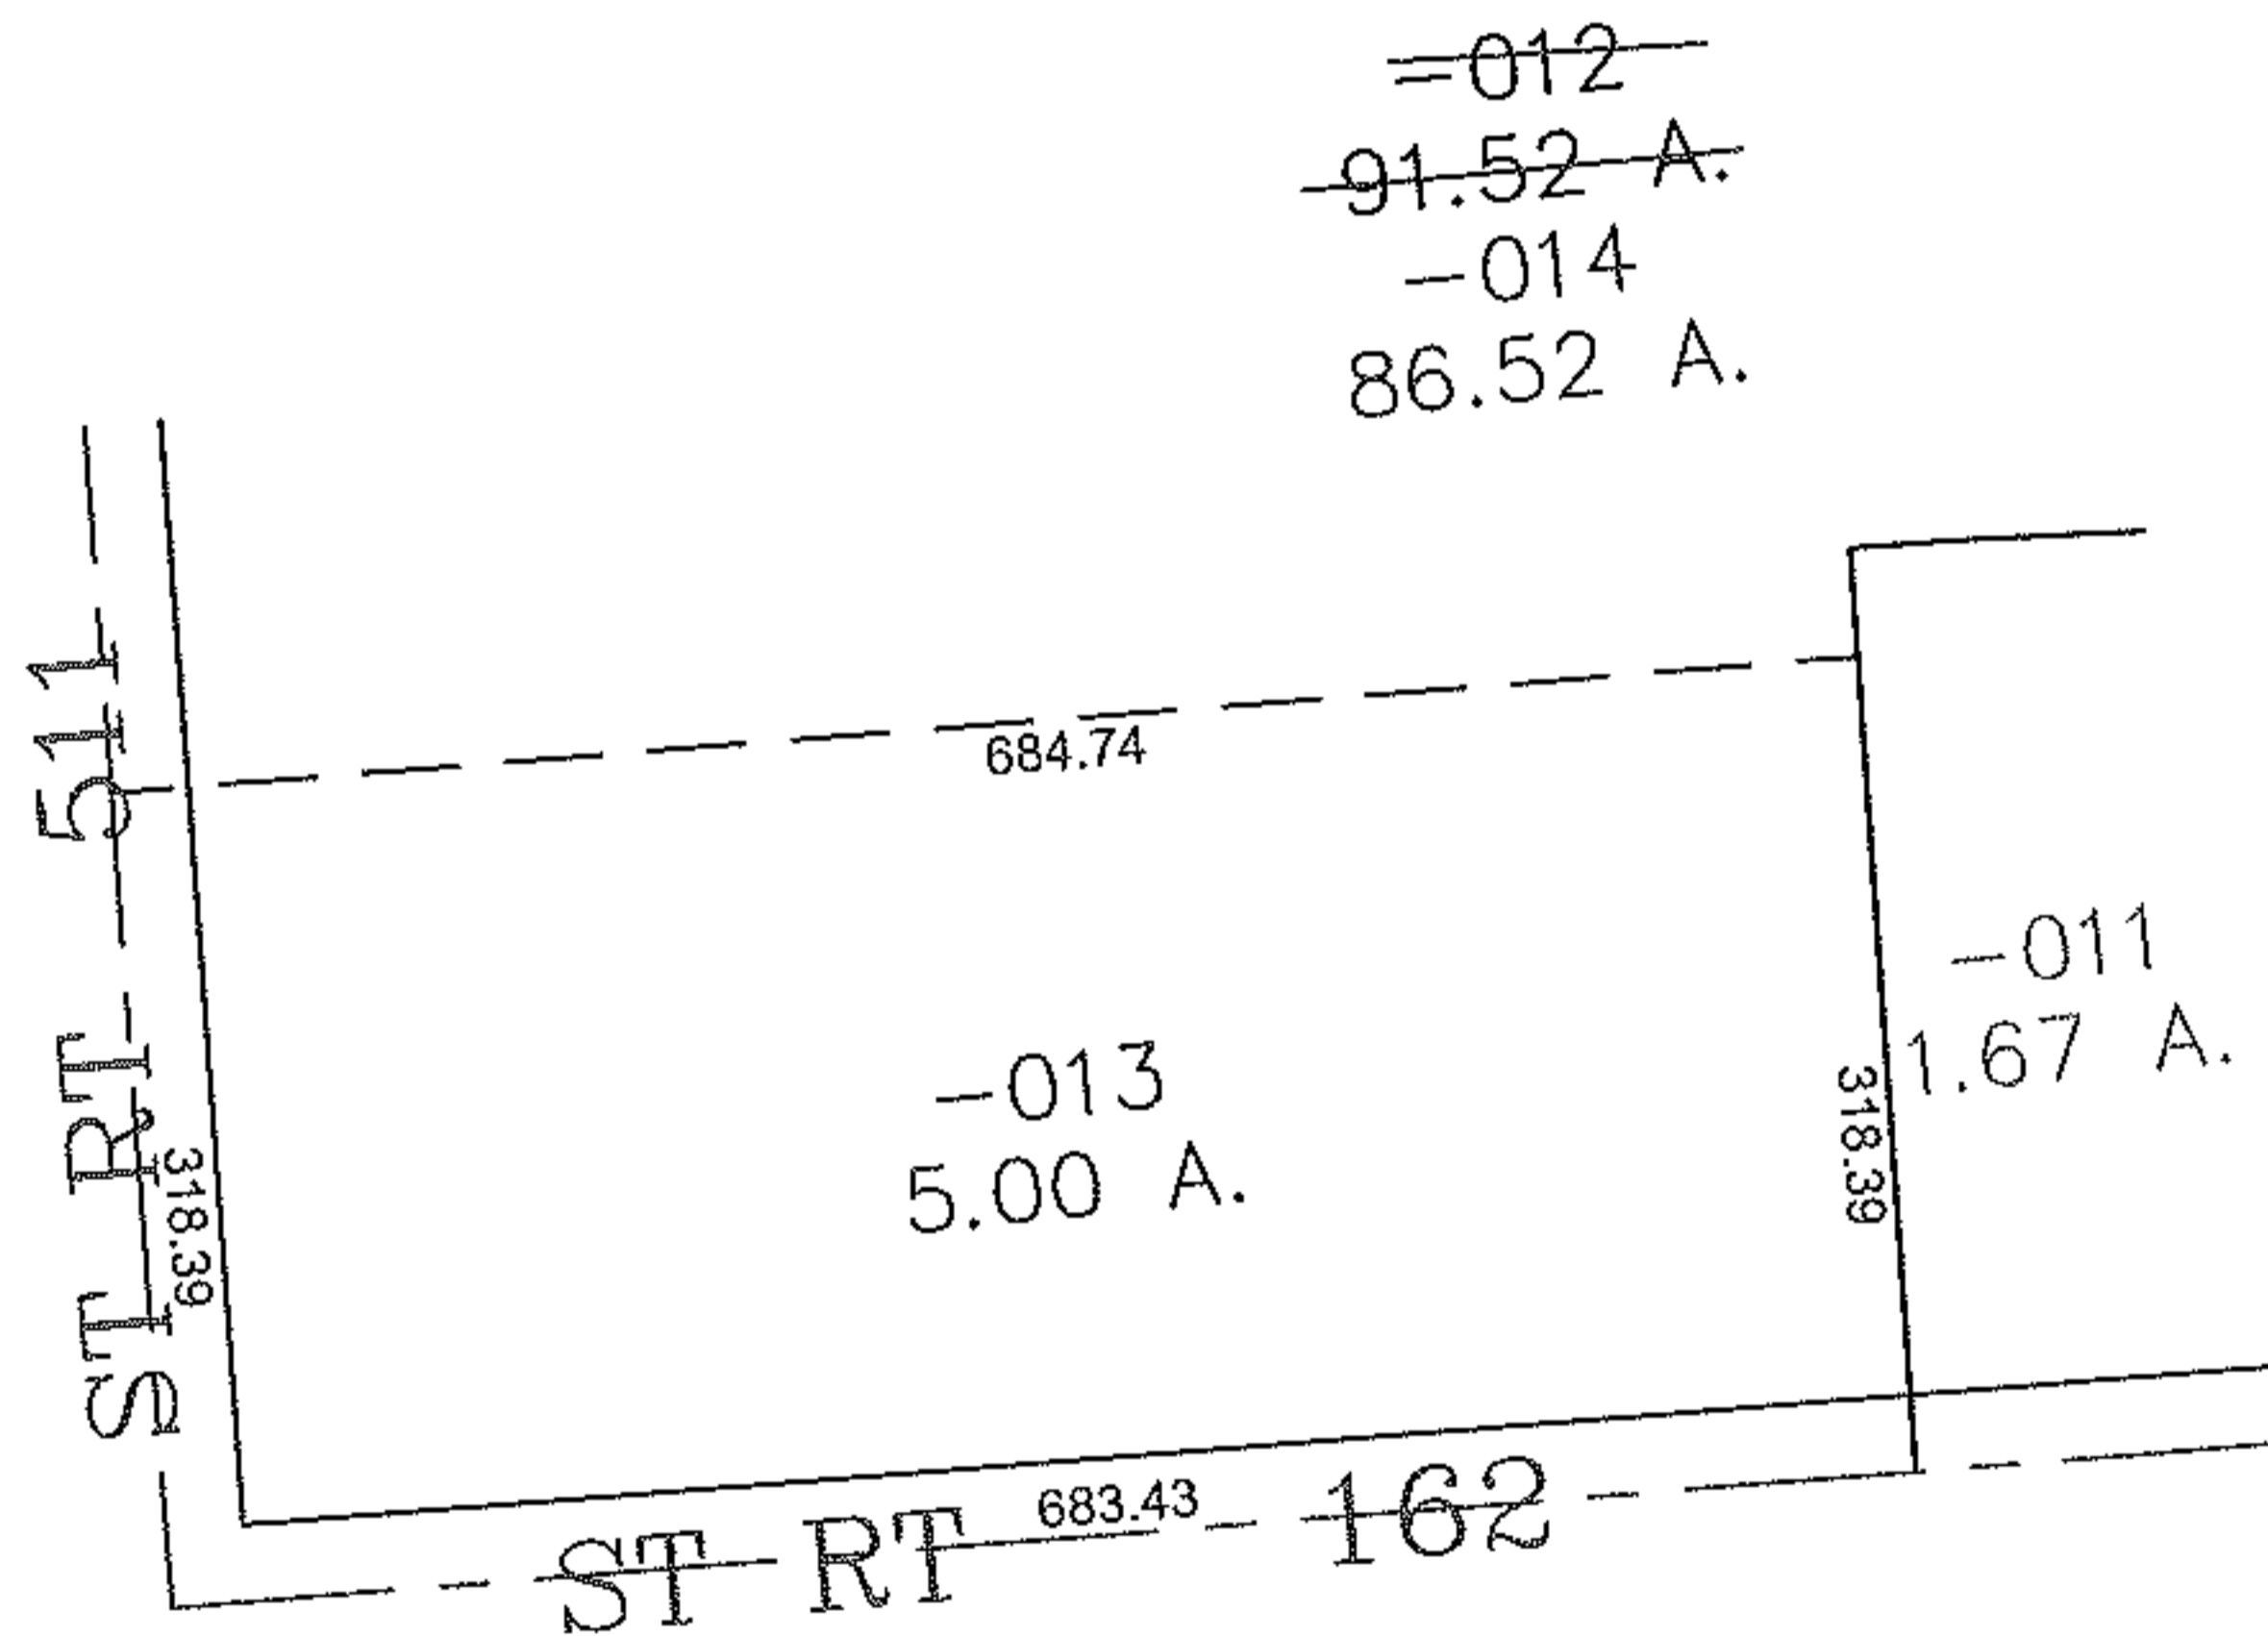


PARENT PARCEL: 20-05-013-000-012

CHILD PARCEL: 20-05-013-000-013, -014

STARTING POINT: CENTERLINE OF ST RT 511 & ST RT 162

14-03216

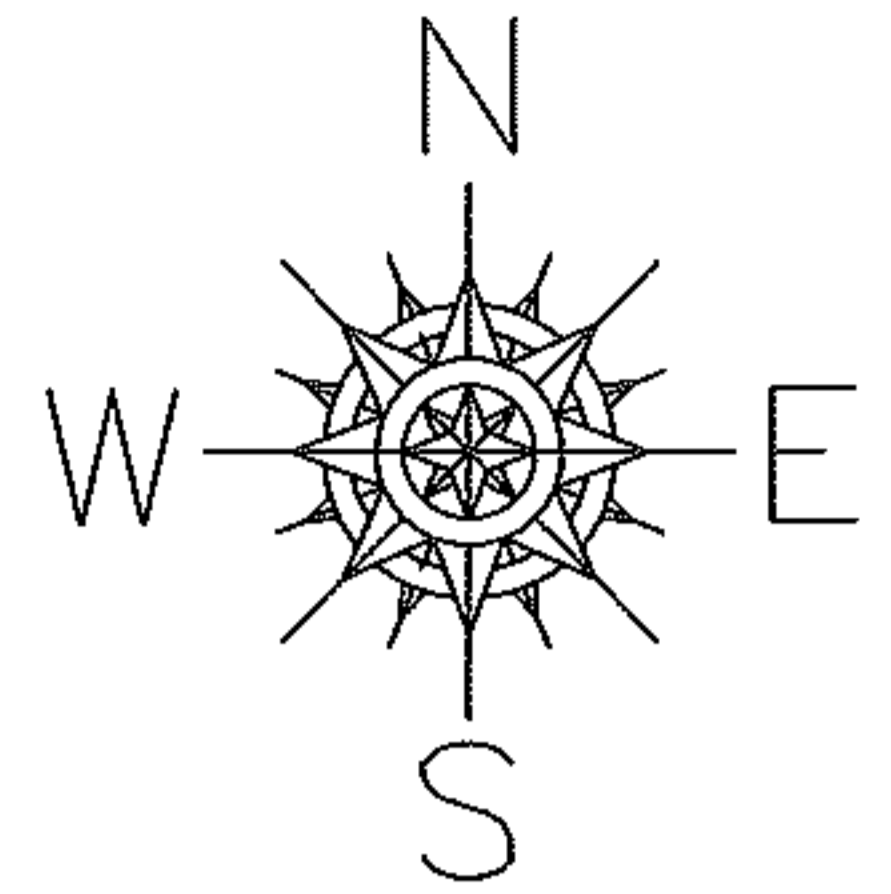

**SPLITS/DEEDS PROCESSED**  
 LORAIN COUNTY TAX MAP DEPARTMENT  
 226 MIDDLE AVE. ELYRIA, OHIO

SURVEYED BY: RICHARD CARLSON  
 CLOSURE: 0.00 : 10,000  
 MAP PAGE(S): 20-A  
 APPROVED BY: JAH DATE: 1/10/2014  
 SCALE: 1" = 200 PRIOR INSTRUMENT: 20120413936