


PARENT PARCEL: 12-00-054-000-040

CHILD PARCEL: 12-00-054-630-007

15-03219-A

STARTING POINT:

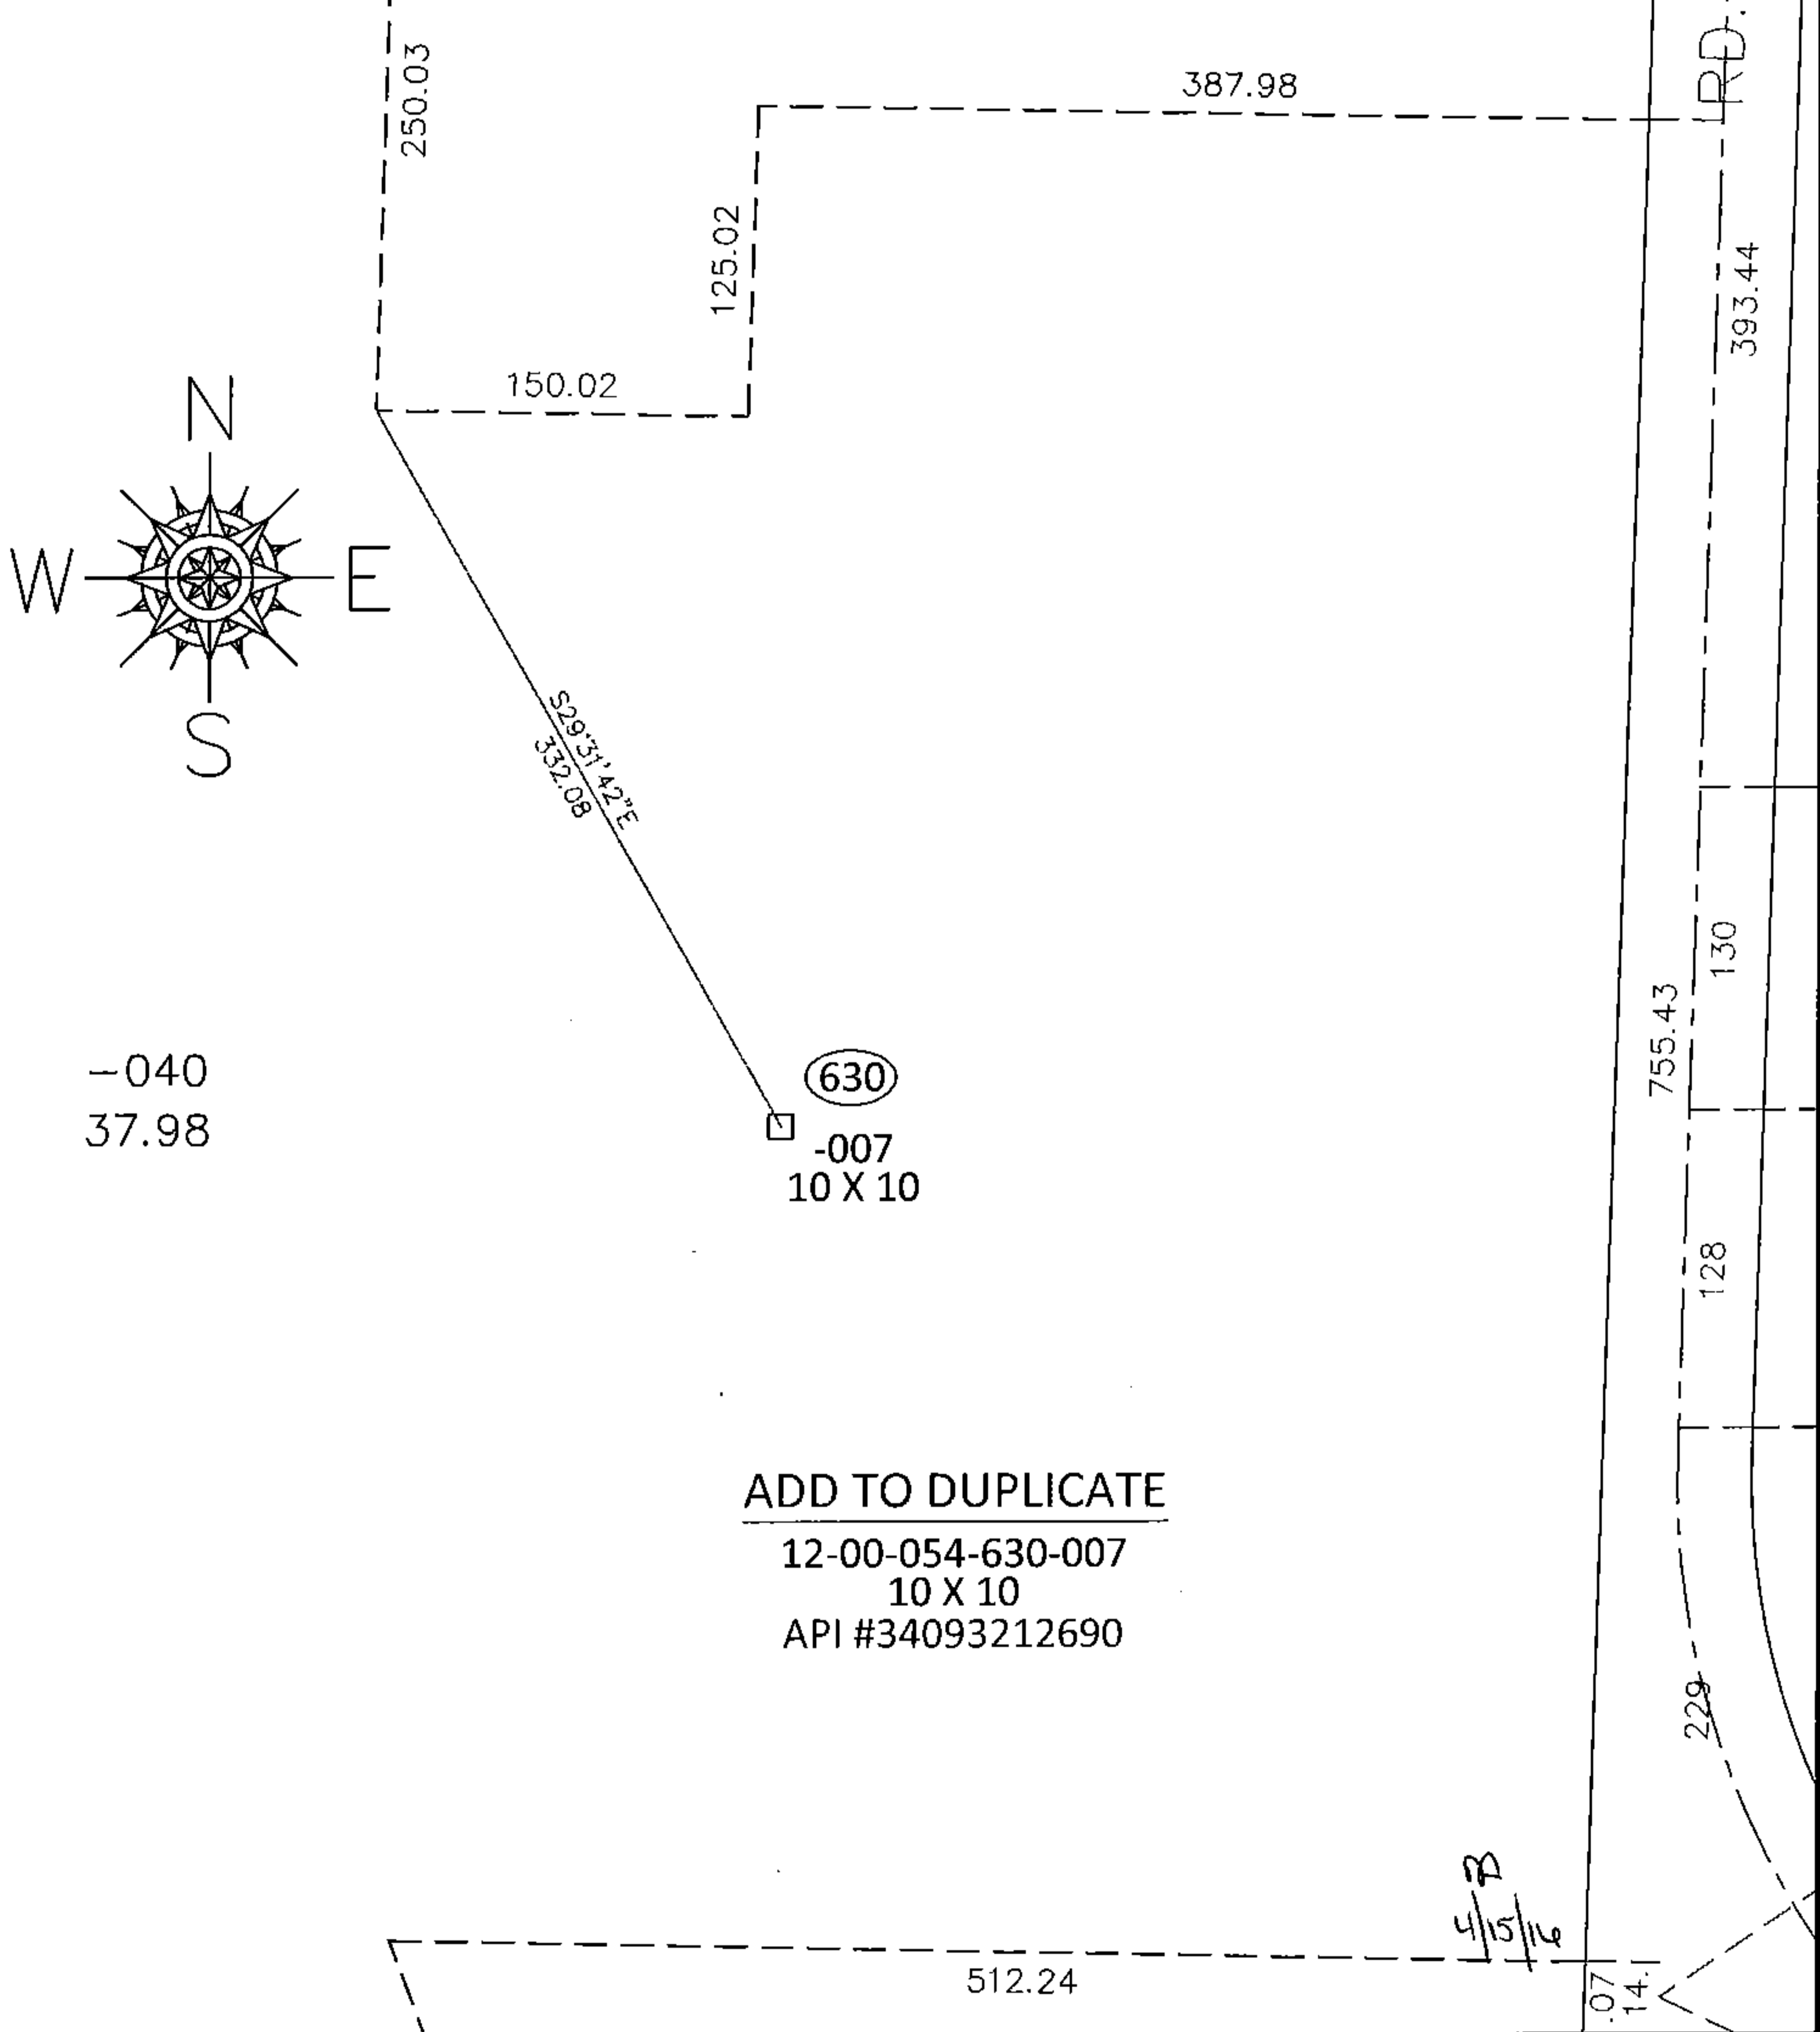


-040
37.98

(630)
-007
10 X 10

ADD TO DUPLICATE

12-00-054-630-007
10 X 10
API #34093212690

RR
4/15/16

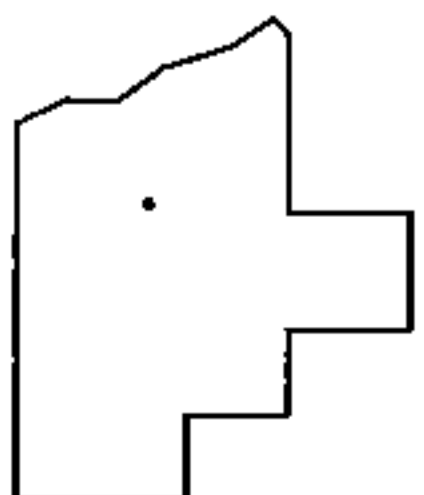

SPLITS/DEEDS PROCESSED

LORAIN COUNTY TAX MAP DEPARTMENT
226 MIDDLE AVE. ELYRIA, OHIO

SURVEYED BY:	N/A
CLOSURE:	N/A
MAP PAGE(S):	12-00-054-A
APPROVED BY:	RRM DATE: 5-20-15
SCALE:	1"= 100 PRIOR INST.: