
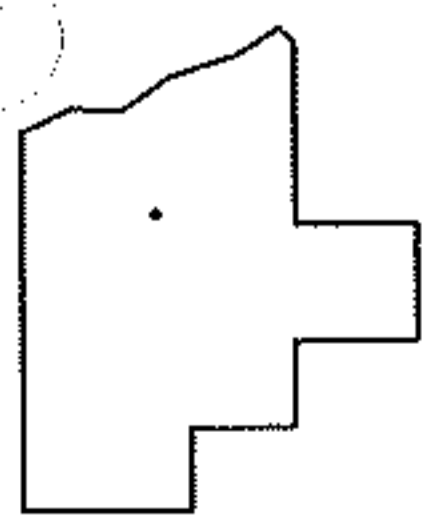
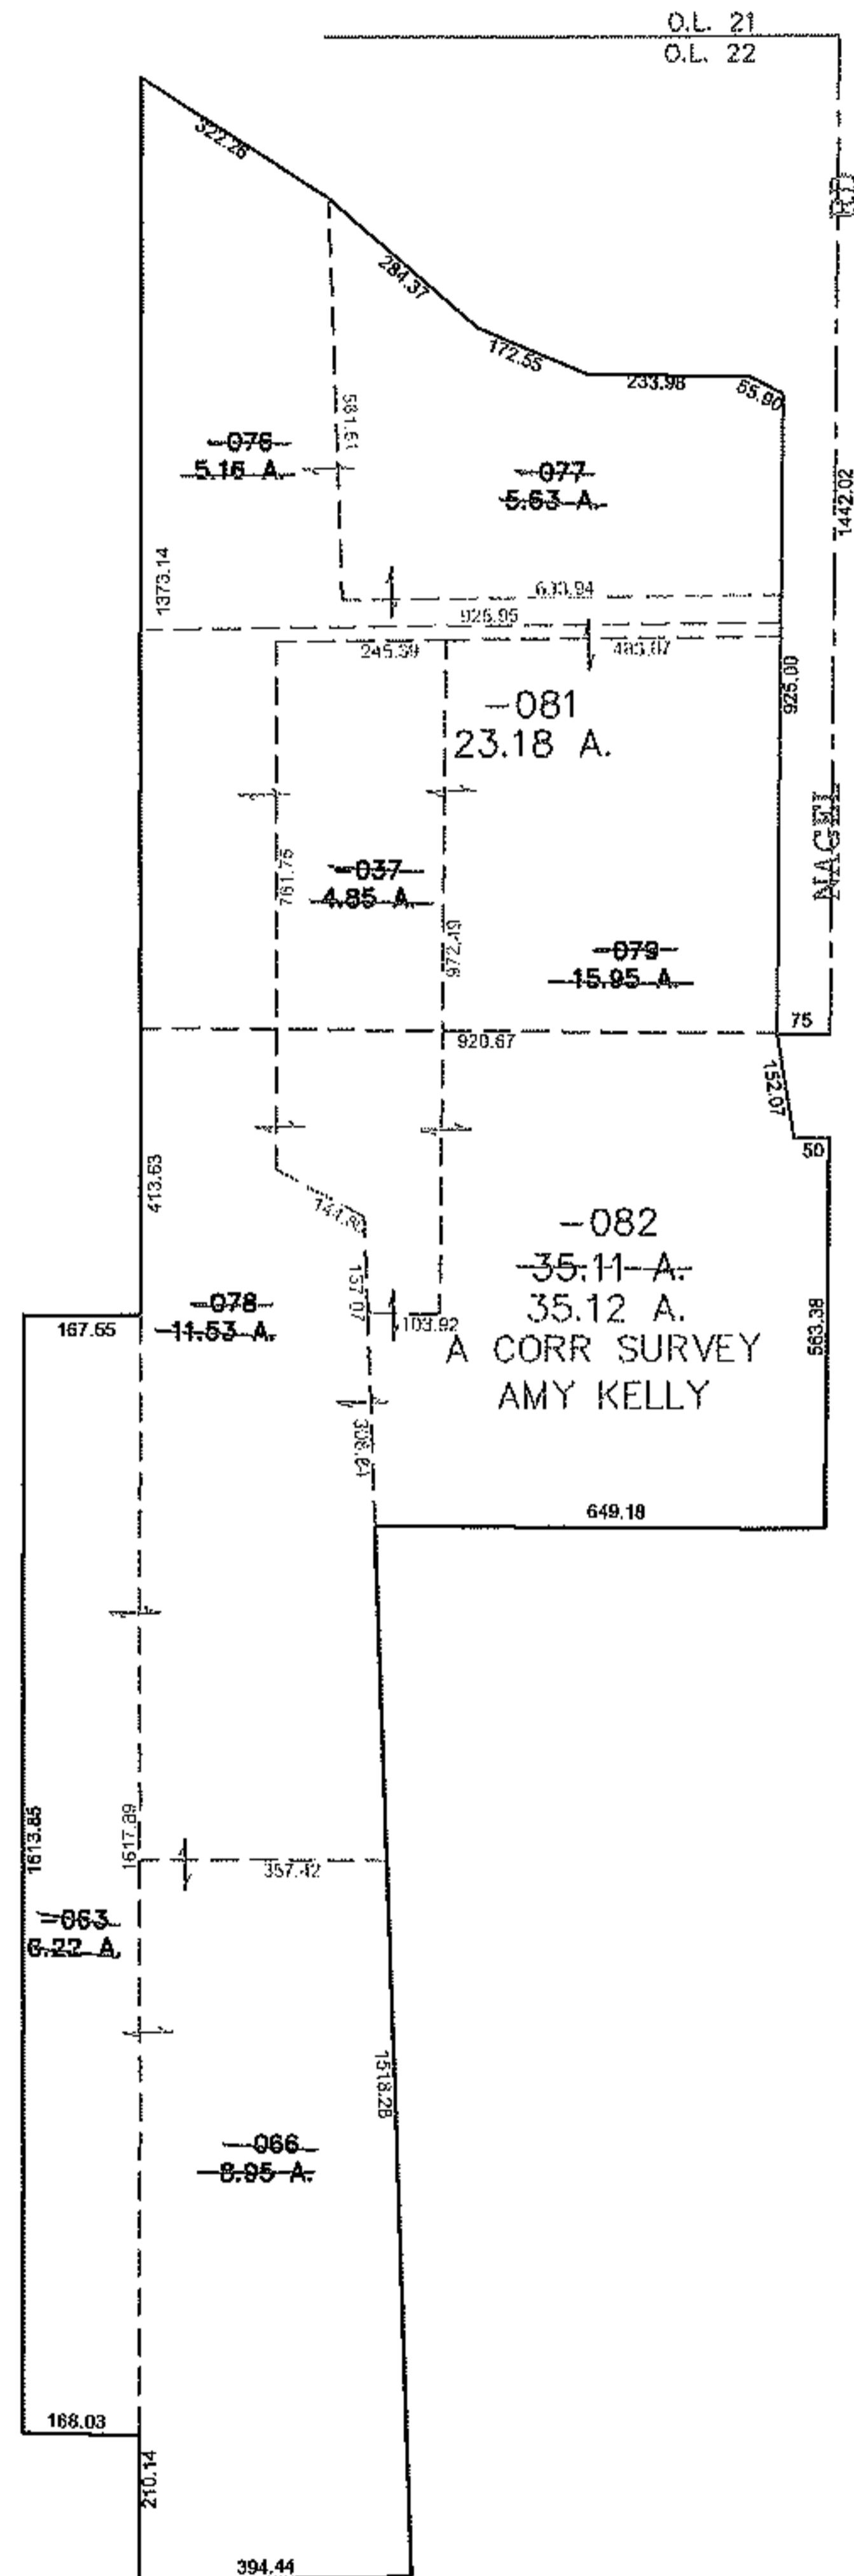


PARENT PARCEL: 04-00-022-102-079, -077, -037, -076, -078, -063, -066

CHILD PARCEL: 04-00-022-102-081, -082

STARTING POINT: CENTERLINE OF NAGEL RD & O.L. 22

14-03221

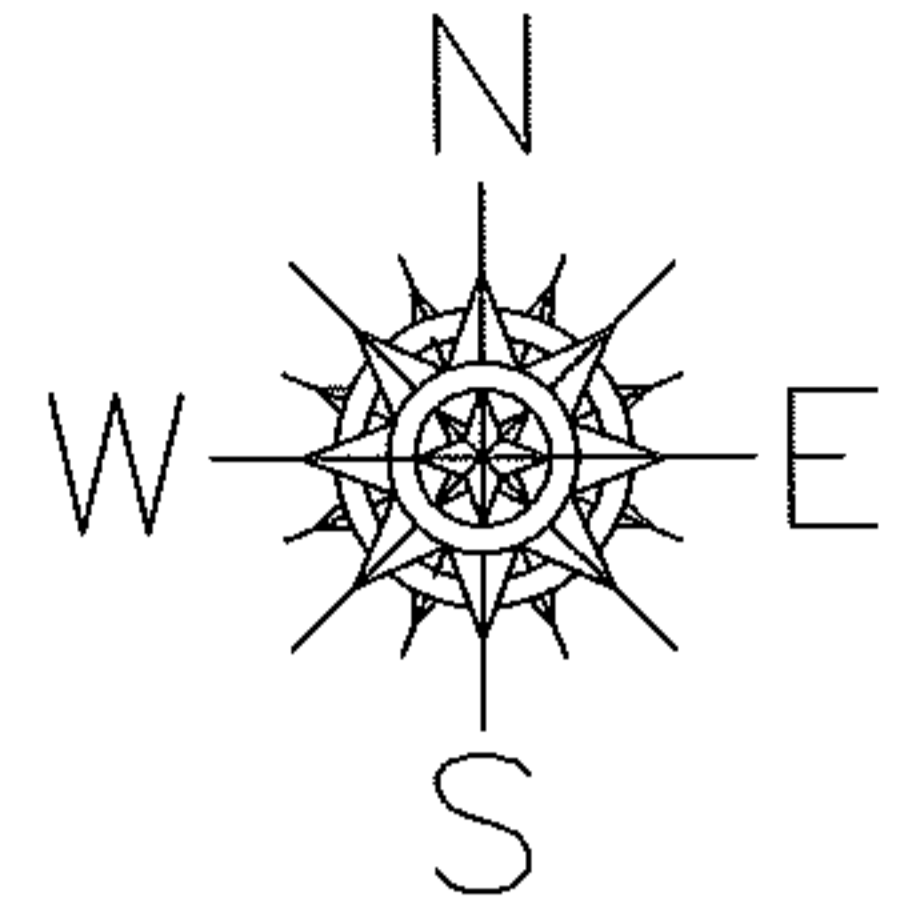

SPLITS/DEEDS PROCESSED

LORAIN COUNTY TAX MAP DEPARTMENT
226 MIDDLE AVE. ELYRIA, OHIO

SURVEYED BY: AMY KELLY
CLOSURE: 0.00 : 10,000
MAP PAGE(S): 04-00-022-H
APPROVED BY: JAH DATE: 1/24/2014
SCALE: 1" = 500 PRIOR INST.: 20120417909