
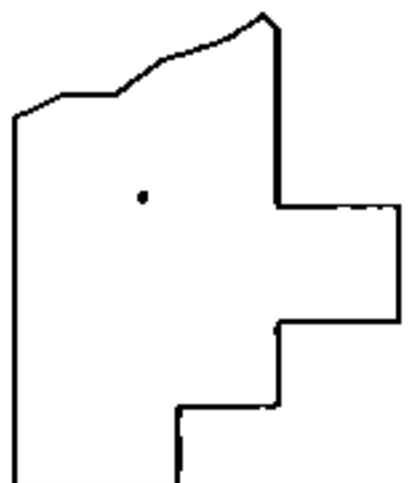
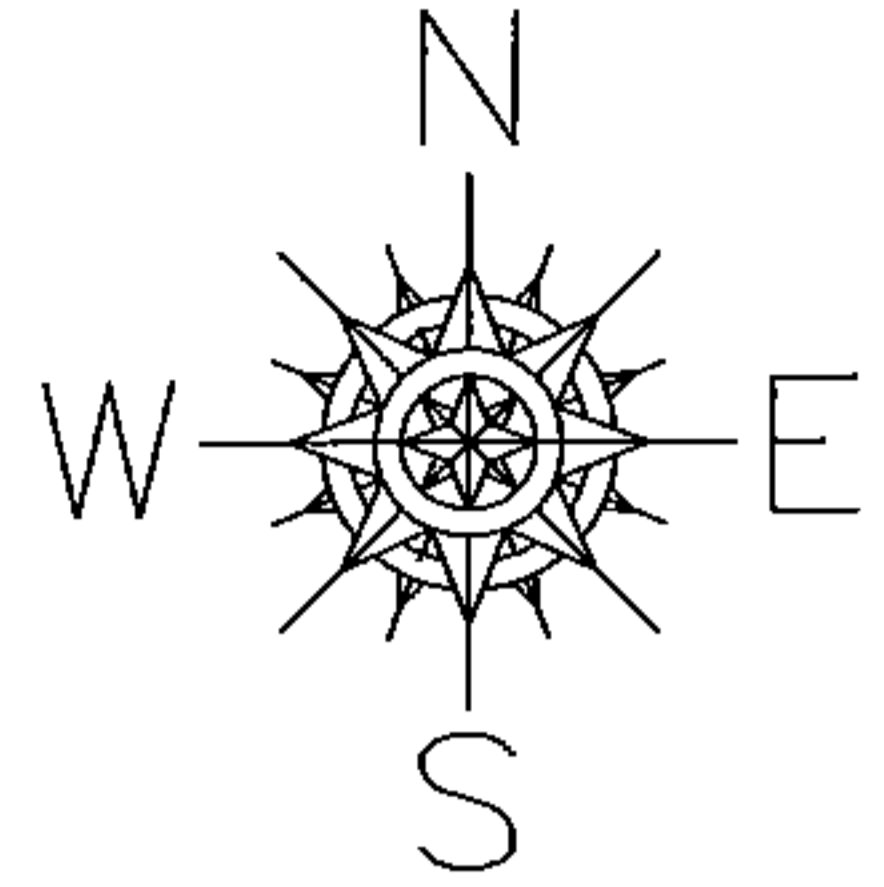


PARENT PARCEL: 15-00-044-000-006, -007

CHILD PARCEL: SAME

STARTING POINT: CENTERLINE OF WHITEHEAD RD & O.L. 44

15-03223-A

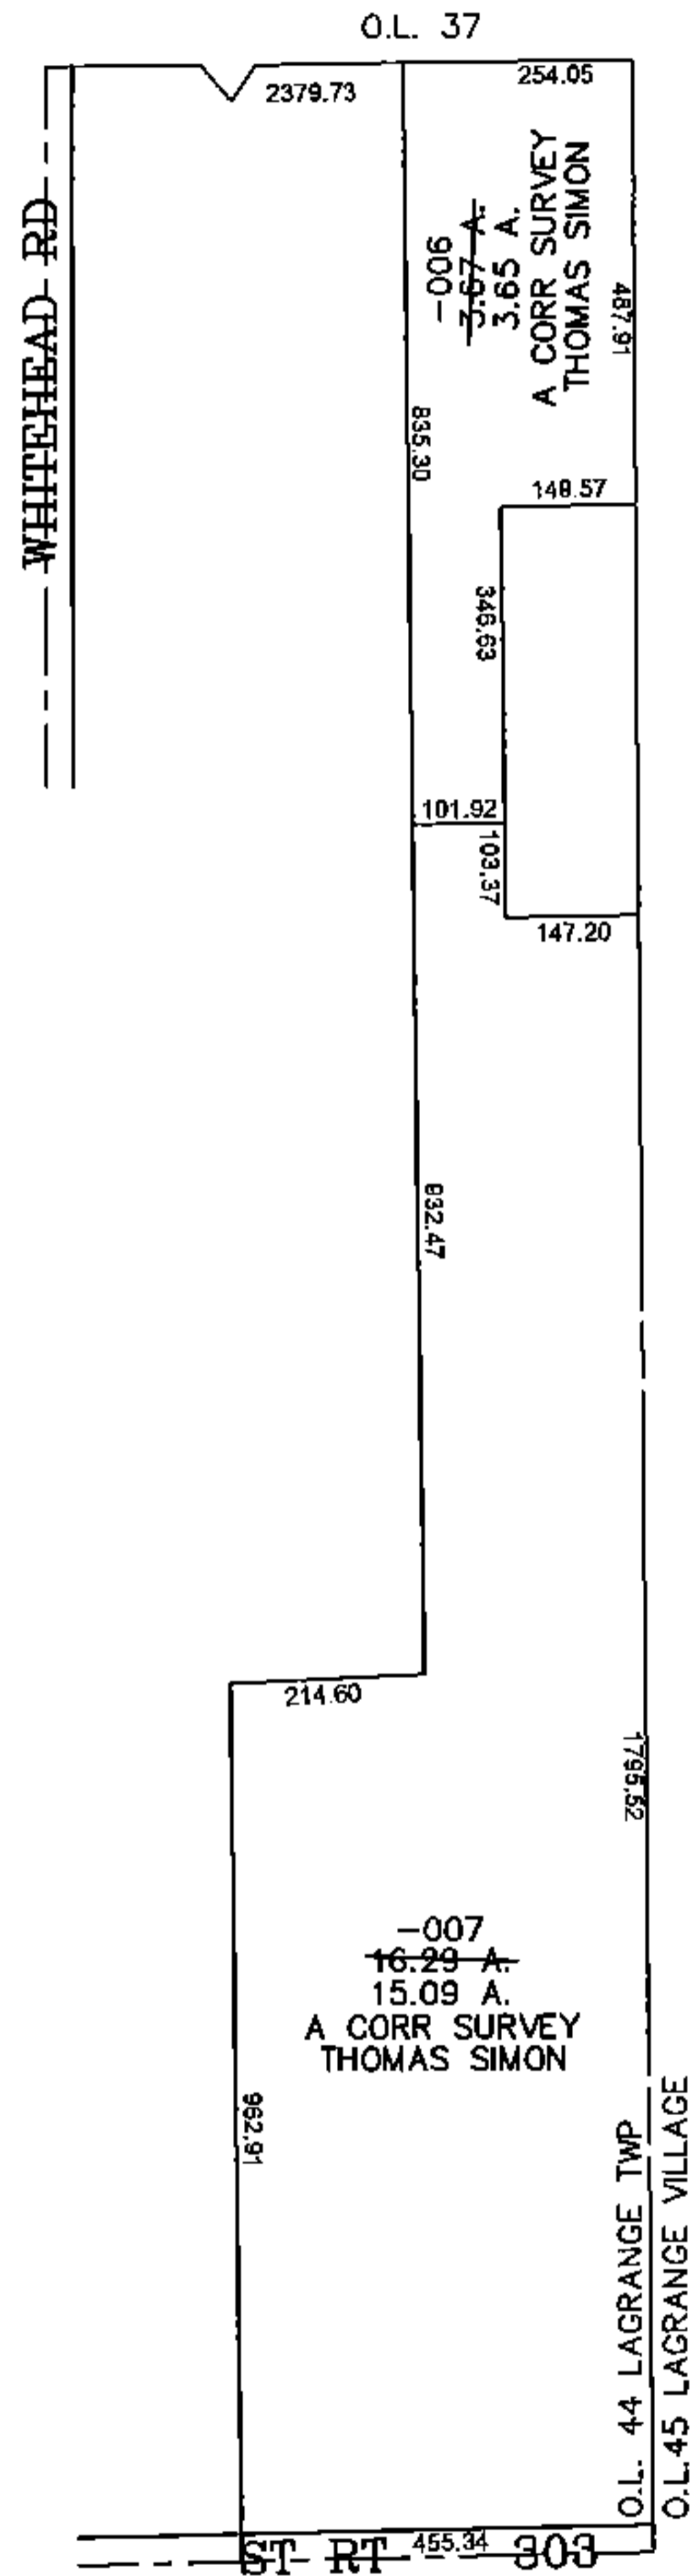

SPLITS/DEEDS PROCESSED

LORAIN COUNTY TAX MAP DEPARTMENT
226 MIDDLE AVE. ELYRIA, OHIO

SURVEYED BY: THOMAS SIMON

CLOSURE: 0.00 : 10,000

MAP PAGE(S): 15-00-044-A

APPROVED BY: JAH DATE: 5-28-2015

SCALE: 1"= 400 PRIOR INST.: 19900111970