


PARENT PARCEL: 15-00-038-000-006

CHILD PARCEL: SAME

STARTING POINT: CENTERLINE OF BIGGS RD & WHITEHEAD RD

15-03224-A

--- BIGGS --- RD ---

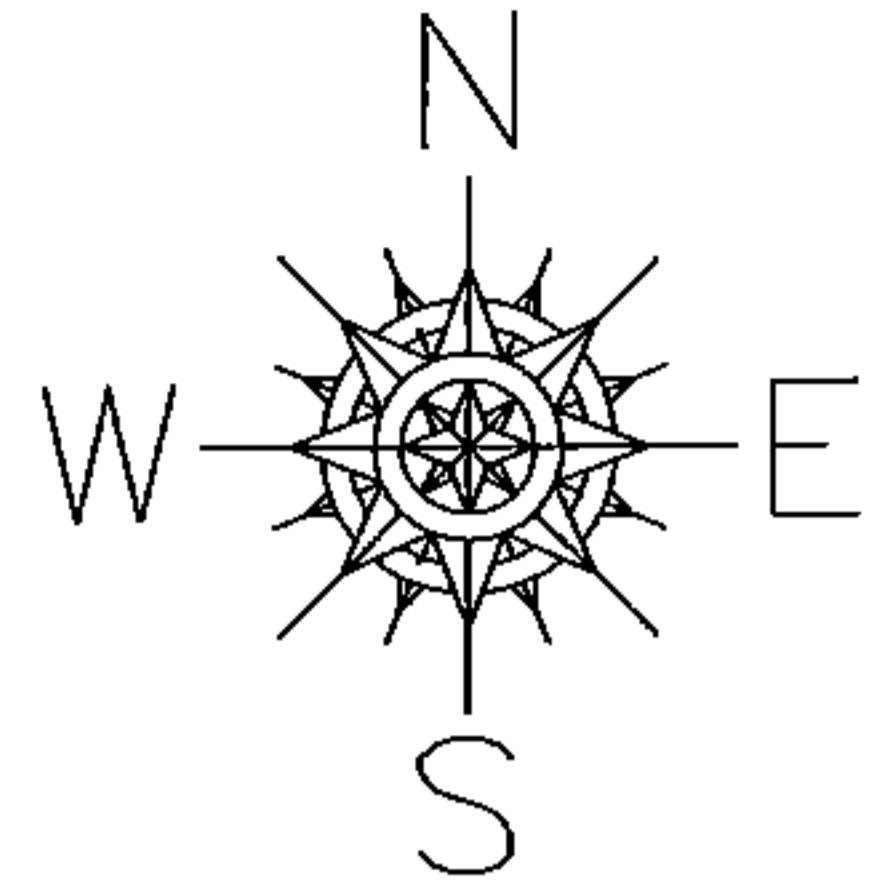

1458.78

RD

1003.03


1321.86

-006
~~30.17~~ A.
30.40 A.
A CORR SURVEY
THOMAS SIMON

1317.81

WHITEHEAD

1003.70

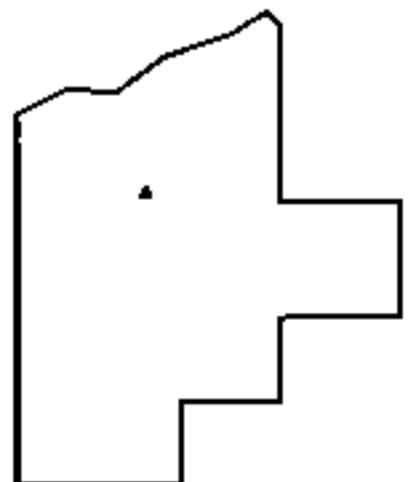

SPLITS/DEEDS PROCESSED
LORAIN COUNTY TAX MAP DEPARTMENT
226 MIDDLE AVE. ELYRIA, OHIO

SURVEYED BY: THOMAS SIMON
CLOSURE: 0.00 : 10.000
MAP PAGE(S): 15-00-038-A
APPROVED BY: JAH DATE: 5/28/2015
SCALE: 1" = 200 PRIOR INSTRUMENT: 19900111970