
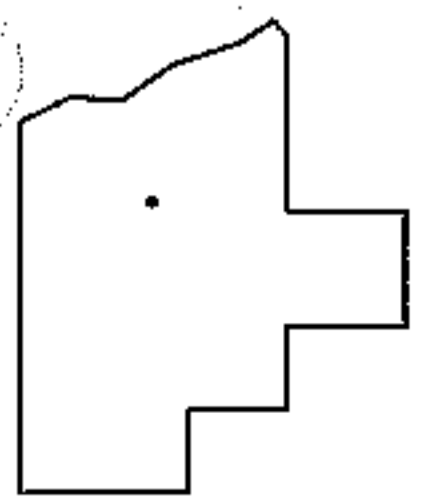
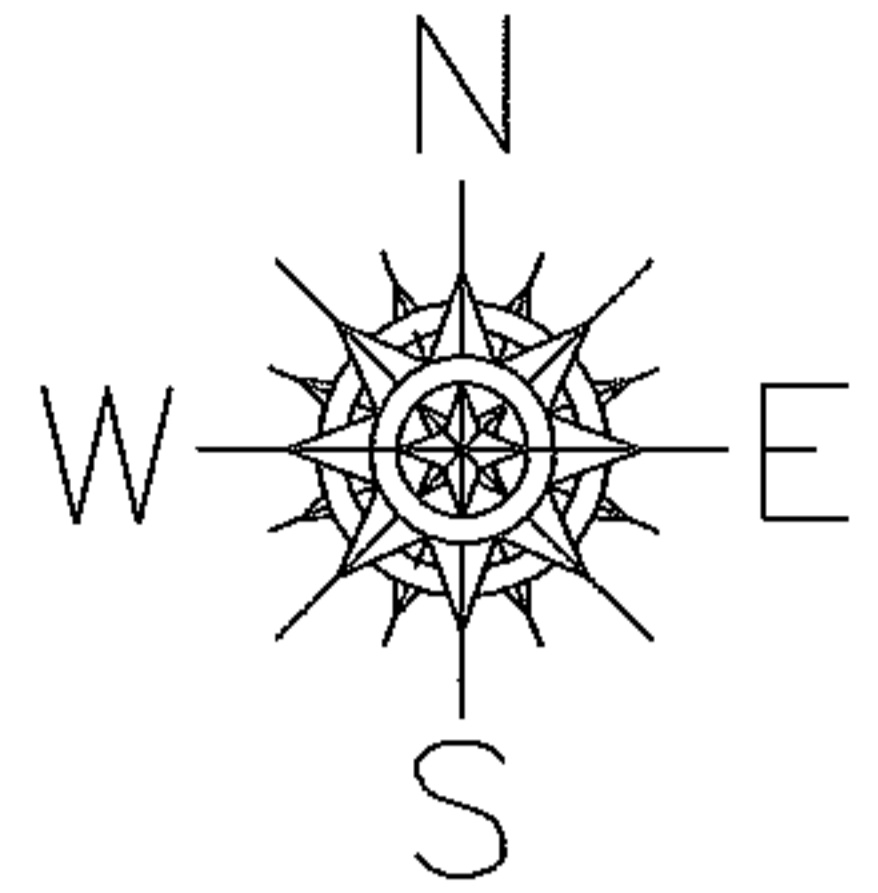


PARENT PARCEL: 03-00-053-108-029

CHILD PARCEL: 03-00-053-108-031, -032

STARTING POINT: CENTERLINE OF HENDERSON DR & COLORADO AVE

14-03225

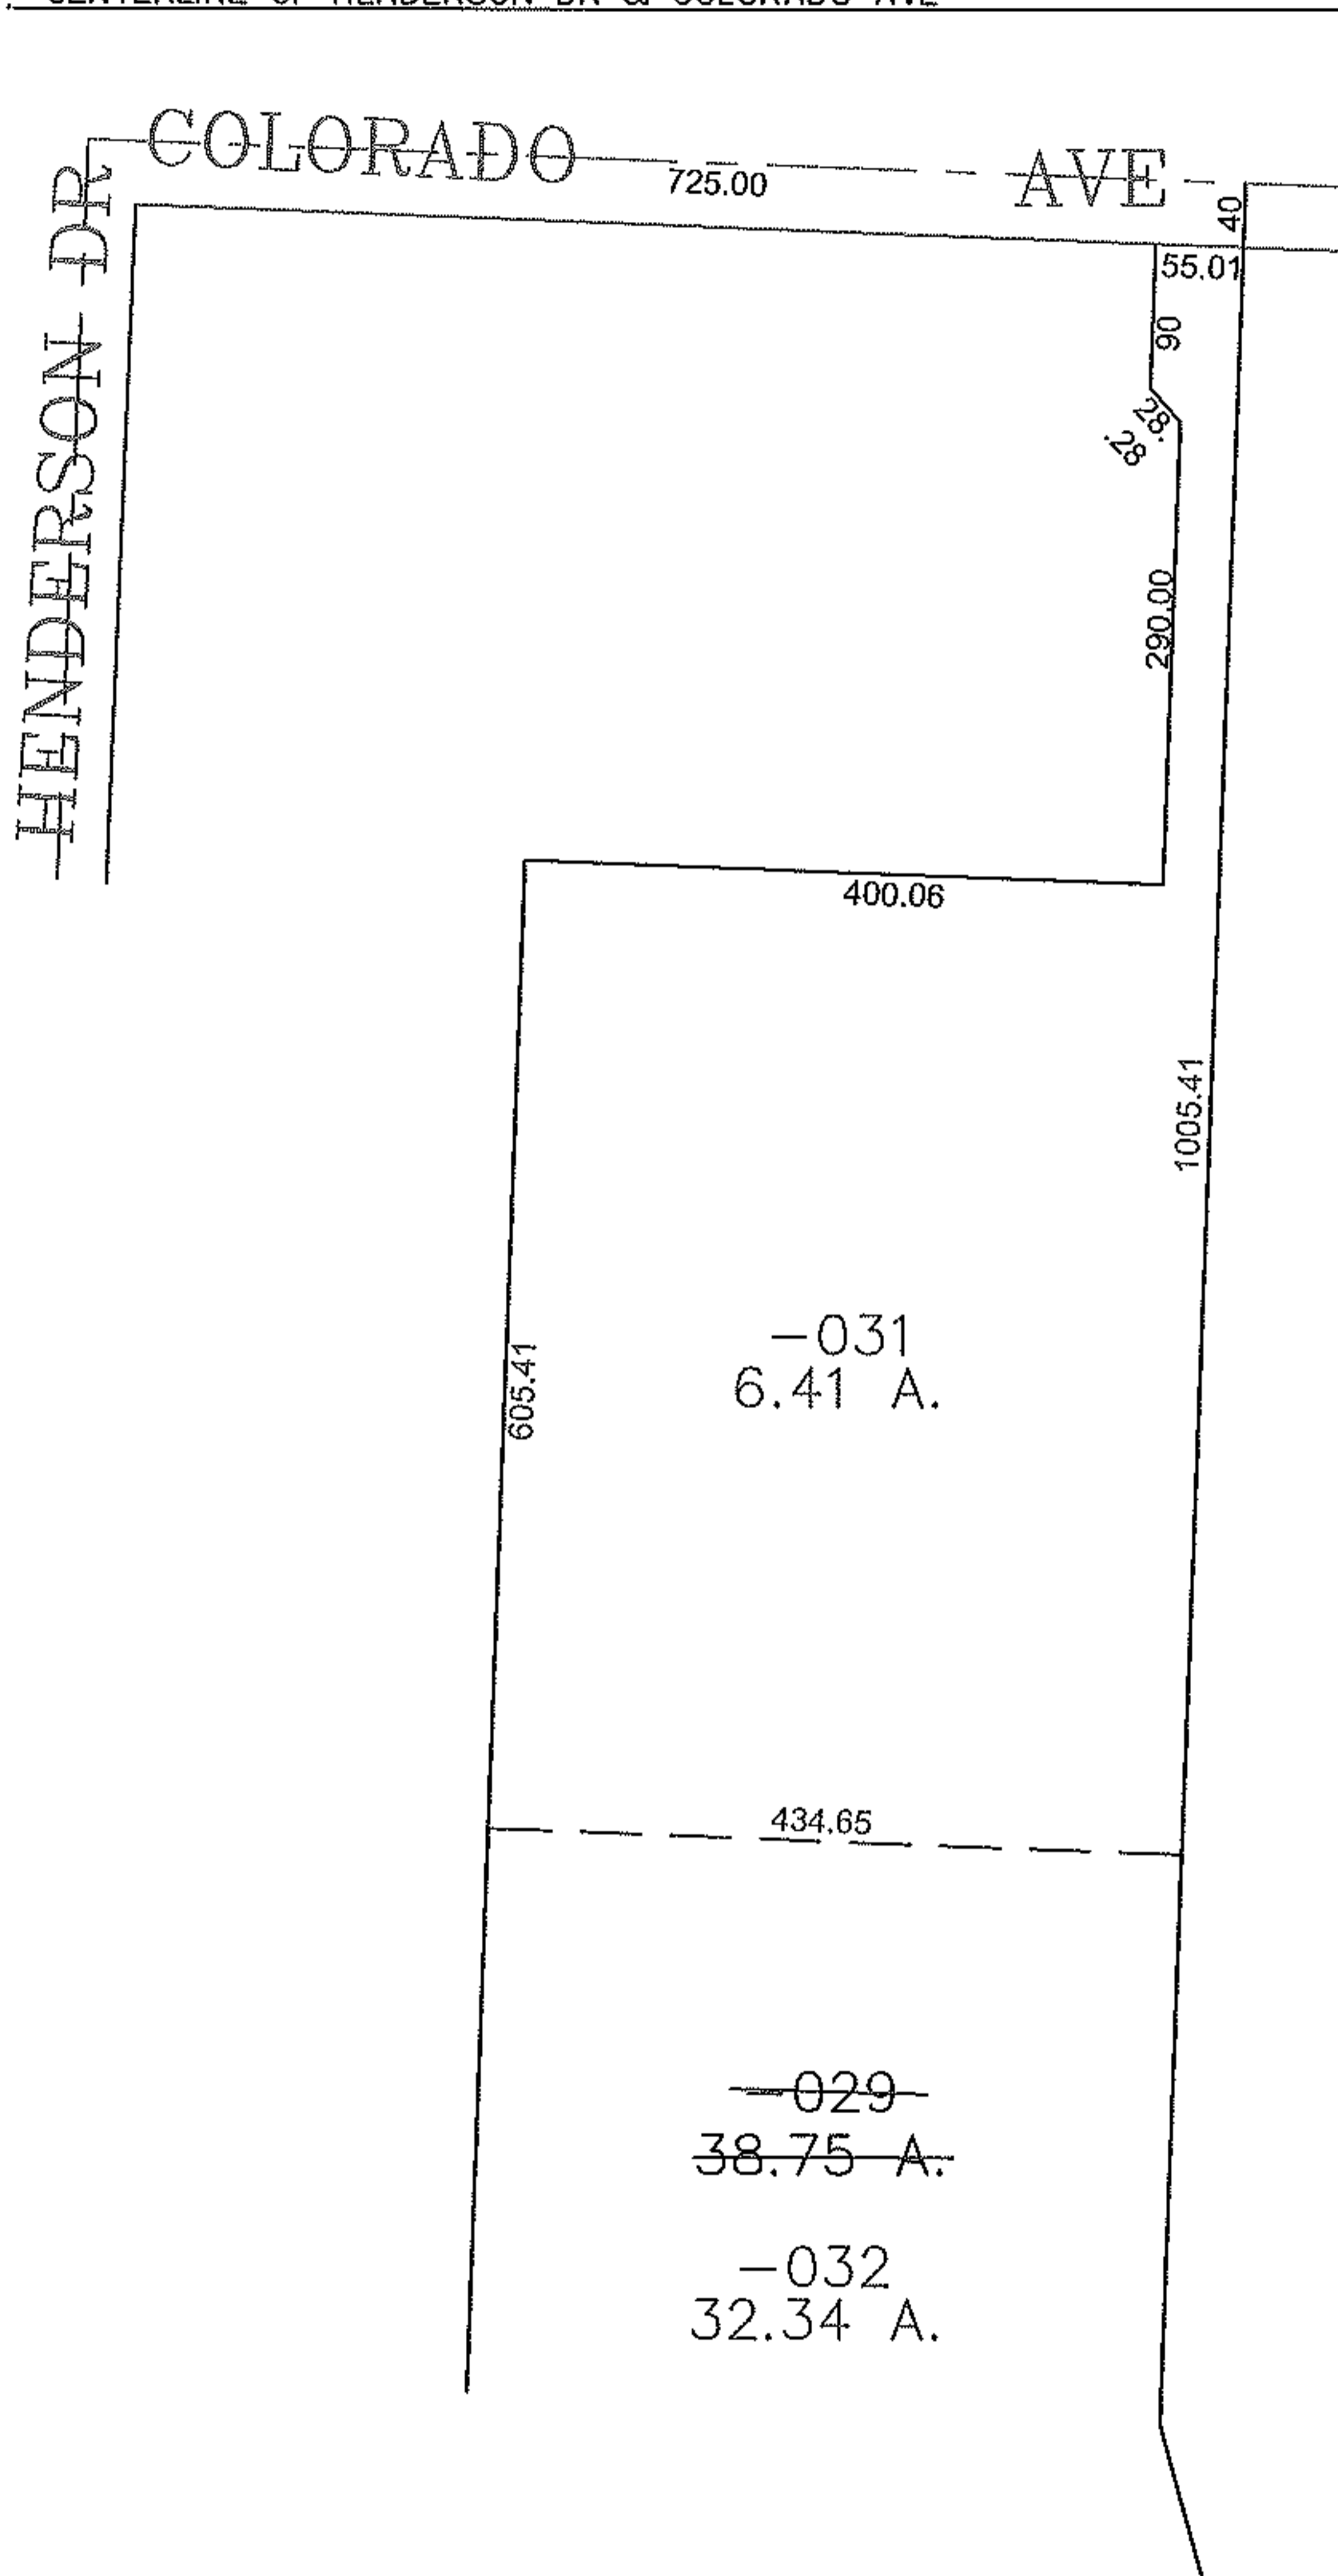

SPLITS/DEEDS PROCESSED
 LORAIN COUNTY TAX MAP DEPARTMENT
 226 MIDDLE AVE. ELYRIA, OHIO

SURVEYED BY: JOHN ALBAN
 CLOSURE: 0.00 : 10,000
 MAP PAGE(S): 03-00-053-A
 APPROVED BY: JAH DATE: 1/30/2014
 SCALE: 1" = 200' PRIOR INSTRUMENT: 20120420443