

PARENT PARCEL: 04-00-020-104-002

CHILD PARCEL: XX-XX-XXX-XXX-XXX

STARTING POINT: CL OF JAYCOX RD. & CL OF WALKER RD.

15-03226-A




ACREAGE CORRECTION

04-00-020-104-002

~~1.00 A.~~

0.92 A.

CORR. PER CALC.

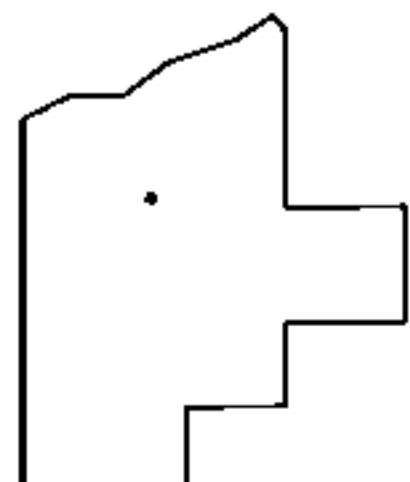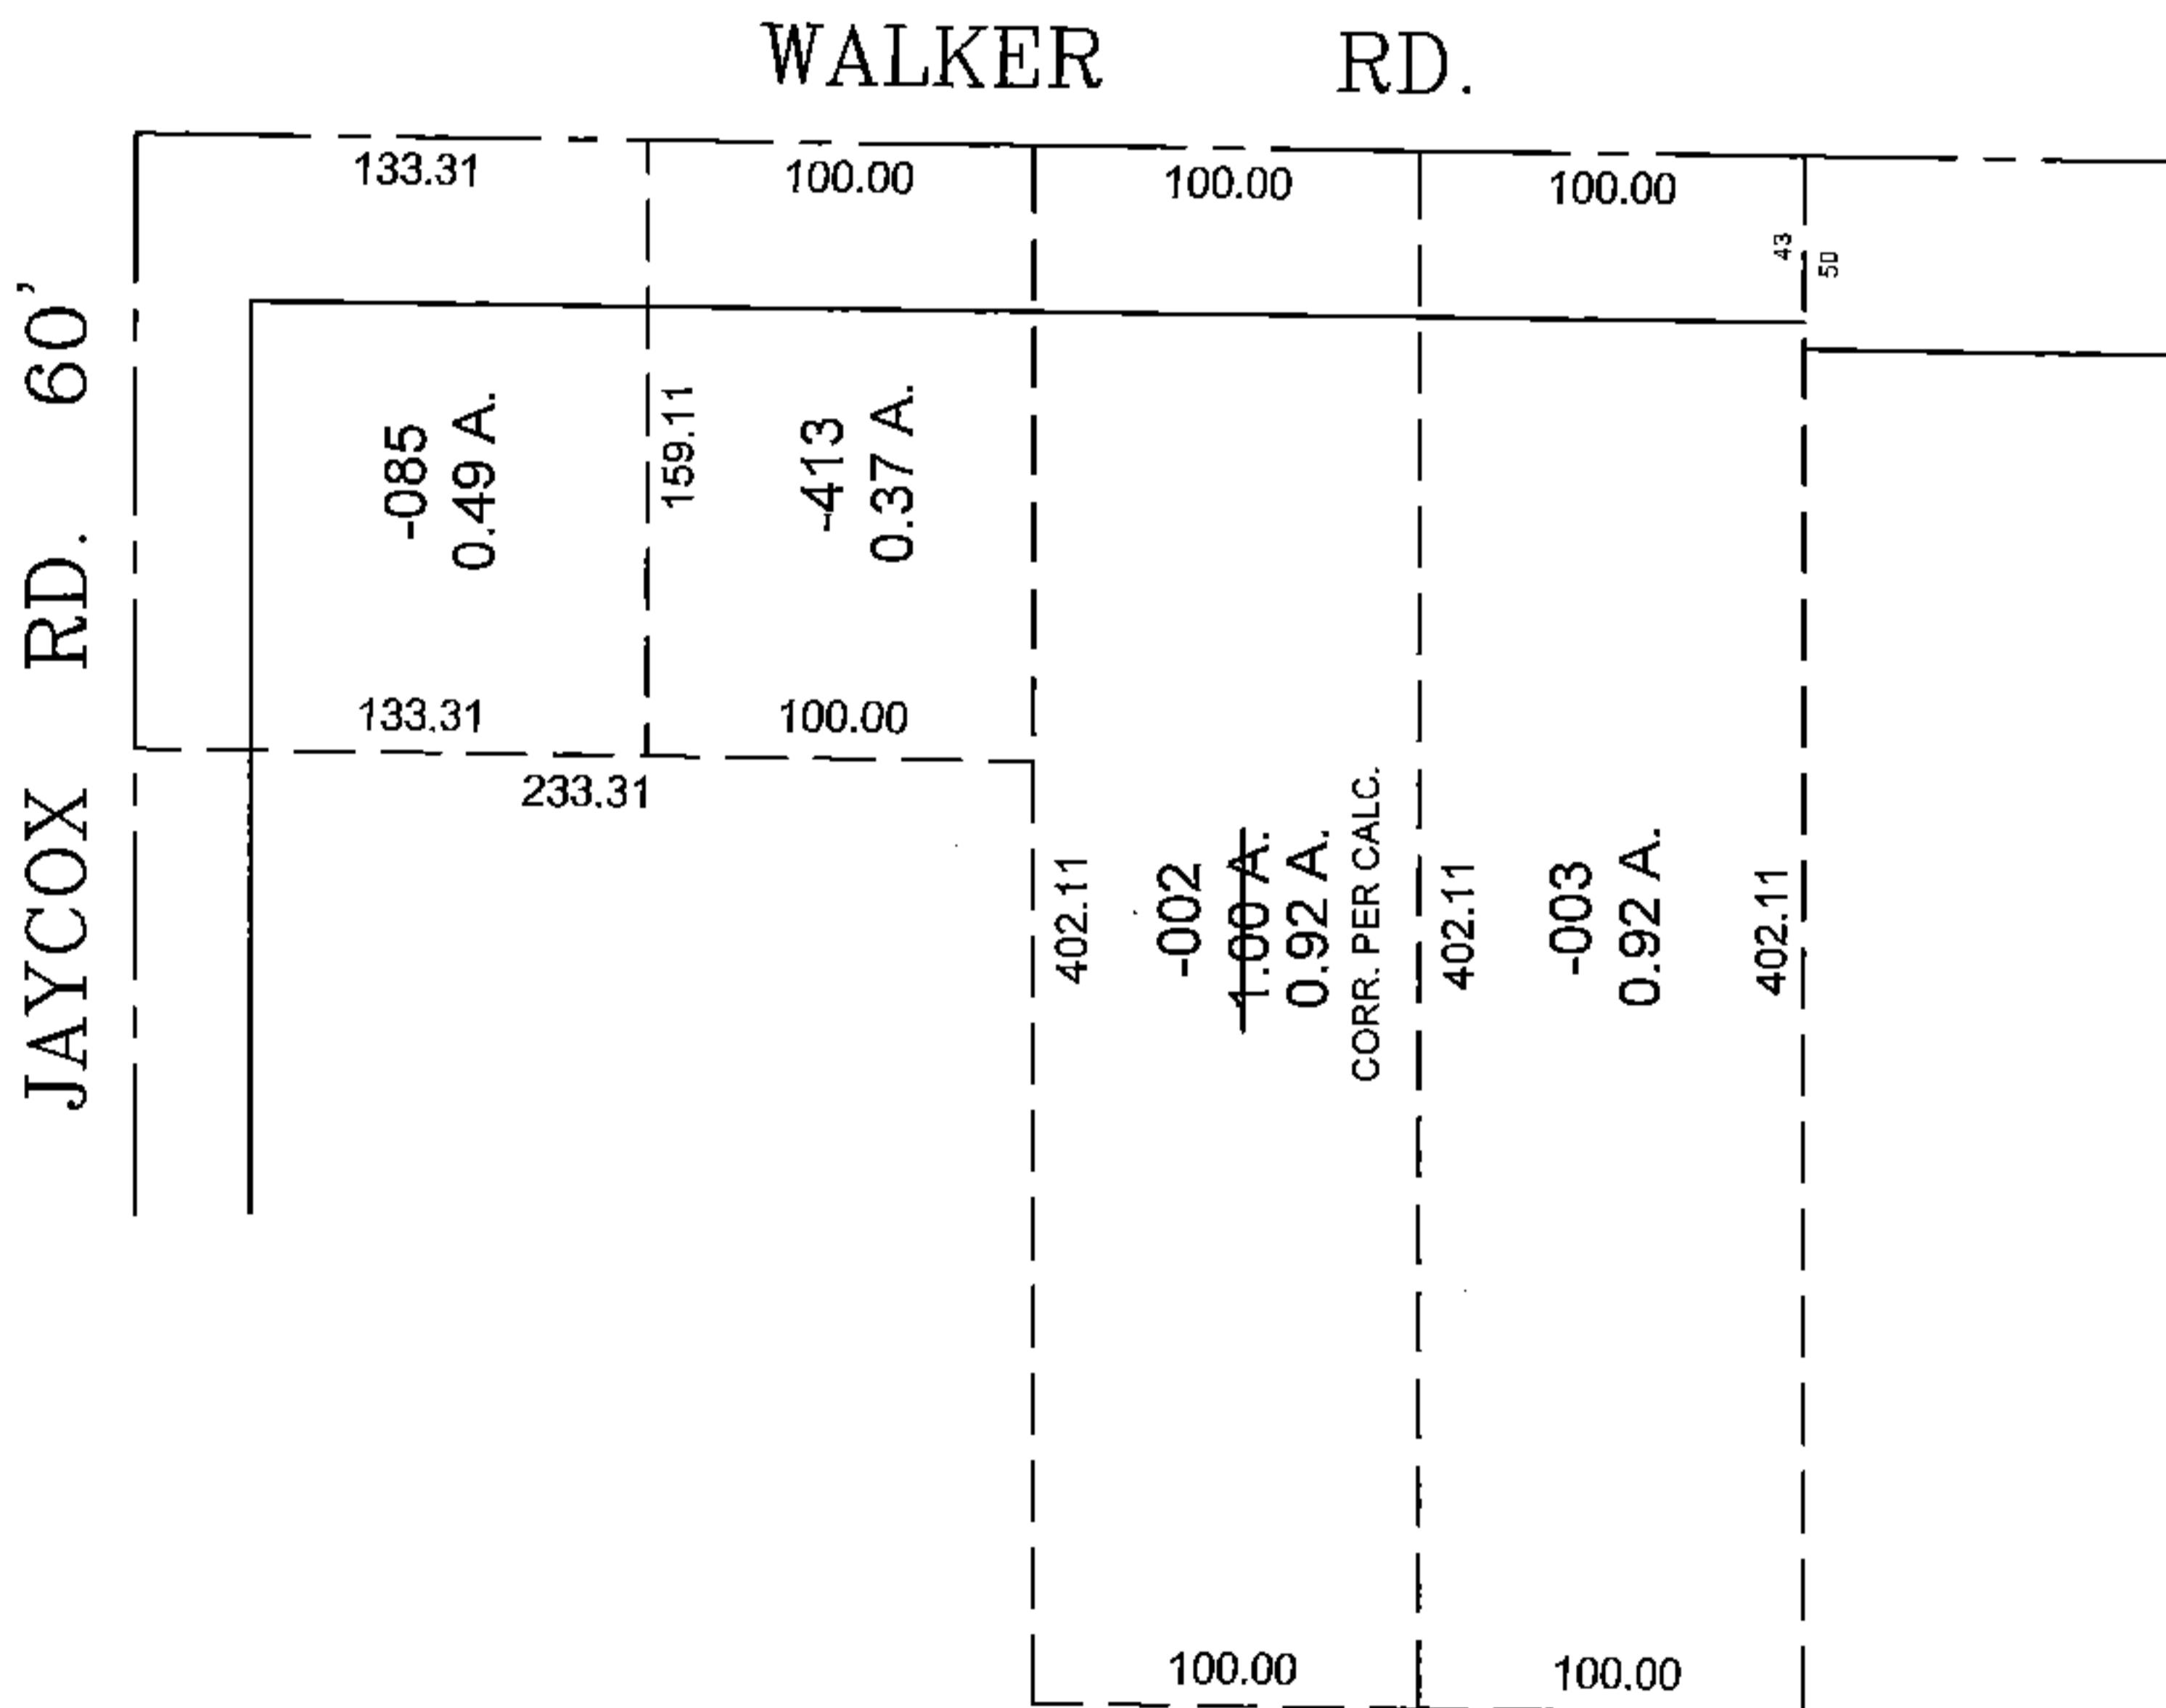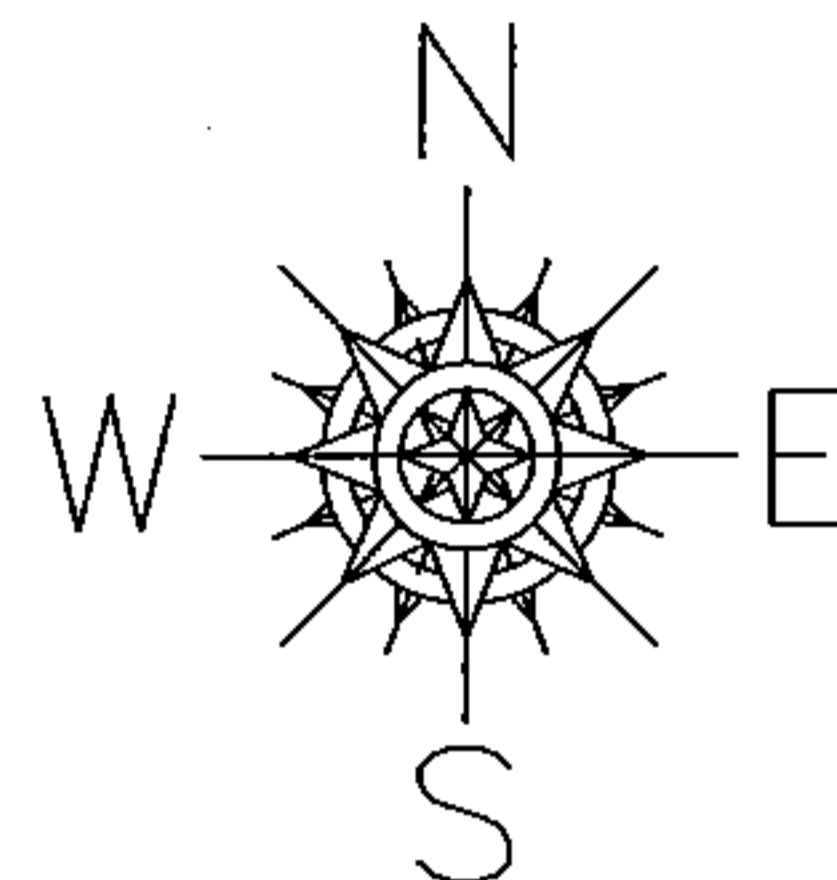

SPLITS/DEEDS PROCESSED

LORAIN COUNTY TAX MAP DEPARTMENT
226 MIDDLE AVE. ELYRIA, OHIO

SURVEYED BY: NA

CLOSURE: 0.00 : 10,000

MAP PAGE(S): 04-00-020

APPROVED BY: TJS DATE: 6/9/15

SCALE: 1" = 100. PRIOR INSTRUMENT: DV 1411/504