
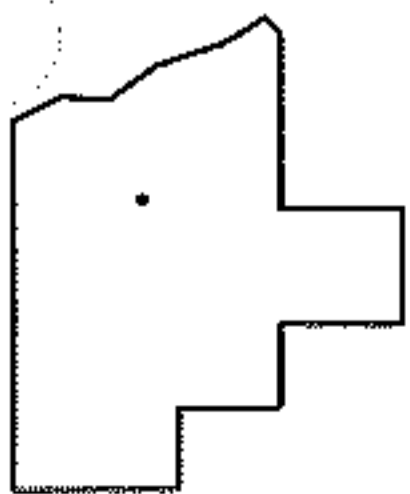
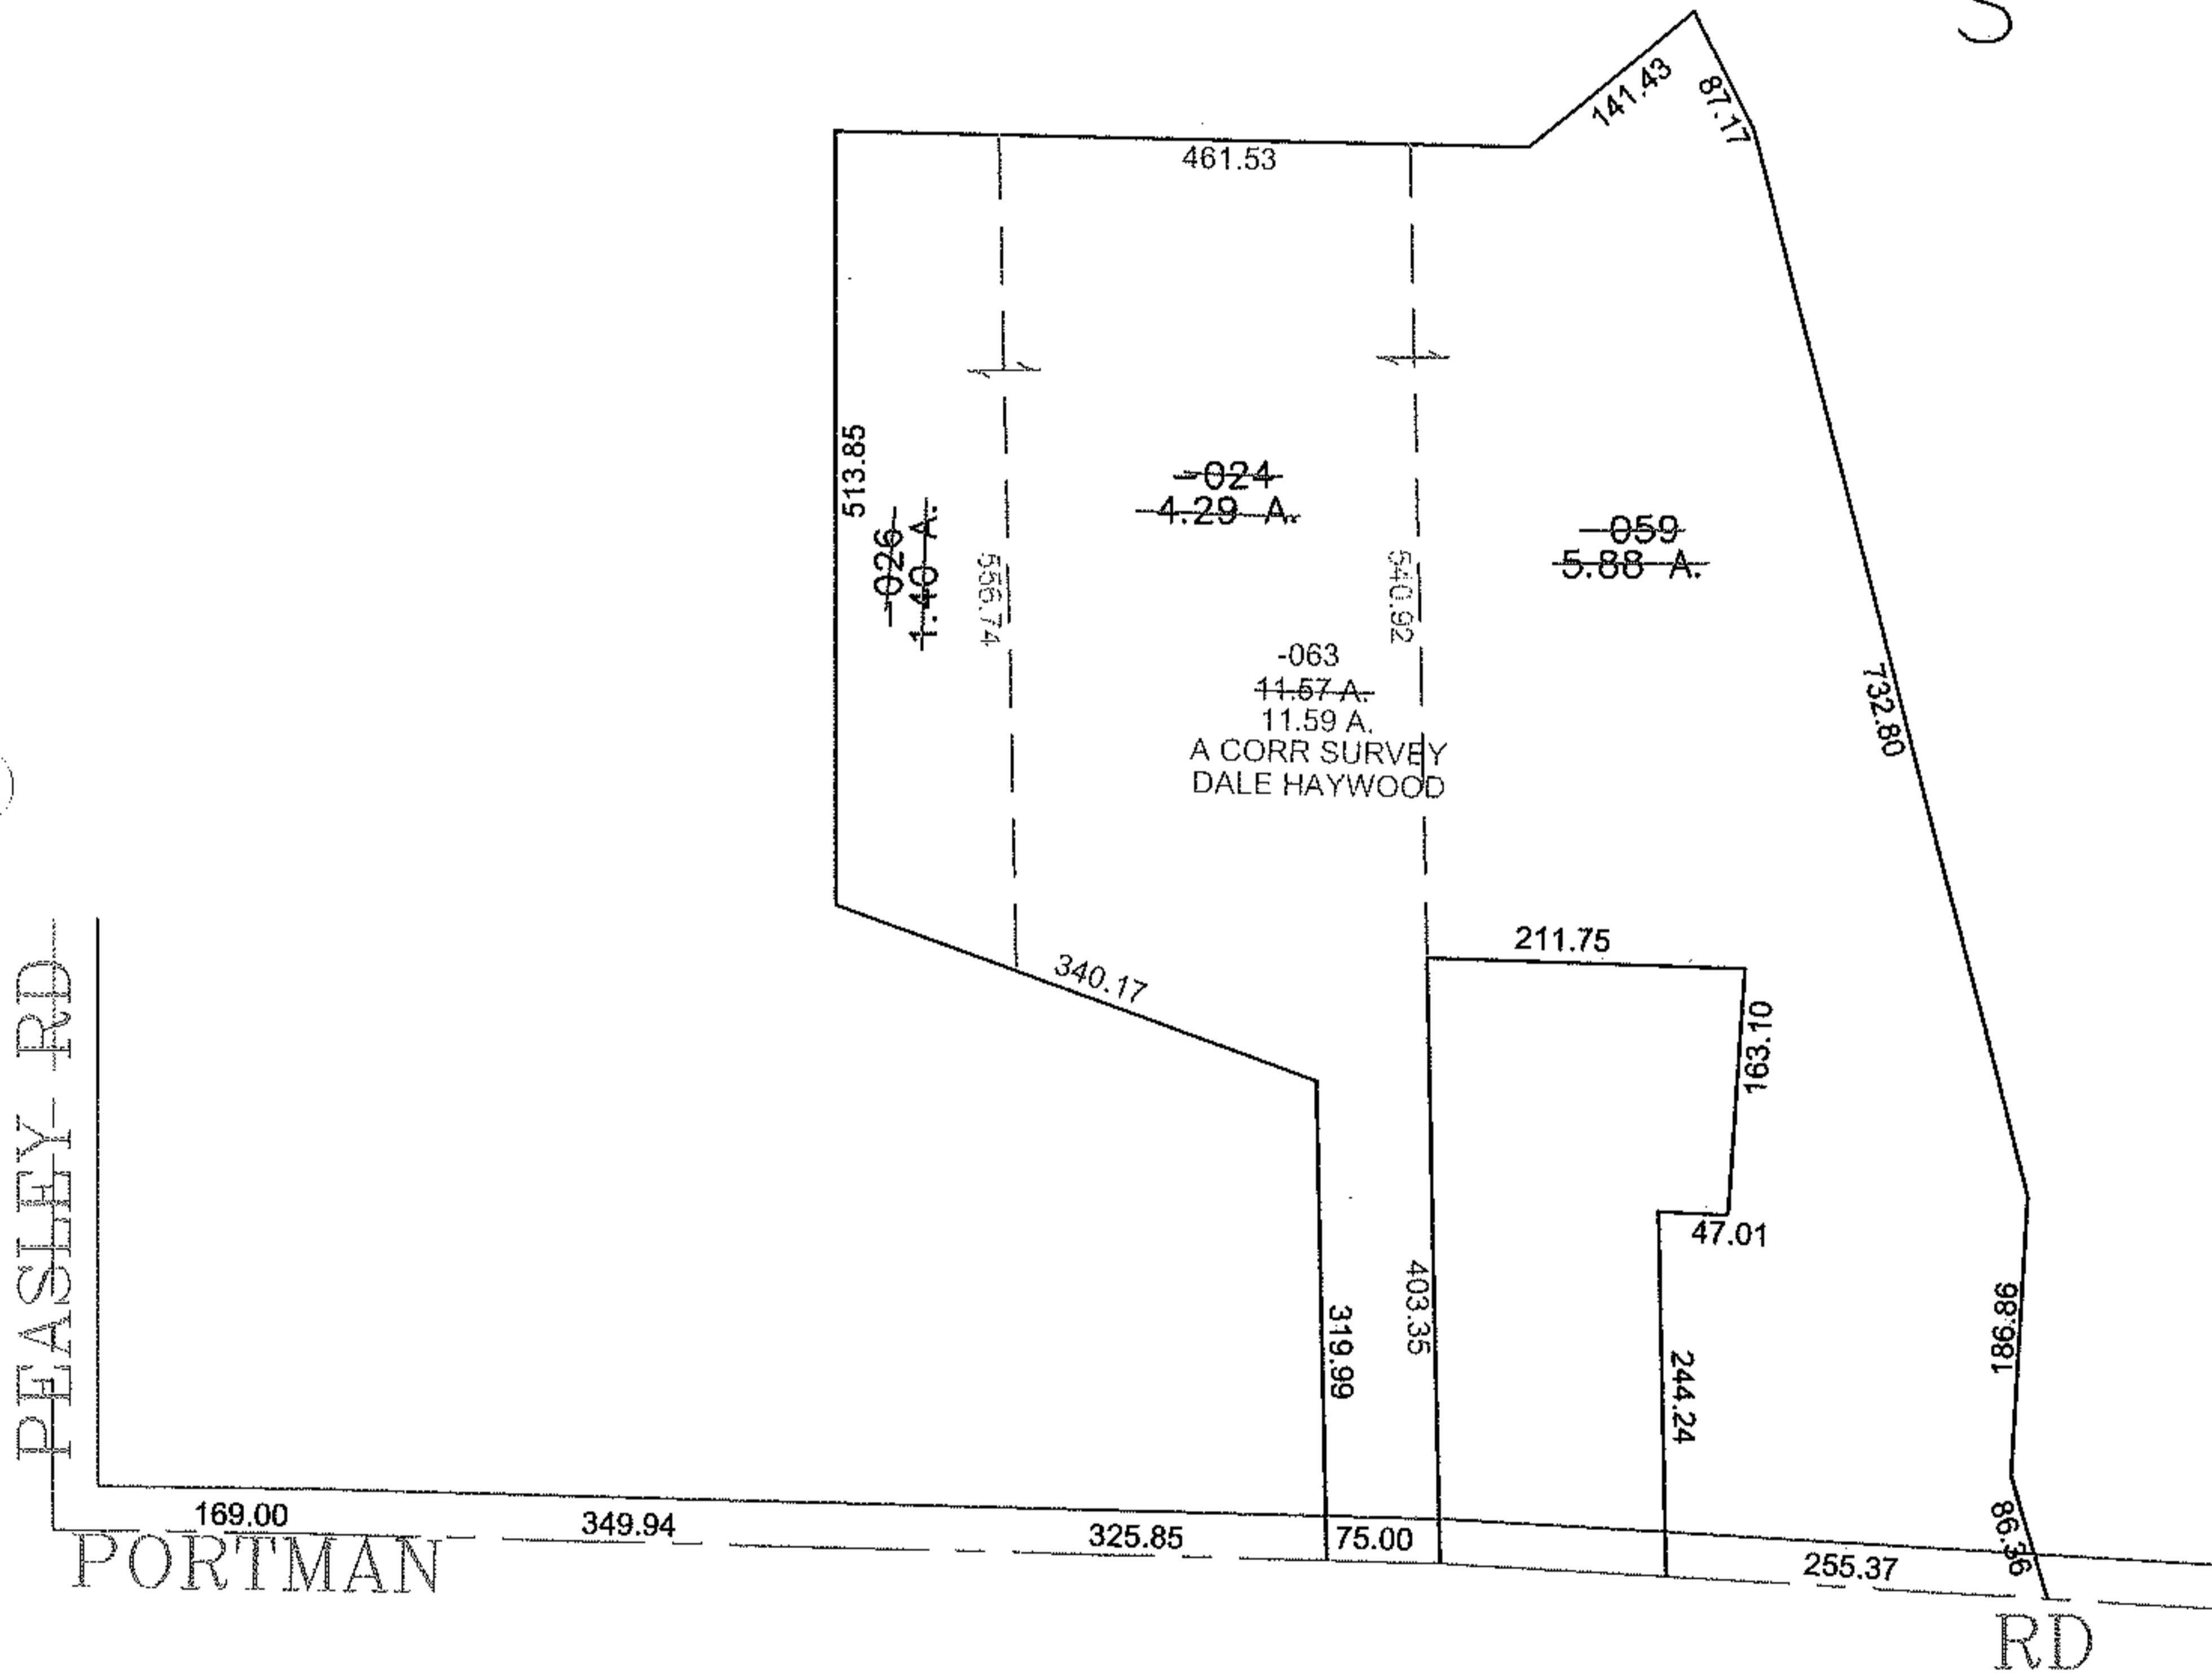


PARENT PARCEL: 01-00-077-000-026, -024, -059

CHILD PARCEL: 01-00-077-000-063

STARTING POINT: CENTERLINE OF PORTMAN RD & PEASLEY RD

14-03226

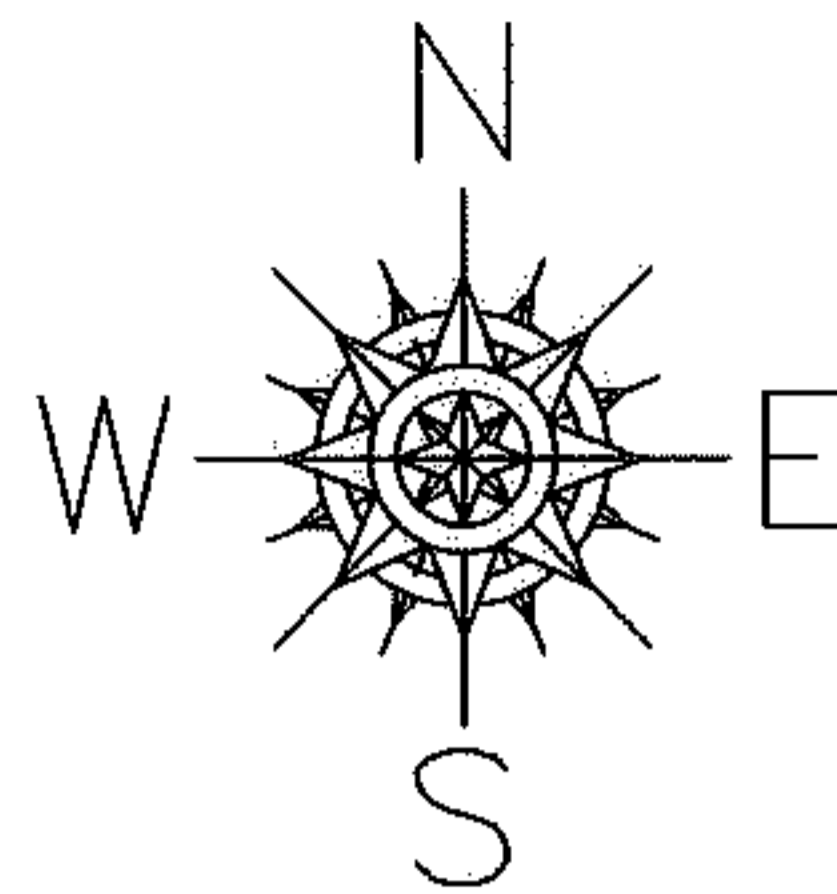

**SPLITS/DEEDS PROCESSED**  
 LORAIN COUNTY TAX MAP DEPARTMENT  
 226 MIDDLE AVE. ELYRIA, OHIO

SURVEYED BY: DALE HAYWOOD  
 CLOSURE: 0.00 : 10,000  
 MAP PAGE(S): 1-J  
 APPROVED BY: JAH DATE: 2/4/2014  
 SCALE: 1" = 200' PRIOR INSTRUMENT: 2050082413