
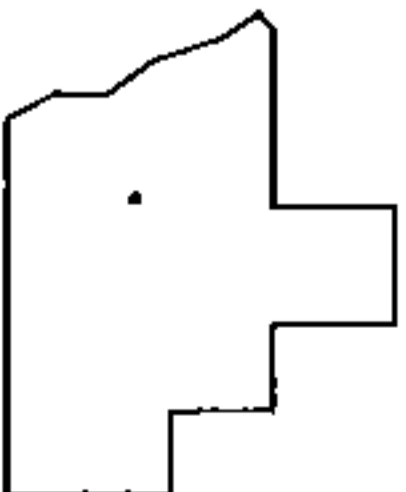
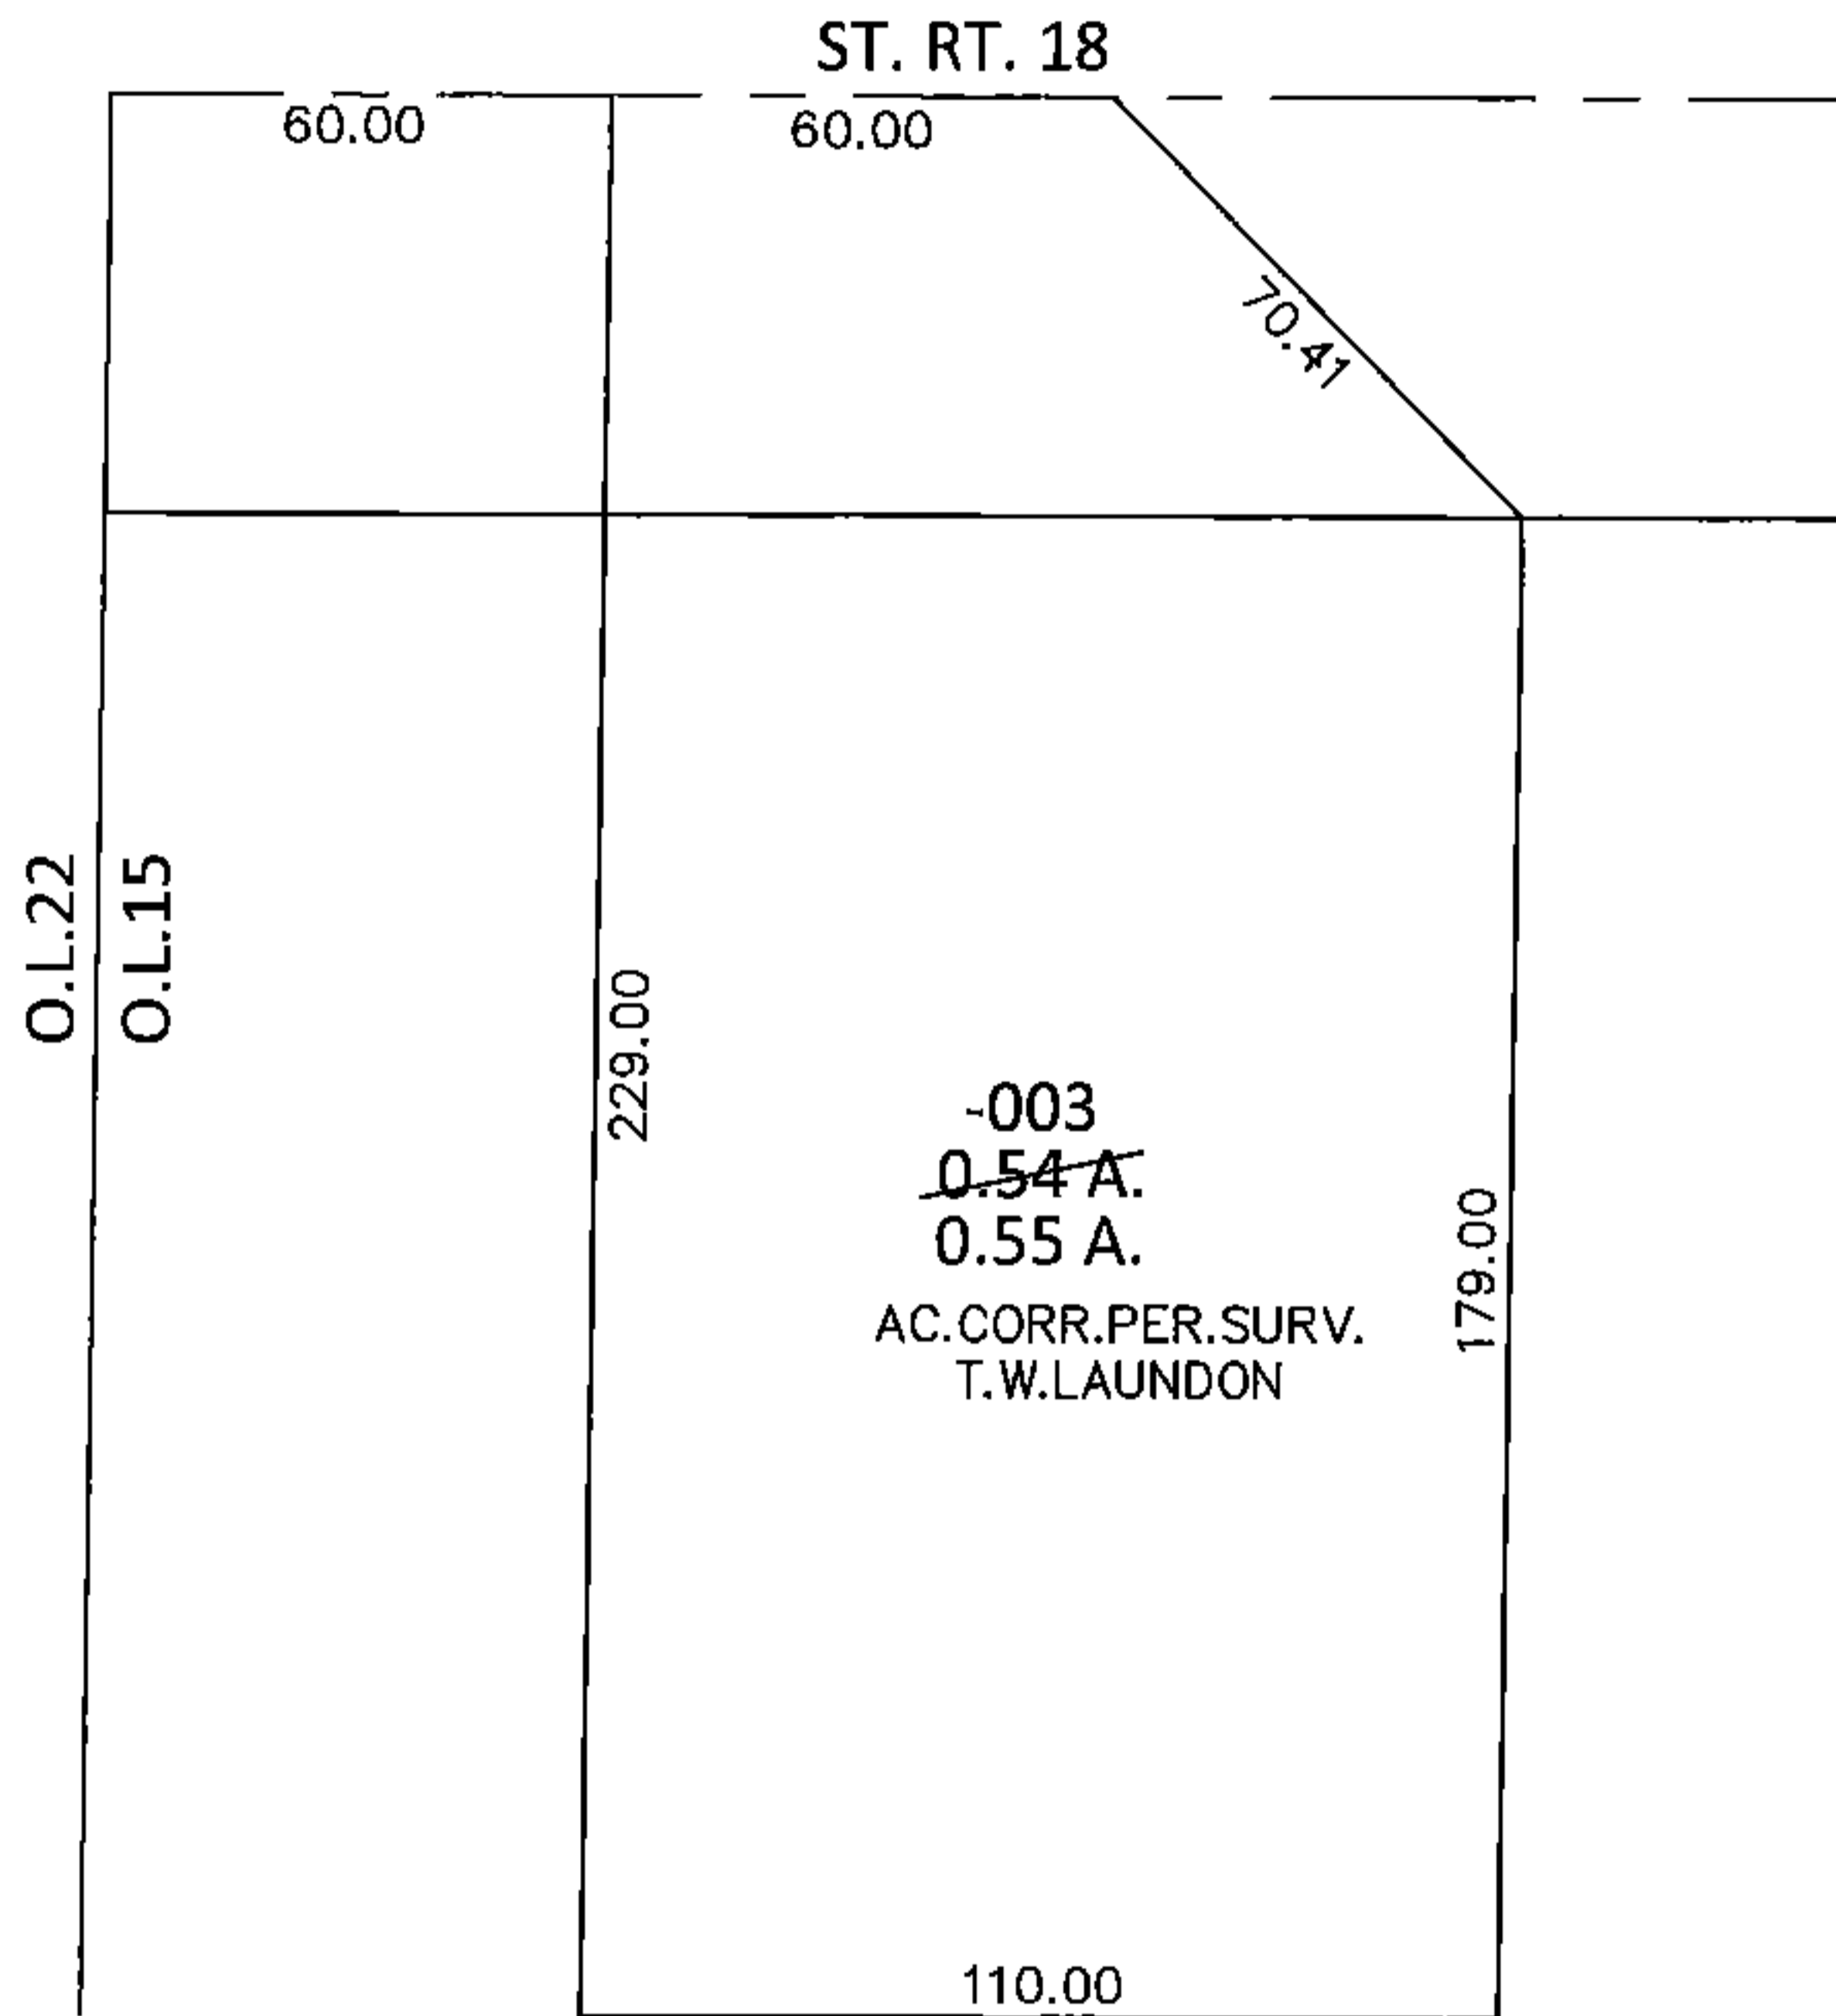


PARENT PARCEL: 18-00-015-000-003

CHILD PARCEL: _____

STARTING POINT: INTERSECTION OF C/L OF S.R. 18 AND WEST LINE OF VILLAGE OF WELLINGTON

15-03230-A

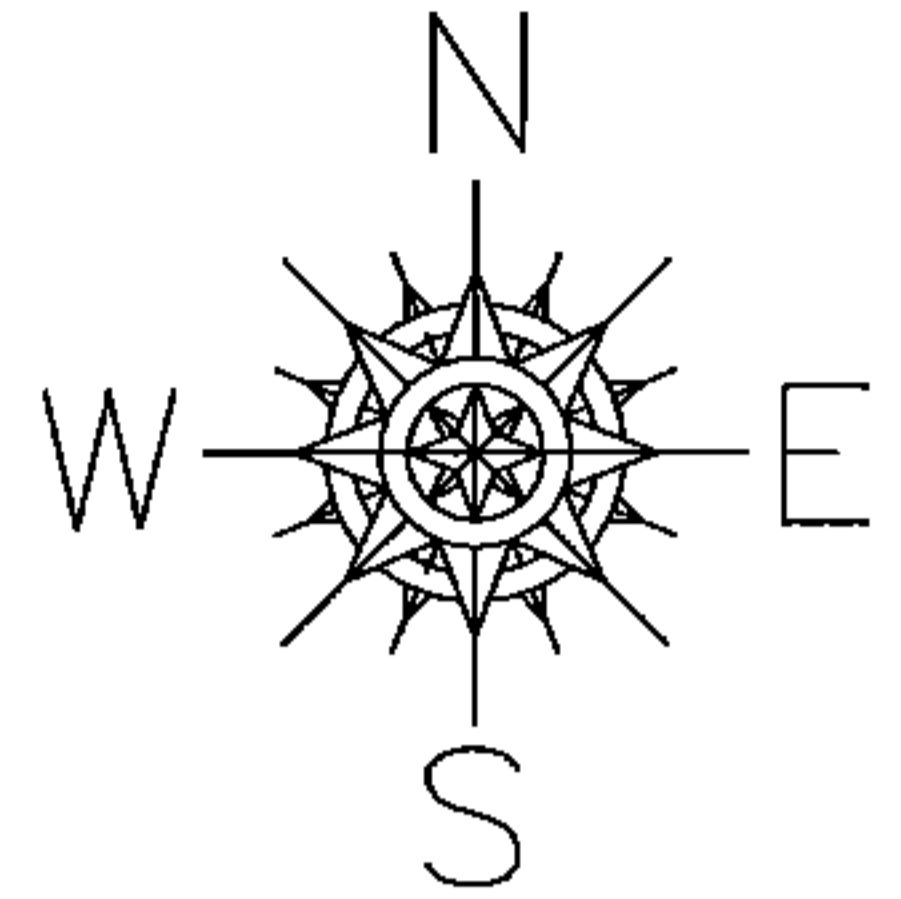

SPLITS/DEEDS PROCESSED

LORAIN COUNTY TAX MAP DEPARTMENT
226 MIDDLE AVE. ELYRIA, OHIO

SURVEYED BY: T.W. LAUNDON

CLOSURE: .01:10,000

MAP PAGE(S): 18-00-015-A

APPROVED BY: RRM DATE: 6-10-15

SCALE: 1"= 50' PRIOR INST.: 20150546735