


PARENT PARCEL: 06-25-176-104-007, -008



CHILD PARCEL: XX-XX-XXX-XXX-XXX

STARTING POINT: N/A DRAWN FROM PLAT

14-03230

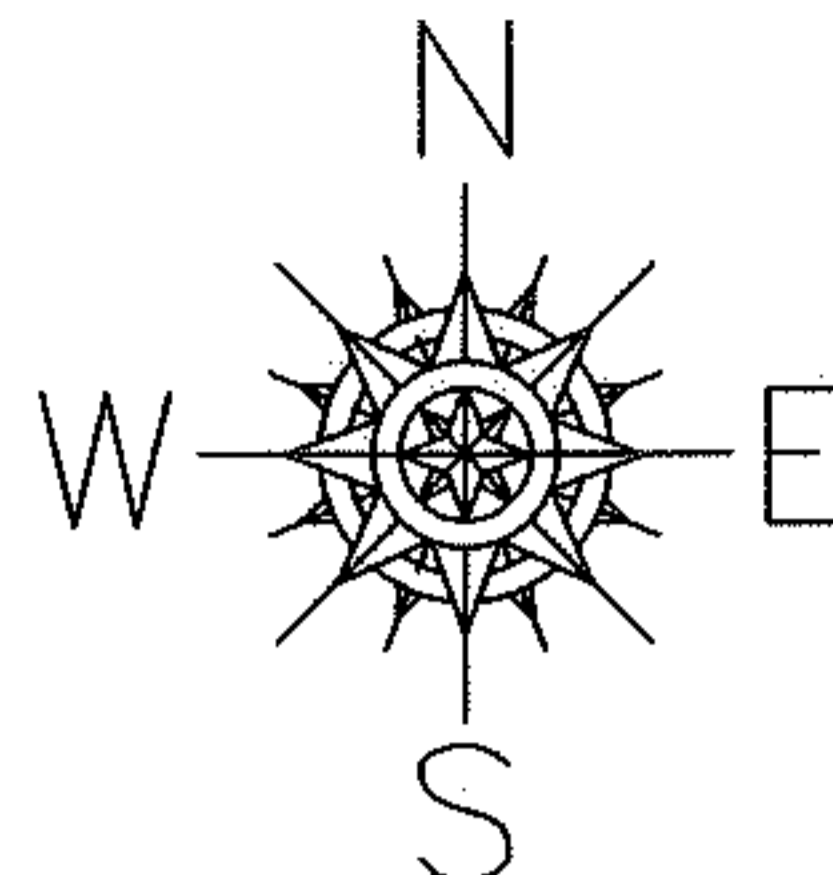

COMBINATION PER DEED
1 LEGAL 2 PARCEL NUMBERS
NOW ONE PARCEL NUMBER

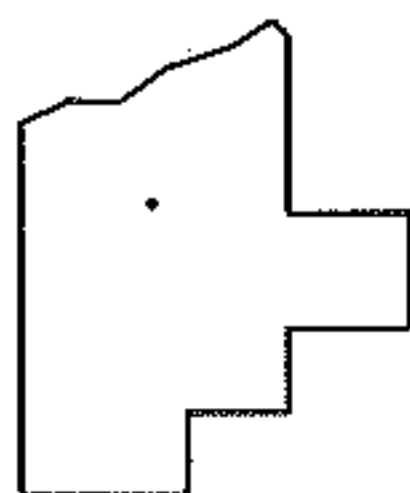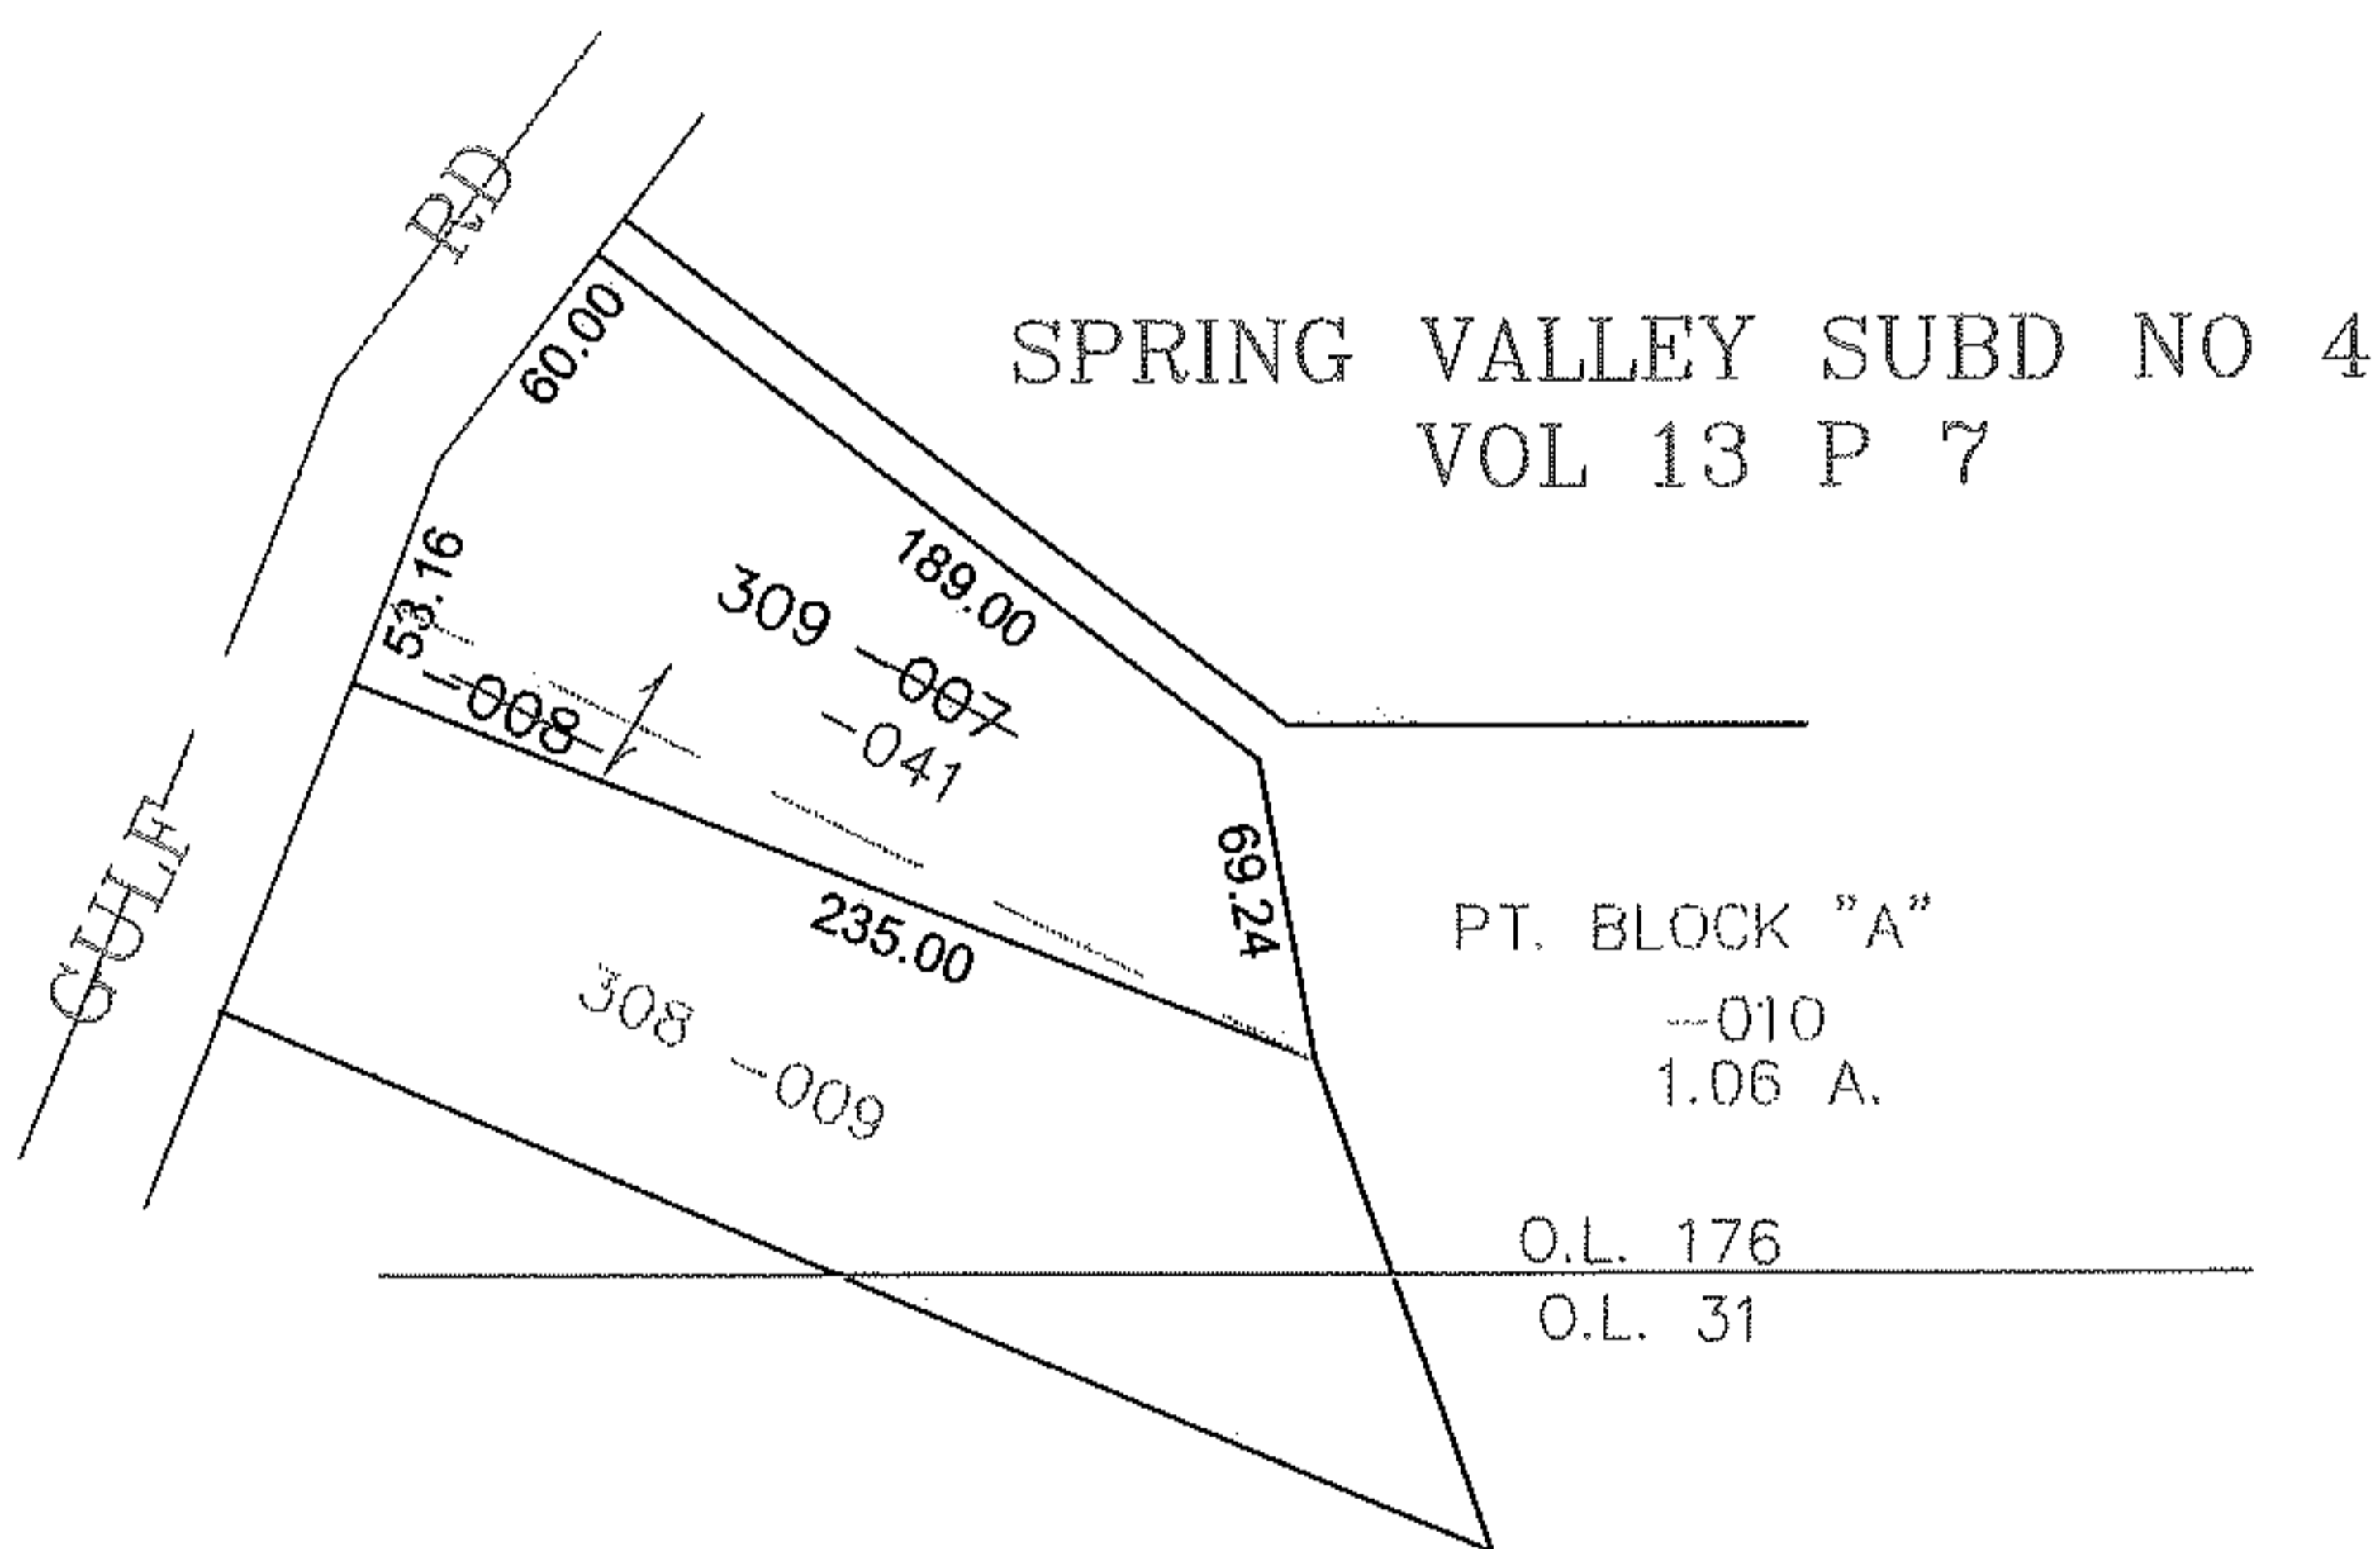

SPLITS/DEEDS PROCESSED

LORAIN COUNTY TAX MAP DEPARTMENT
226 MIDDLE AVE. ELYRIA, OHIO

SURVEYED BY: NA- DRAWN FROM PLAT

CLOSURE: 0.00: 10.000

MAP PAGE(S): XX-XX-XXX

APPROVED BY: XXX DATE: 6-51

SCALE: 1" = 100 PRIOR INSTRUMENT: 19870261676