


PARENT PARCEL: 06-23-009-102-059

CHILD PARCEL: _____



STARTING POINT: AT A MON BOX AT THE INTERSECTION OF C/L OF LAKE AVE. AND C/L OF SCHADEN RD.

15-03231-A

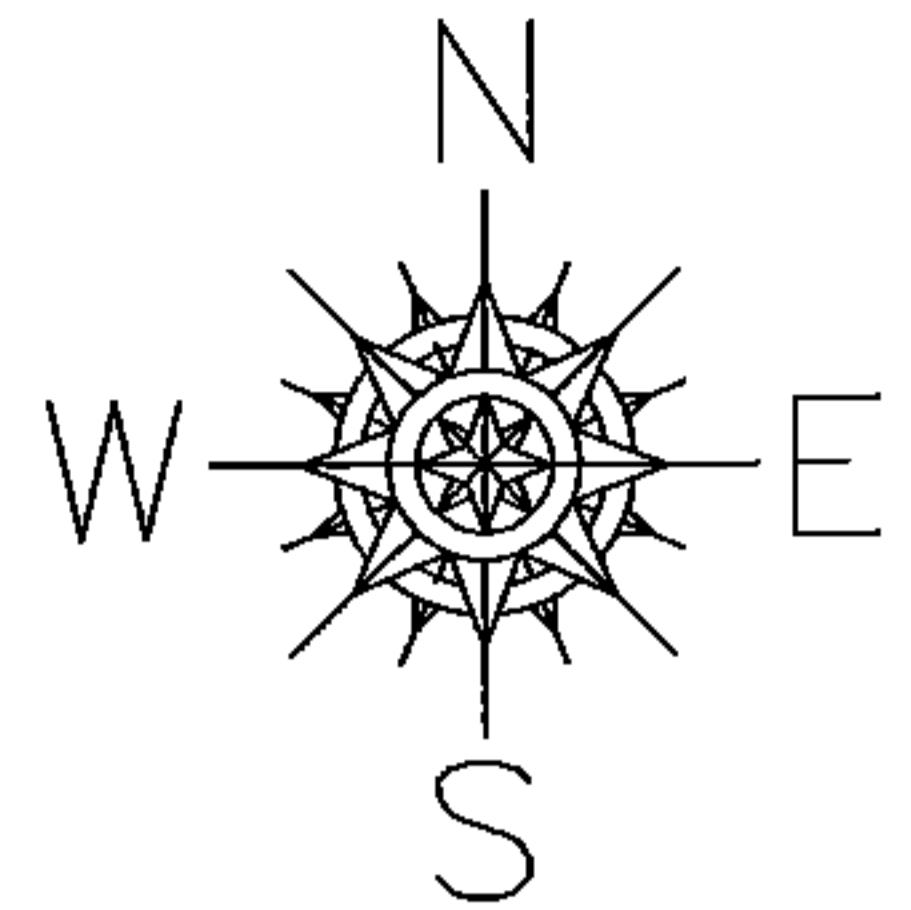

FRONTAGE & DEPTH TO ACREAGE CORRECTION

06-23-009-102-059
0.27 A.
~~50 X 236.83~~
AC.CORR.PER.SURV.
D.HAYWOOD

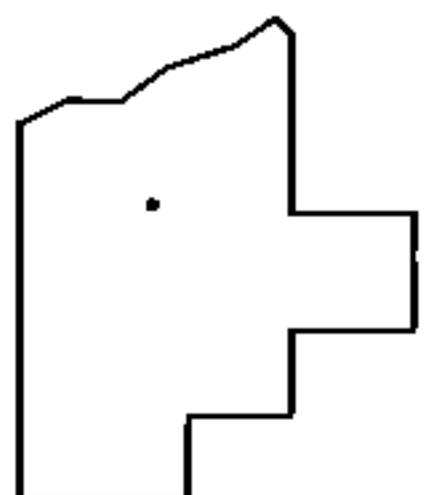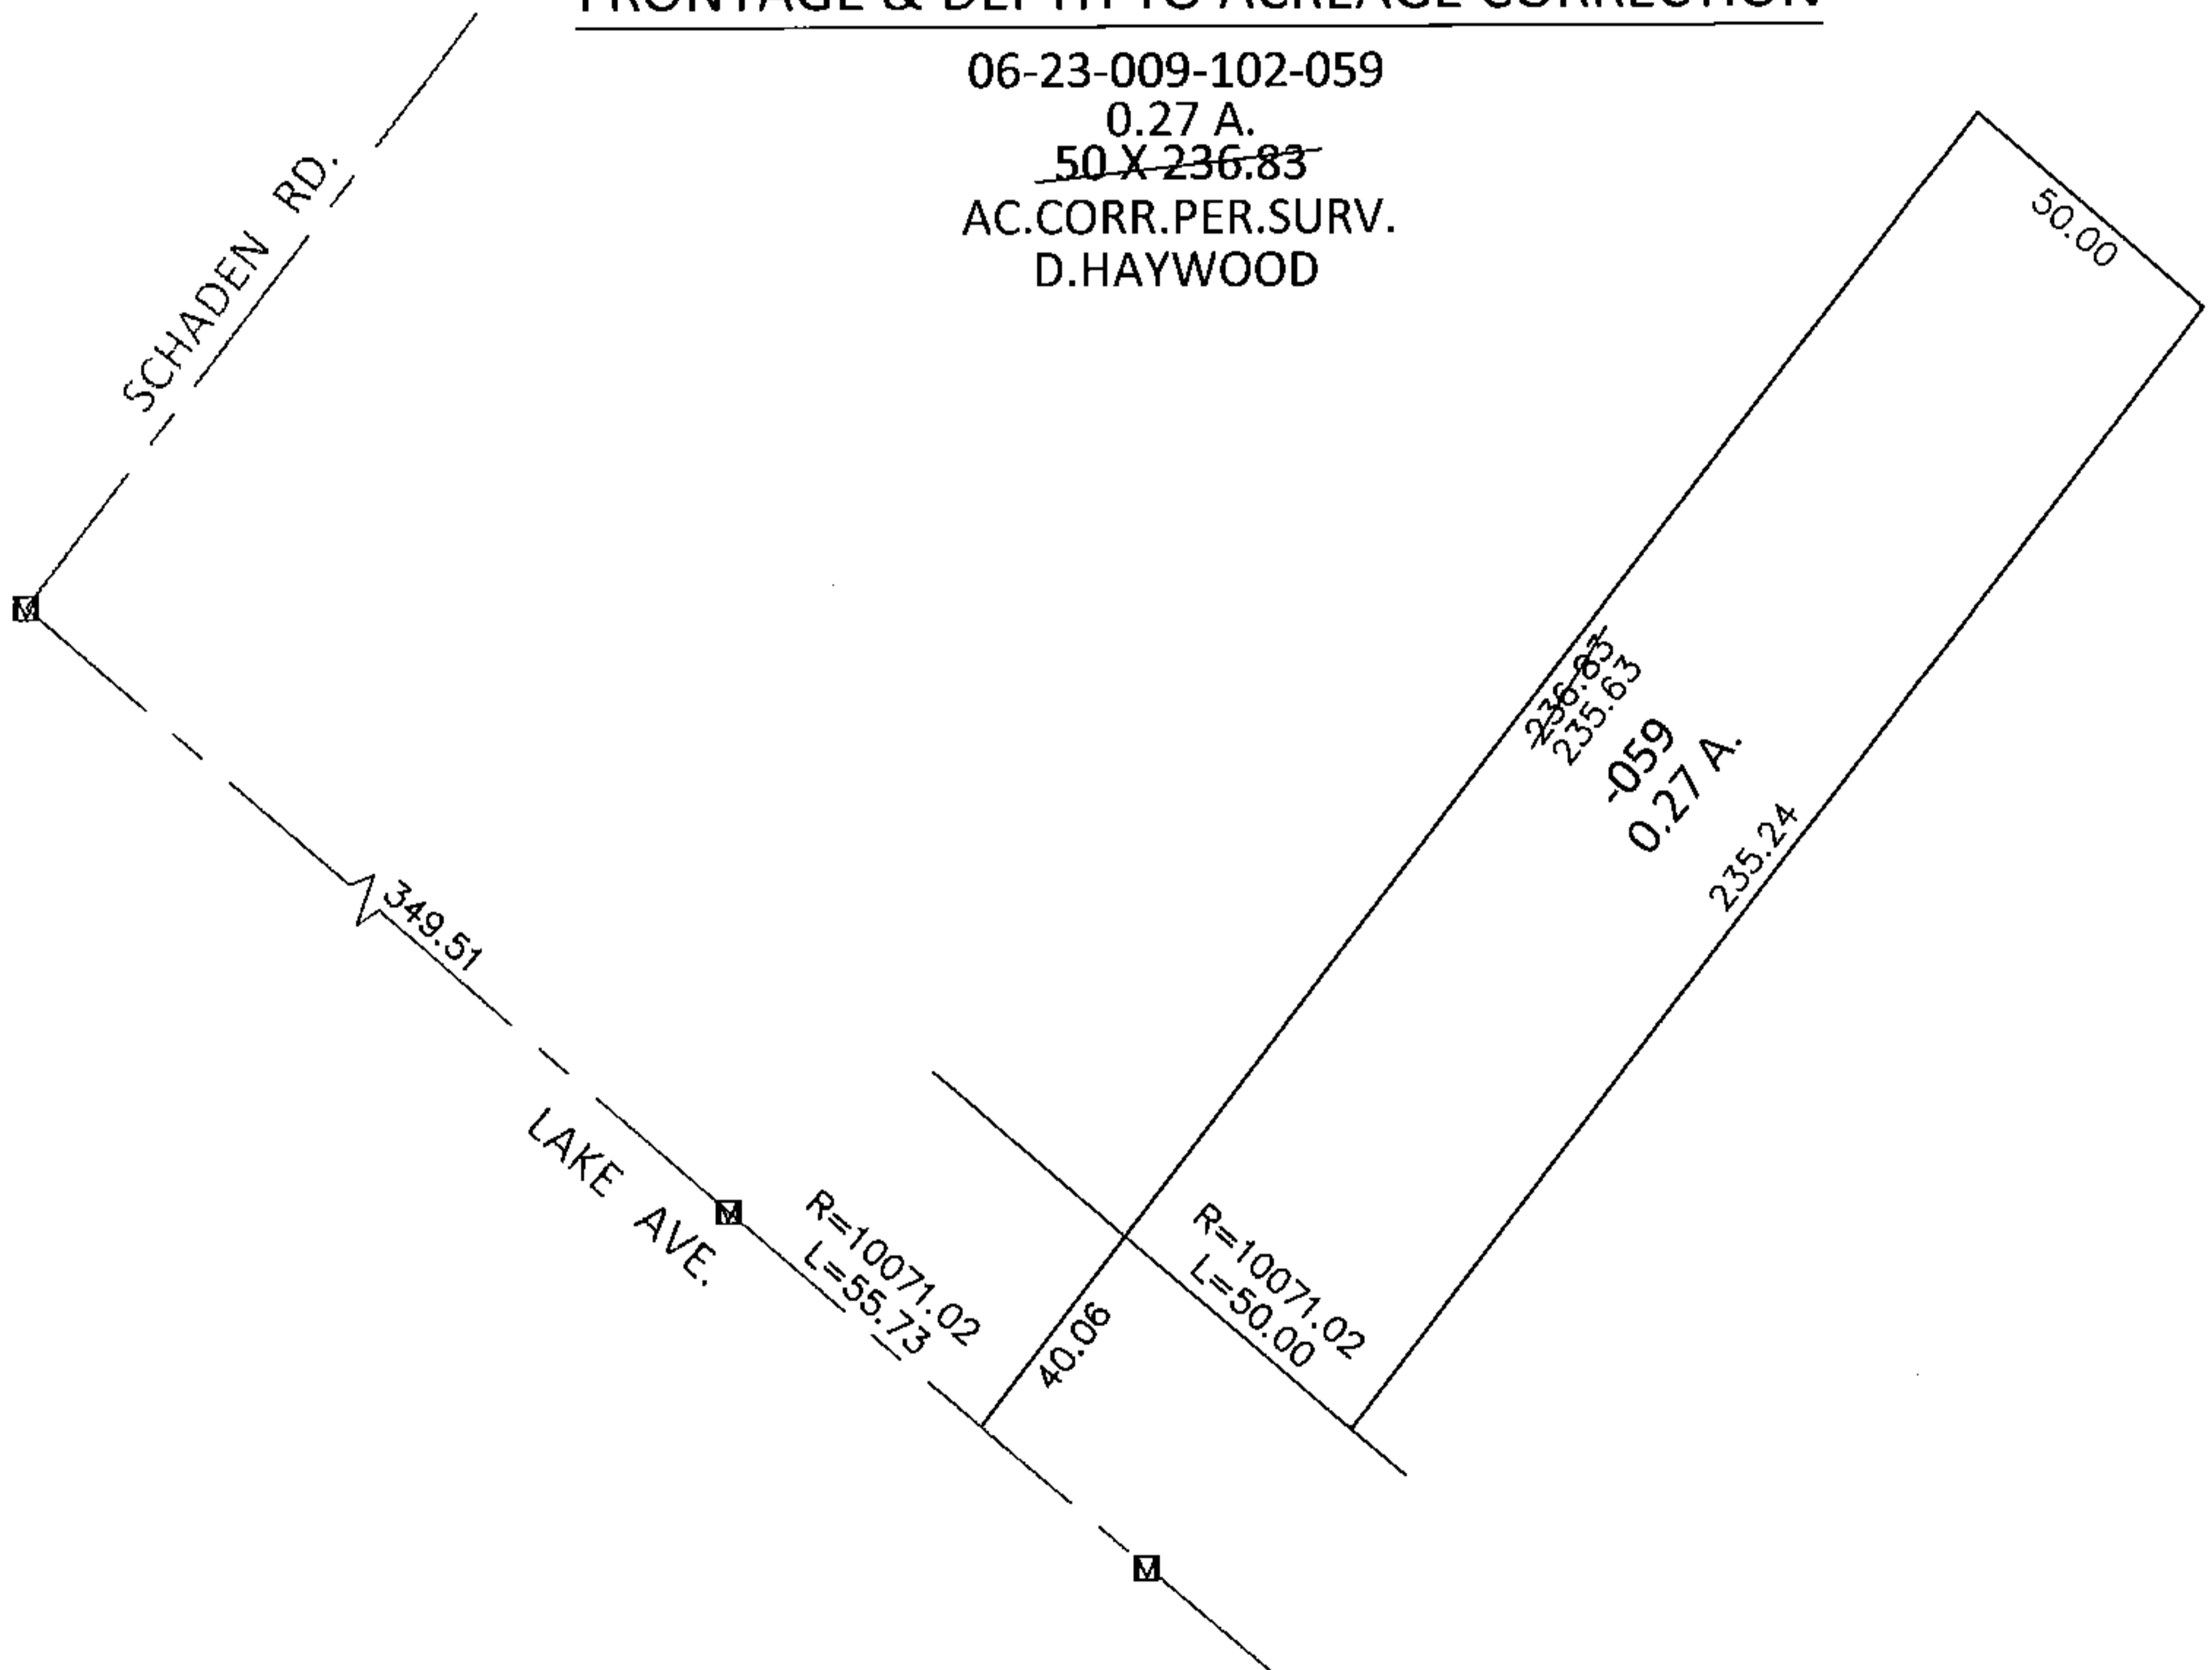

SPLITS/DEEDS PROCESSED

LORAIN COUNTY TAX MAP DEPARTMENT
226 MIDDLE AVE. ELYRIA, OHIO

SURVEYED BY: DALE R. HAYWOOD

CLOSURE: .00:10,000

MAP PAGE(S): 6-24

APPROVED BY: RRM DATE: 6-10-15

SCALE: 1"= 50' PRIOR INST.: 20150539389