


PARENT PARCEL: 18-00-028-104-117, -084



CHILD PARCEL: 18-00-028-104-120, -121

STARTING POINT: EASTERLY LINE OF WENNER ST & NW CORNER OF S/L 68

14-03231

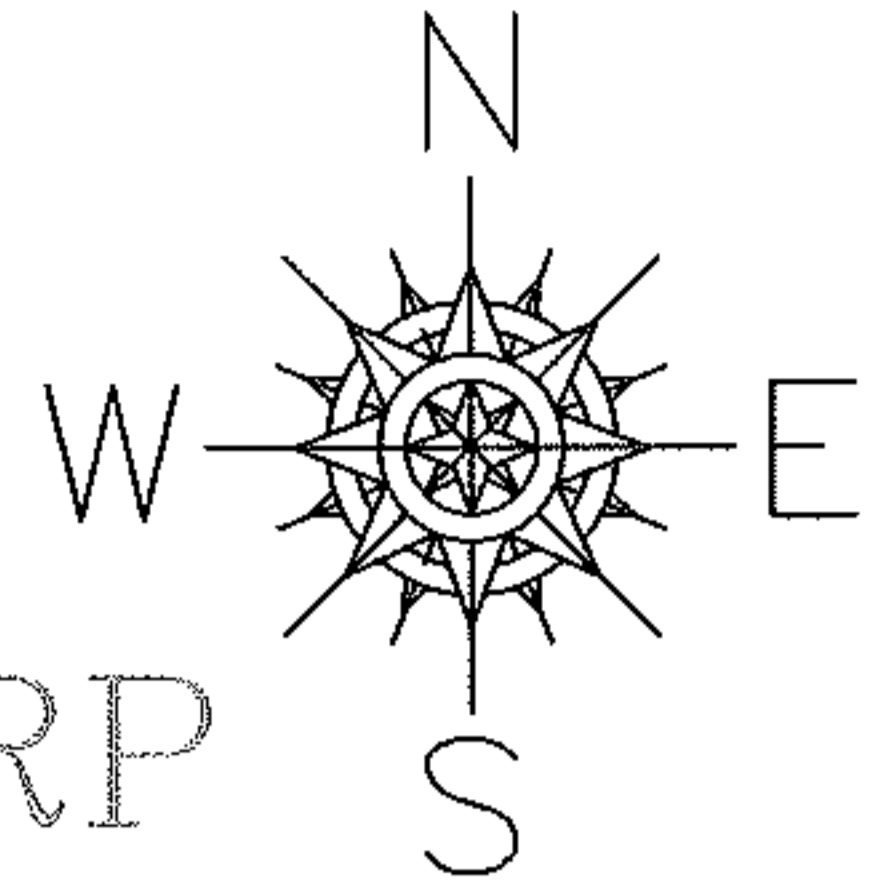

WENNER ALLOT CORP
SUBD NO 4
VOL 25 PG 45

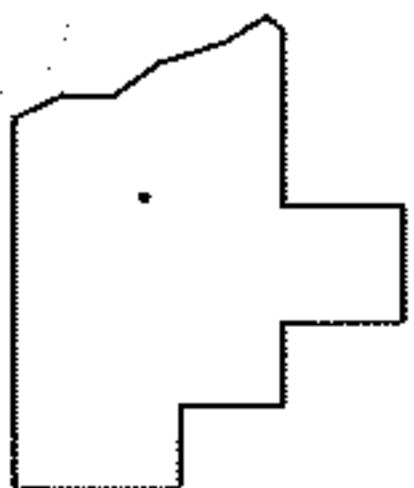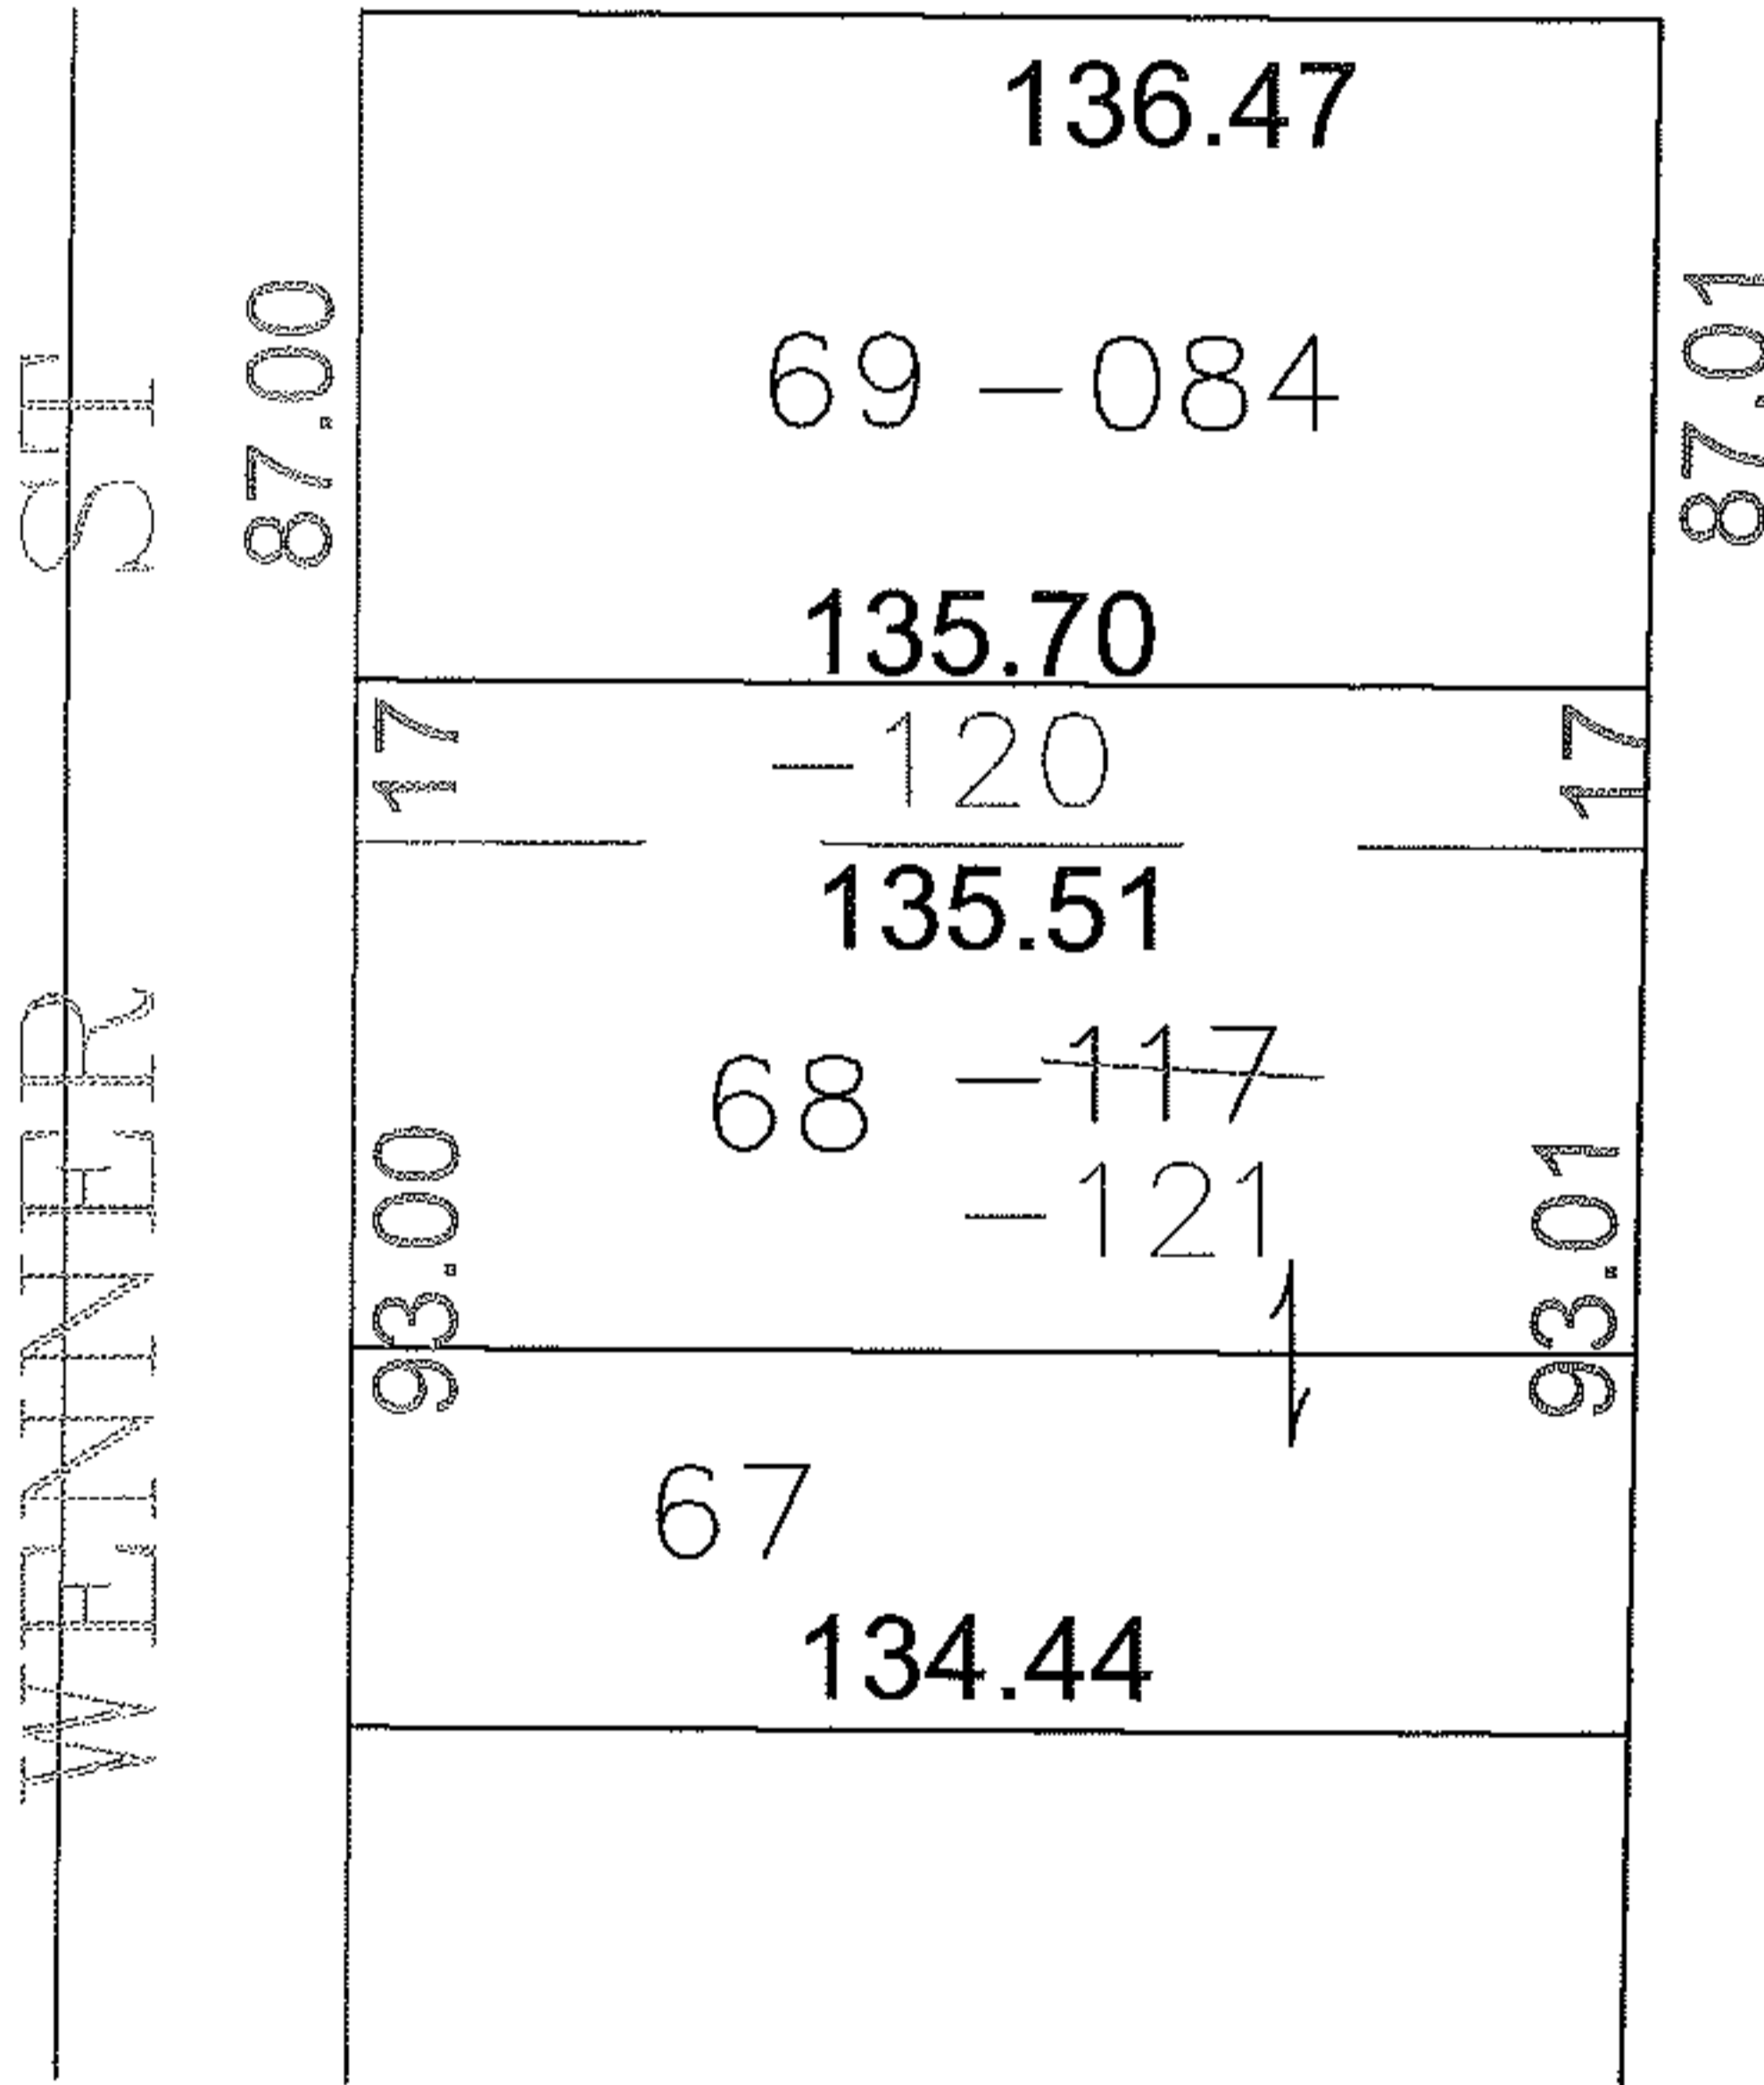

SPLITS/DEEDS PROCESSED

LORAIN COUNTY TAX MAP DEPARTMENT
226 MIDDLE AVE. ELYRIA, OHIO

SURVEYED BY: RICHARD CARLSON

CLOSURE: 0.00 : 10,000

MAP PAGE(S): 18-00-028-C

APPROVED BY: JAH DATE: 3/11/2014

SCALE: 1"= 50' PRIOR INST.: 19930261461