

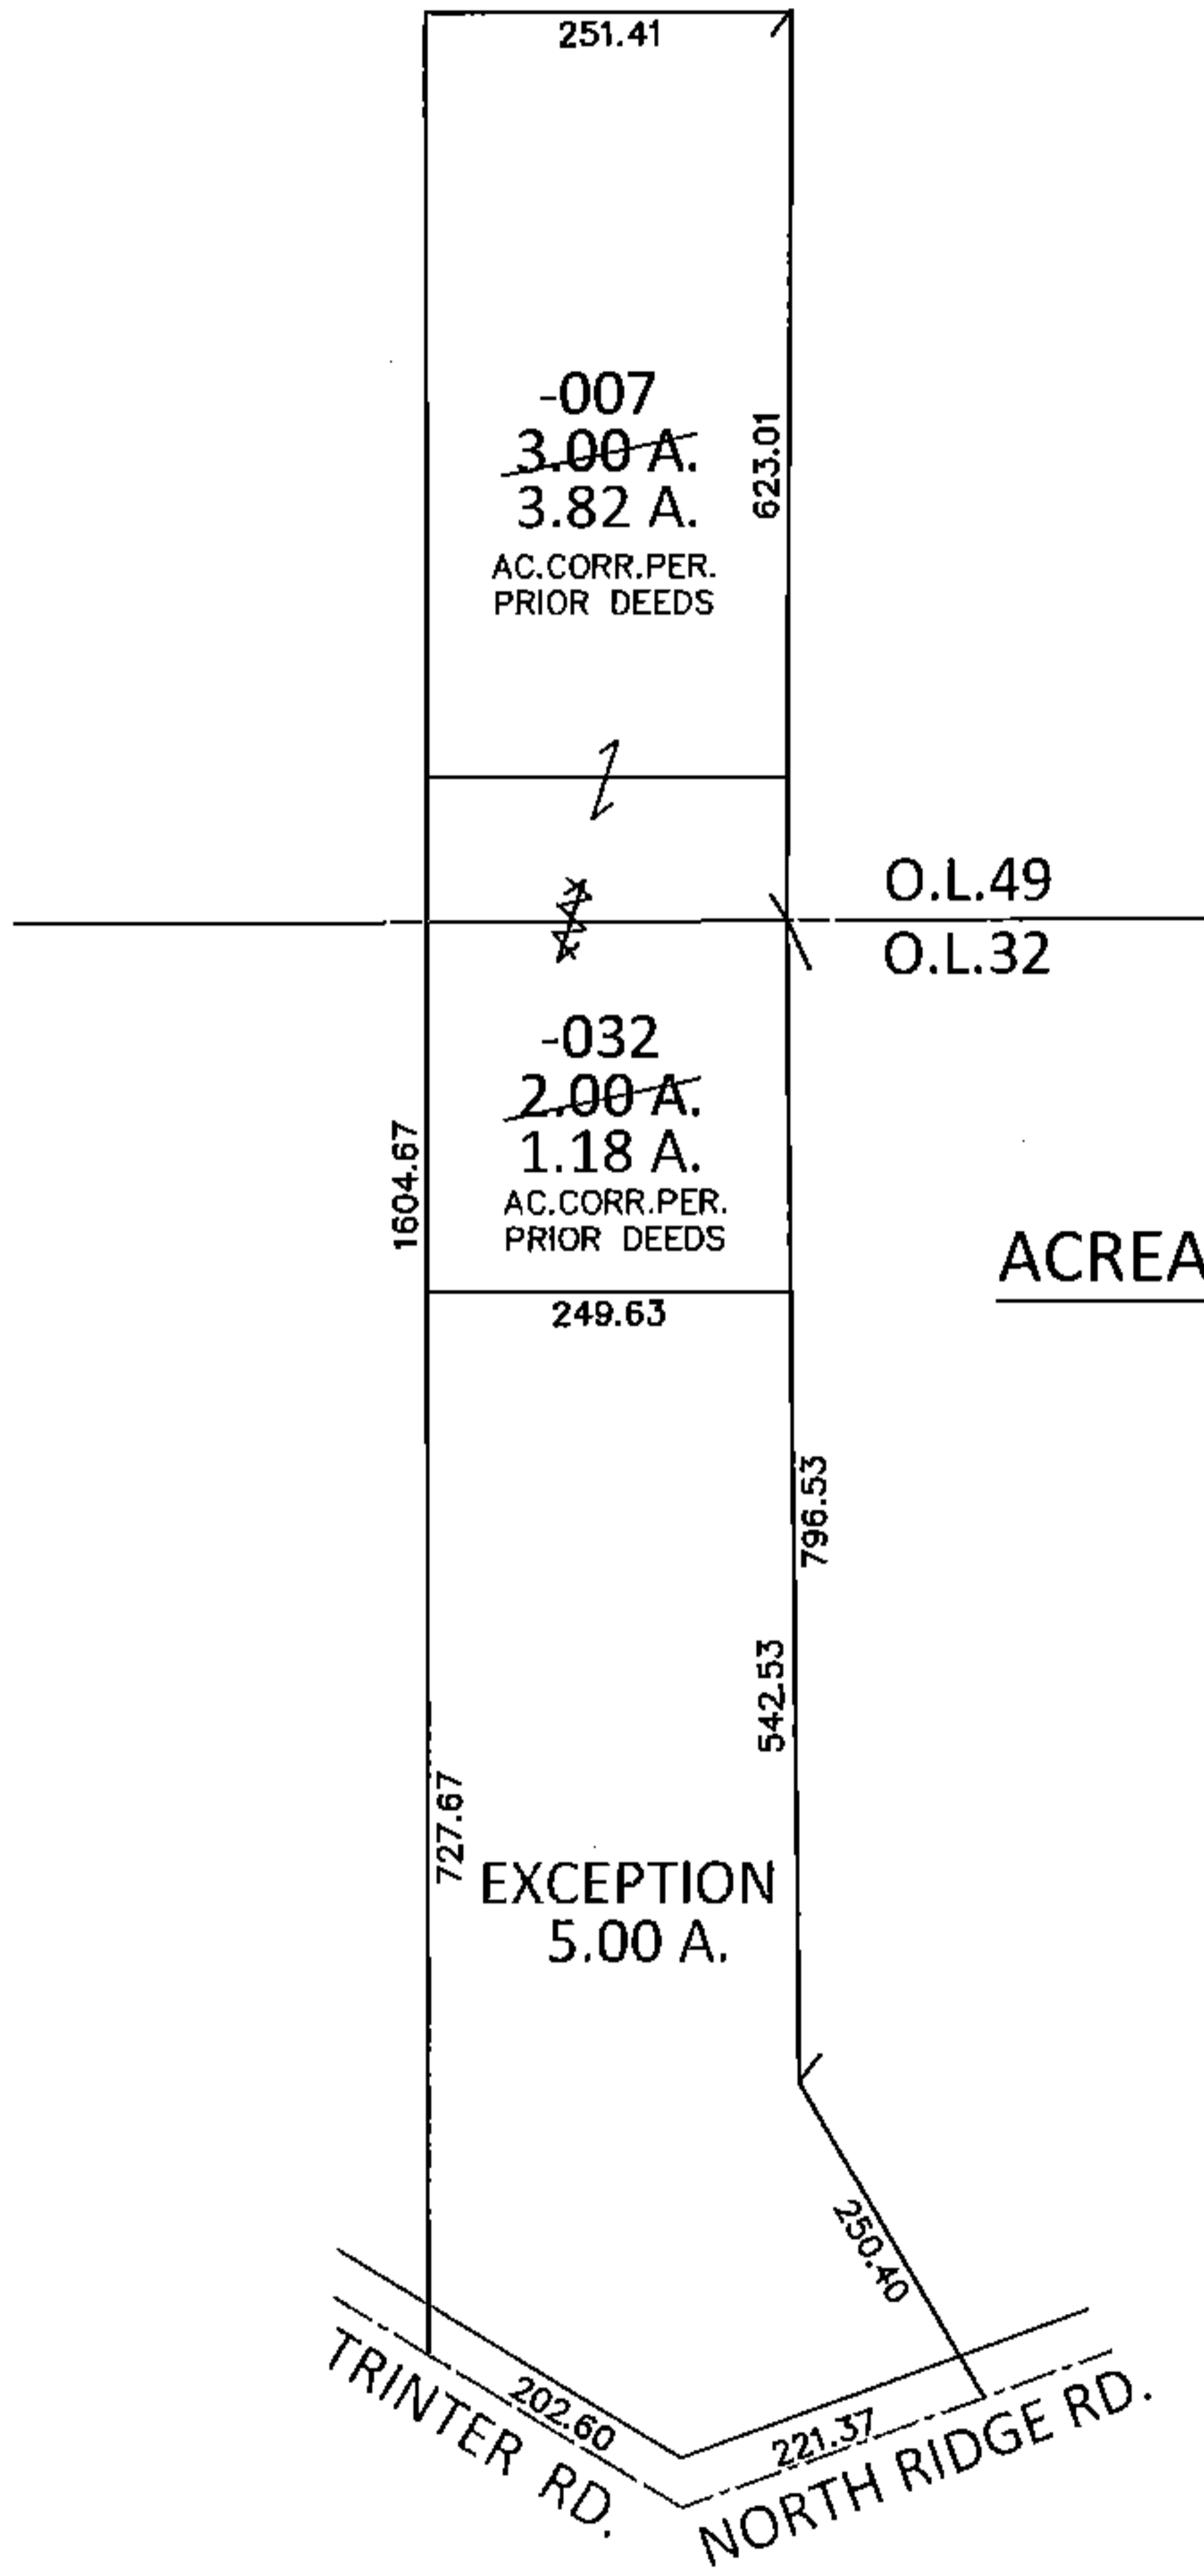


PARENT PARCEL: 01-00-049-000-007, 01-00-064-000-032
CHILD PARCEL: _____
STARTING POINT: INTERSECTION OF C/L OF TRINTER RD. AND C/L OF NORTH RIDGE RD.

15-03232-A

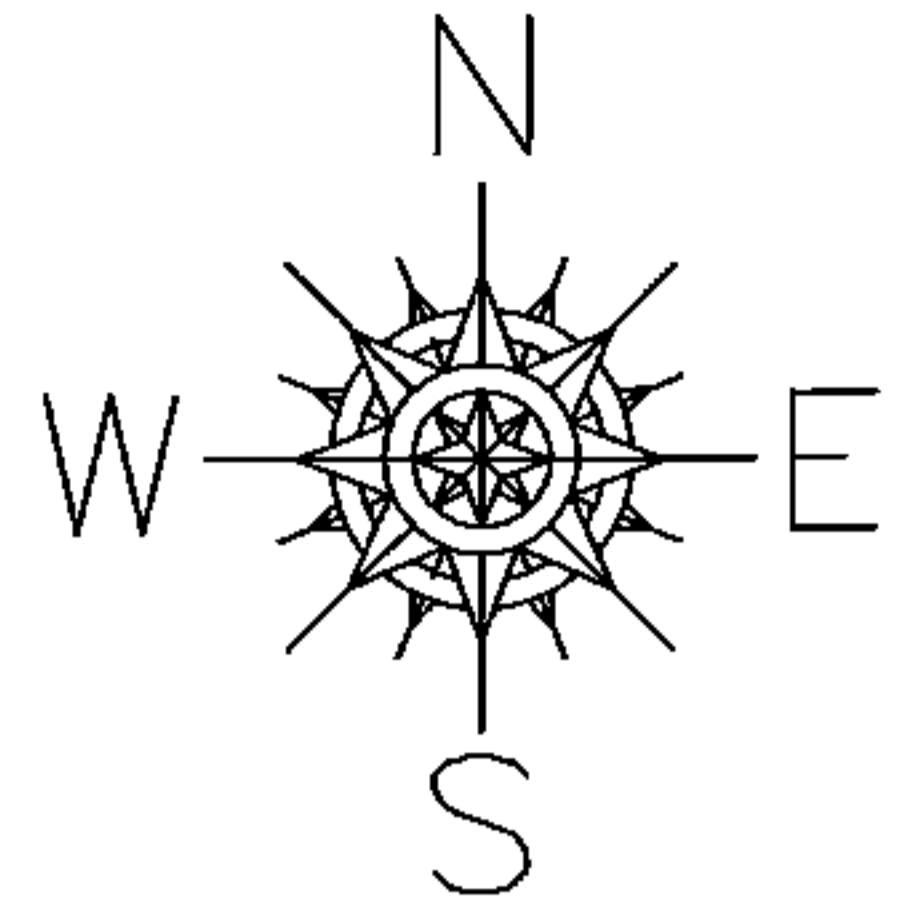

ACREAGE AND MAP CORRECTION

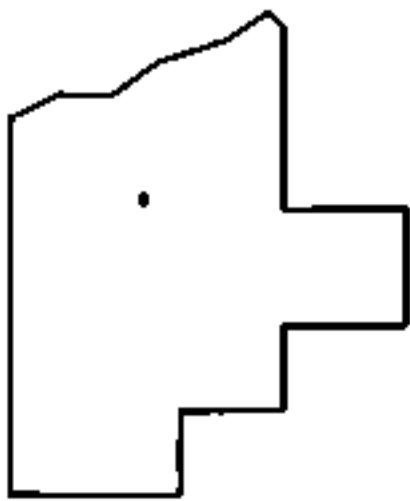

SPLITS/DEEDS PROCESSED
LORAIN COUNTY TAX MAP DEPARTMENT
226 MIDDLE AVE. ELYRIA, OHIO

SURVEYED BY: JAMES H. SCHMIDT
CLOSURE: .01:10,000
MAP PAGE(S): 1-I
APPROVED BY: RRM DATE: 6-11-15
SCALE: 1"=250' PRIOR INST.: 20150543441