
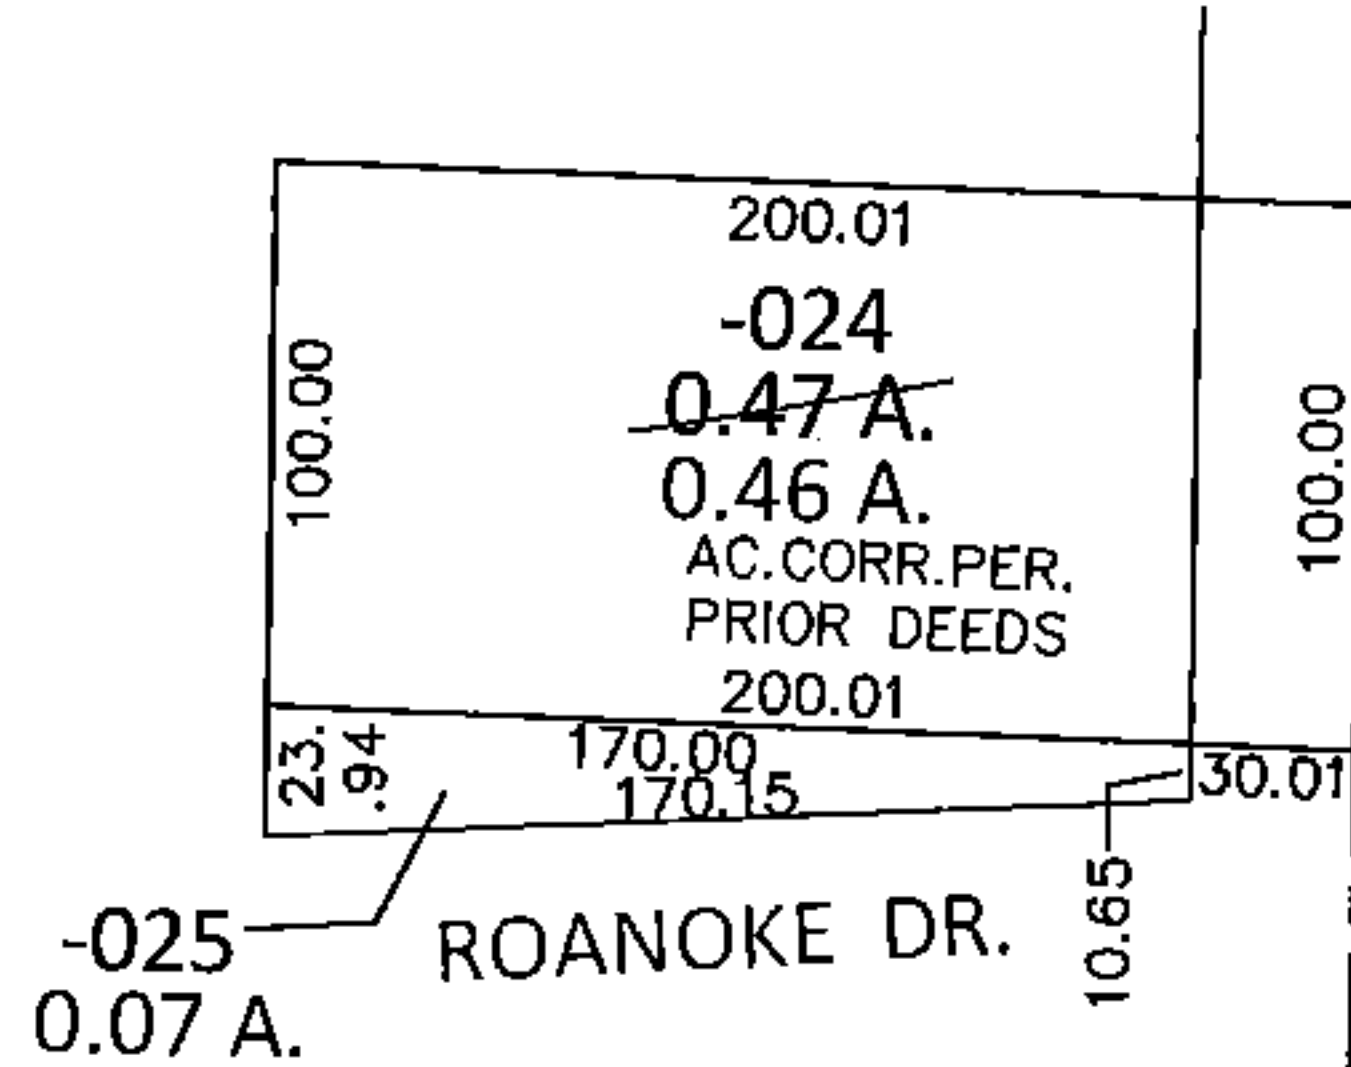


PARENT PARCEL: 01-00-004-120-024, -025

CHILD PARCEL: _____

STARTING POINT: INTERSECTION OF C/L OF SUNNYSIDE RD. AND SOUTH LINE OF O.L.4

15-03233-A

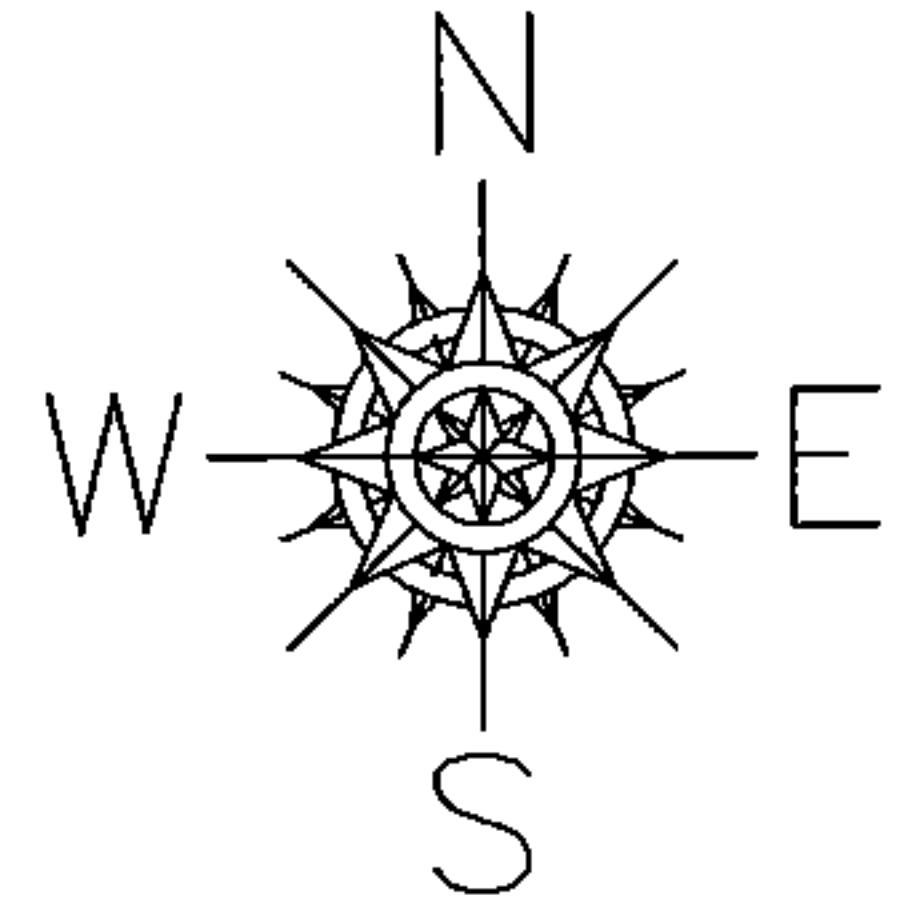


FRONTAGE & DEPTH TO ACREAGE CORRECTION

01-00-004-120-025
0.07 A.
~~170.14 X 23.94~~
PER PRIOR DEEDS

SUNNYSIDE RD.
895.14

O.L.4
O.L.13

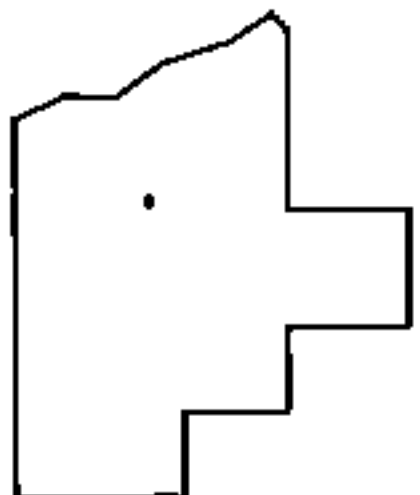

SPLITS/DEEDS PROCESSED

LORAIN COUNTY TAX MAP DEPARTMENT
226 MIDDLE AVE. ELYRIA, OHIO

SURVEYED BY: N/A

CLOSURE: .01:10,000

MAP PAGE(S): 1-00-004-D

APPROVED BY: RRM DATE: 6-11-15

SCALE: 1"= 100 PRIOR INST.: 20150543256