


PARENT PARCEL: 06-22-016-000-010 & -007



CHILD PARCEL: 06-22-016-000-012

STARTING POINT: CENTERLINE OF FREEDOM COURT AND THE SOUTHWESTERLY CORNER OF S/L 3

14-03233

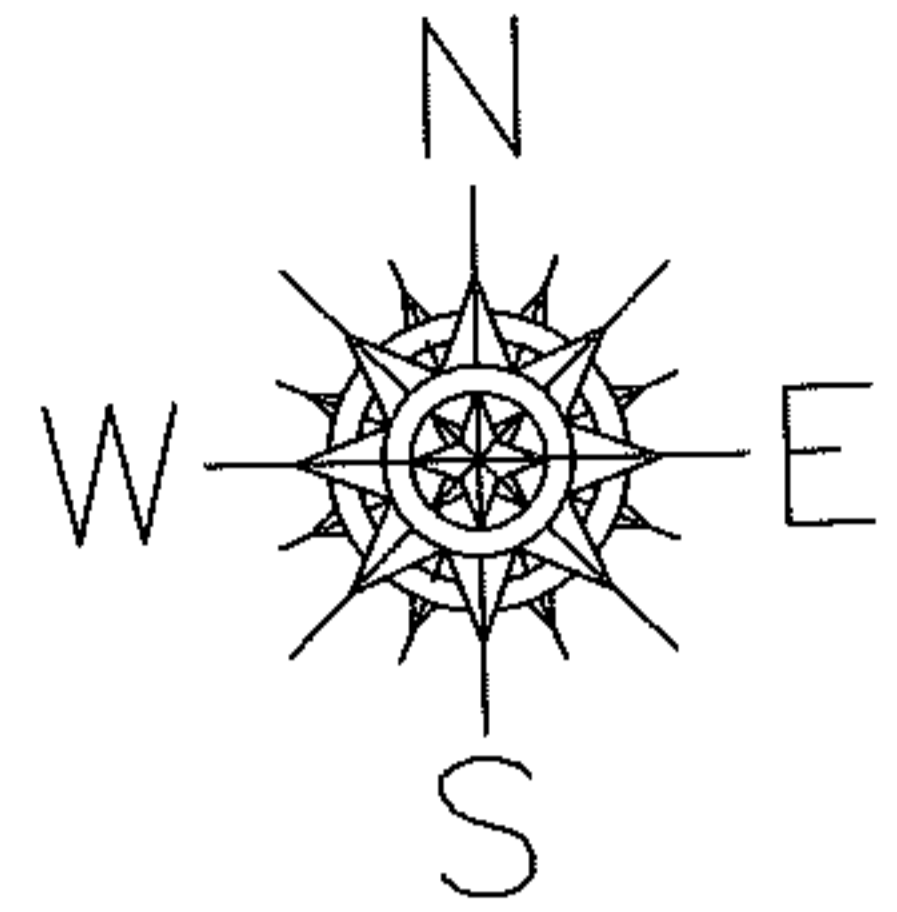

MIDWAY INDUSTRIAL PARK
VOL 36 PG 17

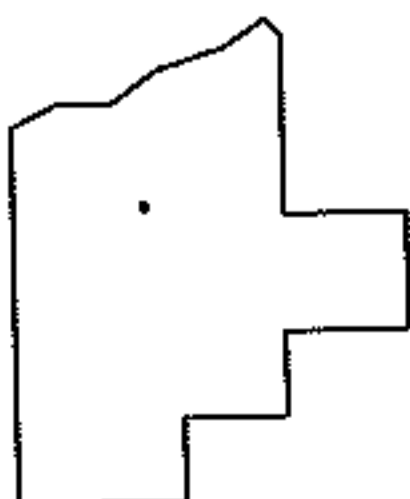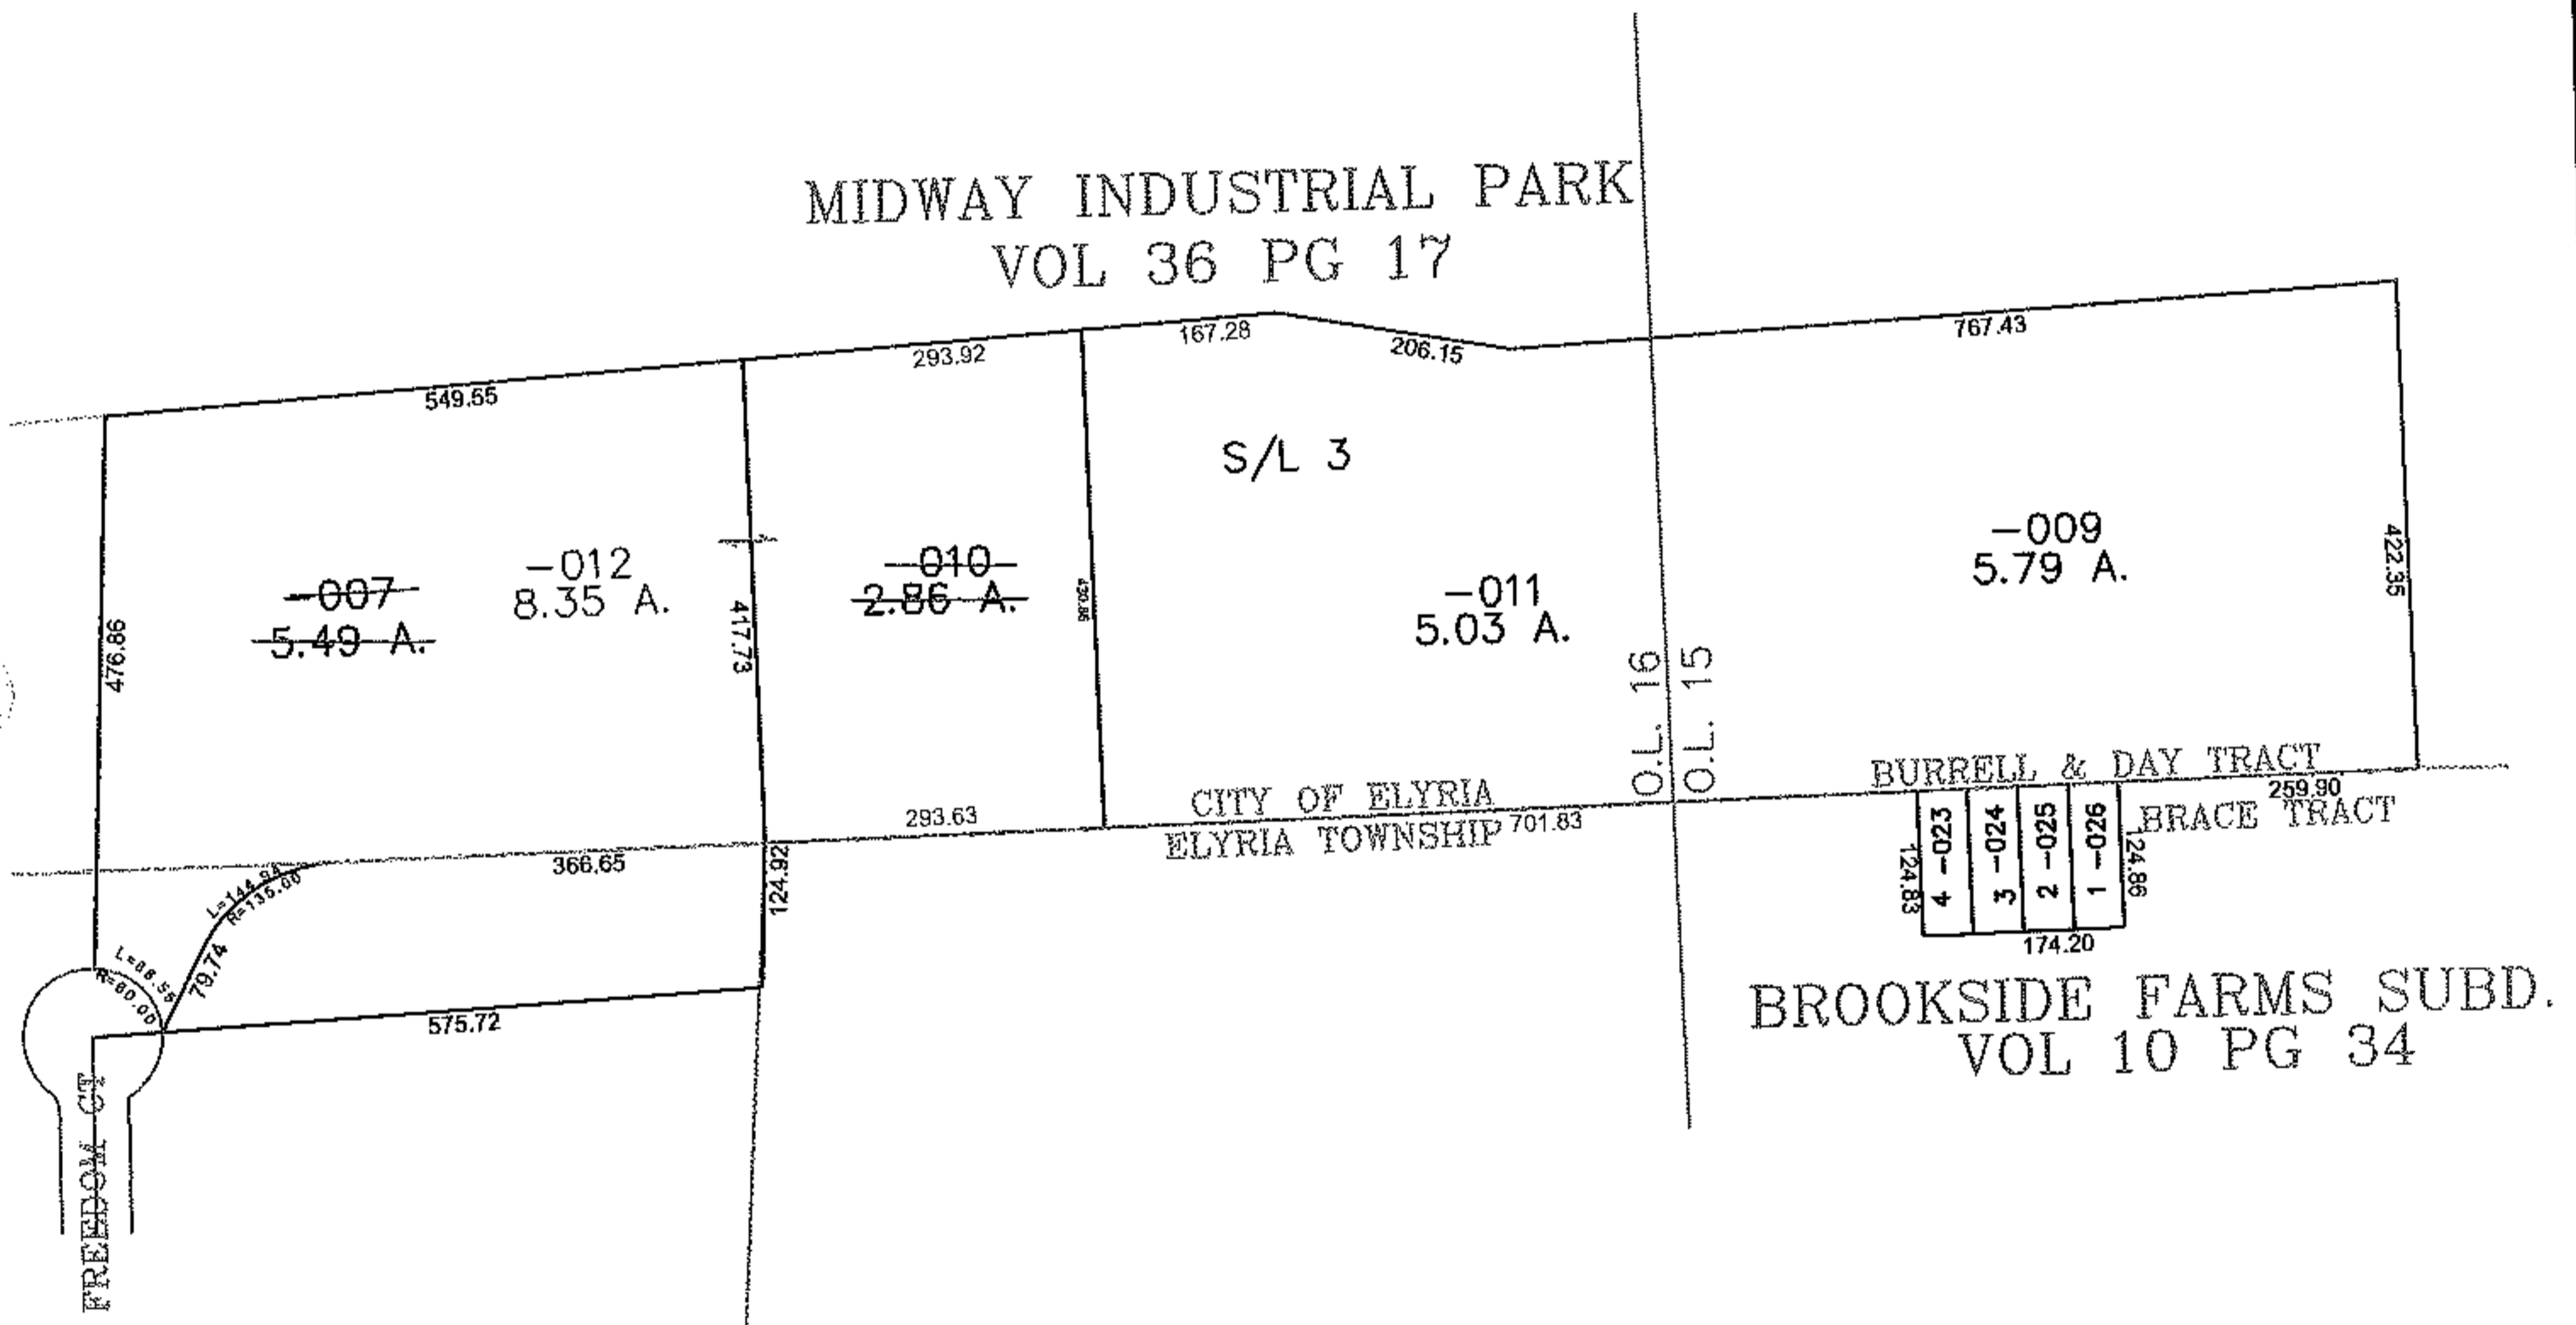

SPLITS/DEEDS PROCESSED
LORAIN COUNTY TAX MAP DEPARTMENT
226 MIDDLE AVE. ELYRIA, OHIO

SURVEYED BY: LELAND DILLWORTH
CLOSURE: 0.00 : 10,000
MAP PAGE(S): 6-8, 6-9
APPROVED BY: JAH DATE: 3-21-2014
SCALE: 1" = 300 PRIOR INSTRUMENT: 20040039666