
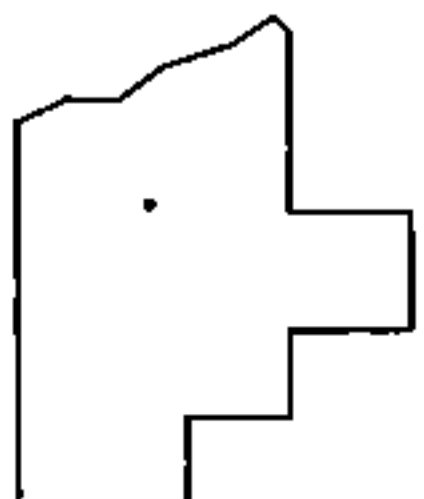
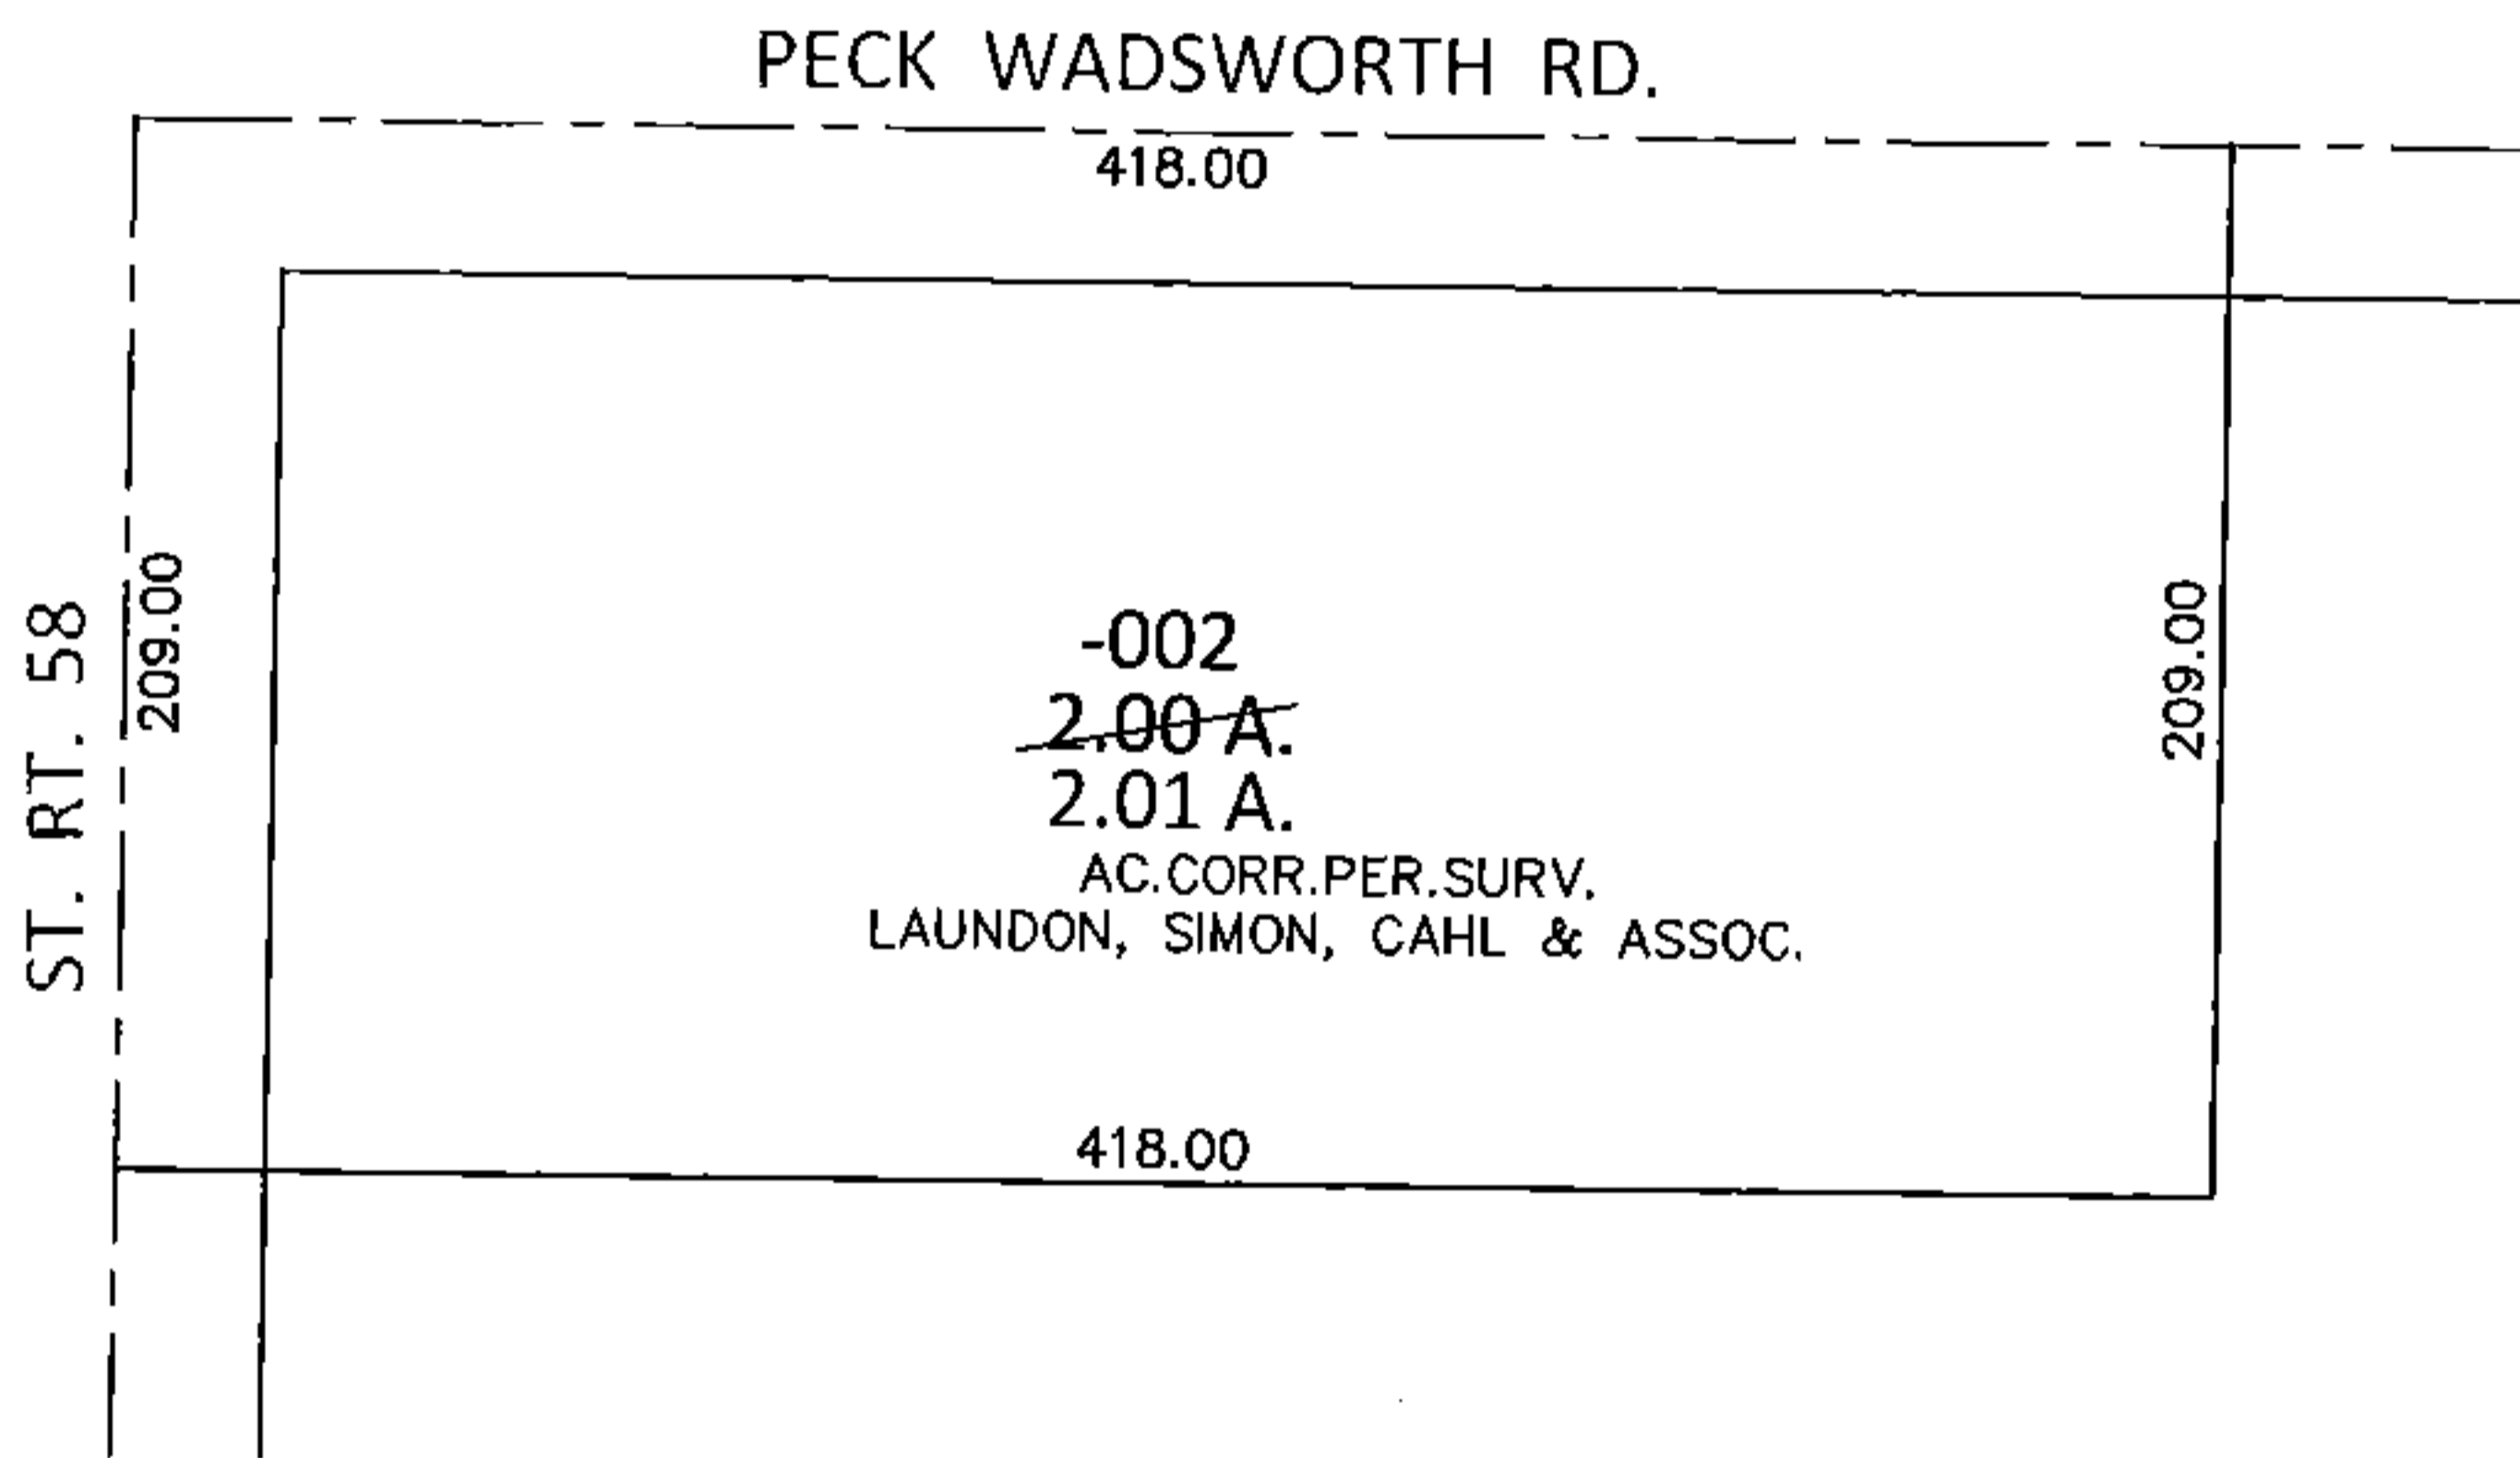


PARENT PARCEL: 18-00-020-000-002

CHILD PARCEL: _____

STARTING POINT: INTERSECTION OF C/L OF PECK WADSWORTH RD. AND C/L OF S.R.58

15-03239-A

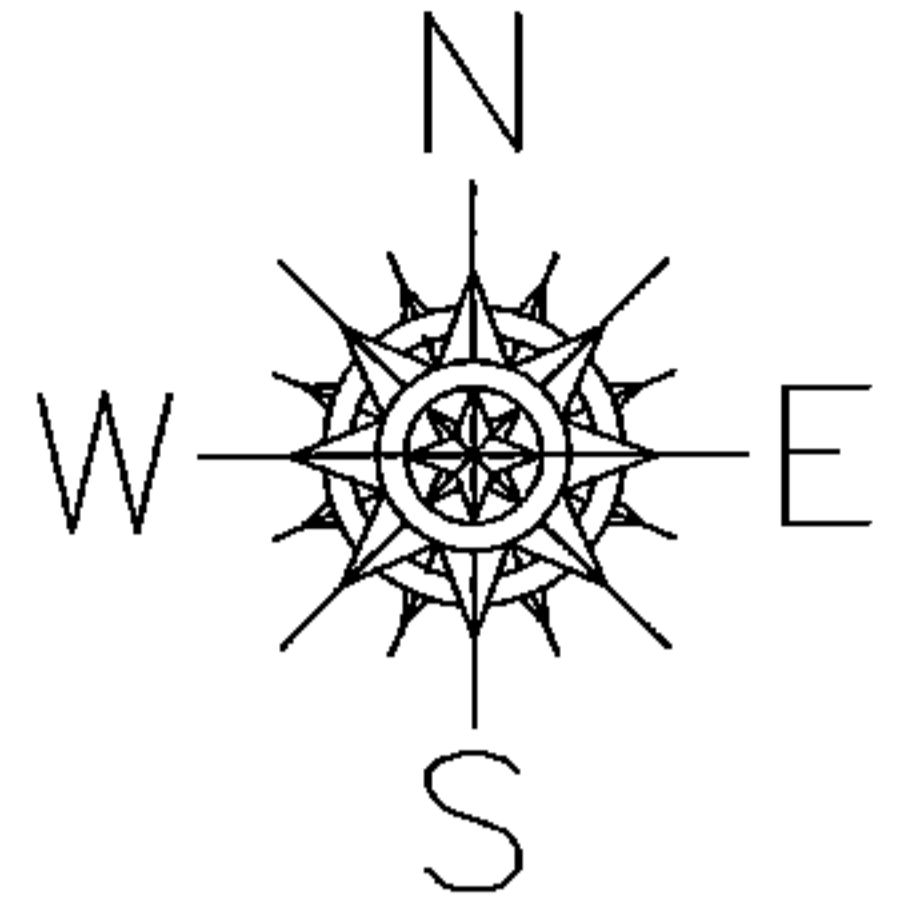

SPLITS/DEEDS PROCESSED

LORAIN COUNTY TAX MAP DEPARTMENT
226 MIDDLE AVE. ELYRIA, OHIO

SURVEYED BY: LAUNDON, SIMON, CAHL & ASSOC.

CLOSURE: .00:10,000

MAP PAGE(S): 18-00-020-A

APPROVED BY: RRM DATE: 6-24-15

SCALE: 1"= 100 PRIOR INST.: 20150549152