
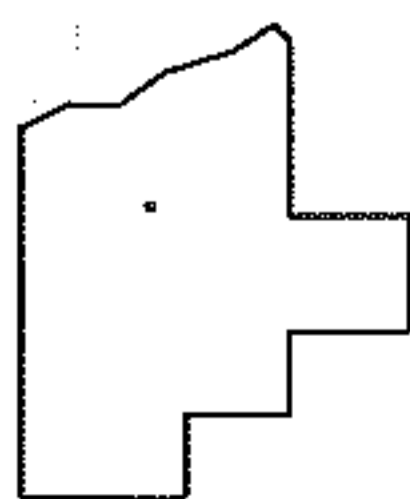
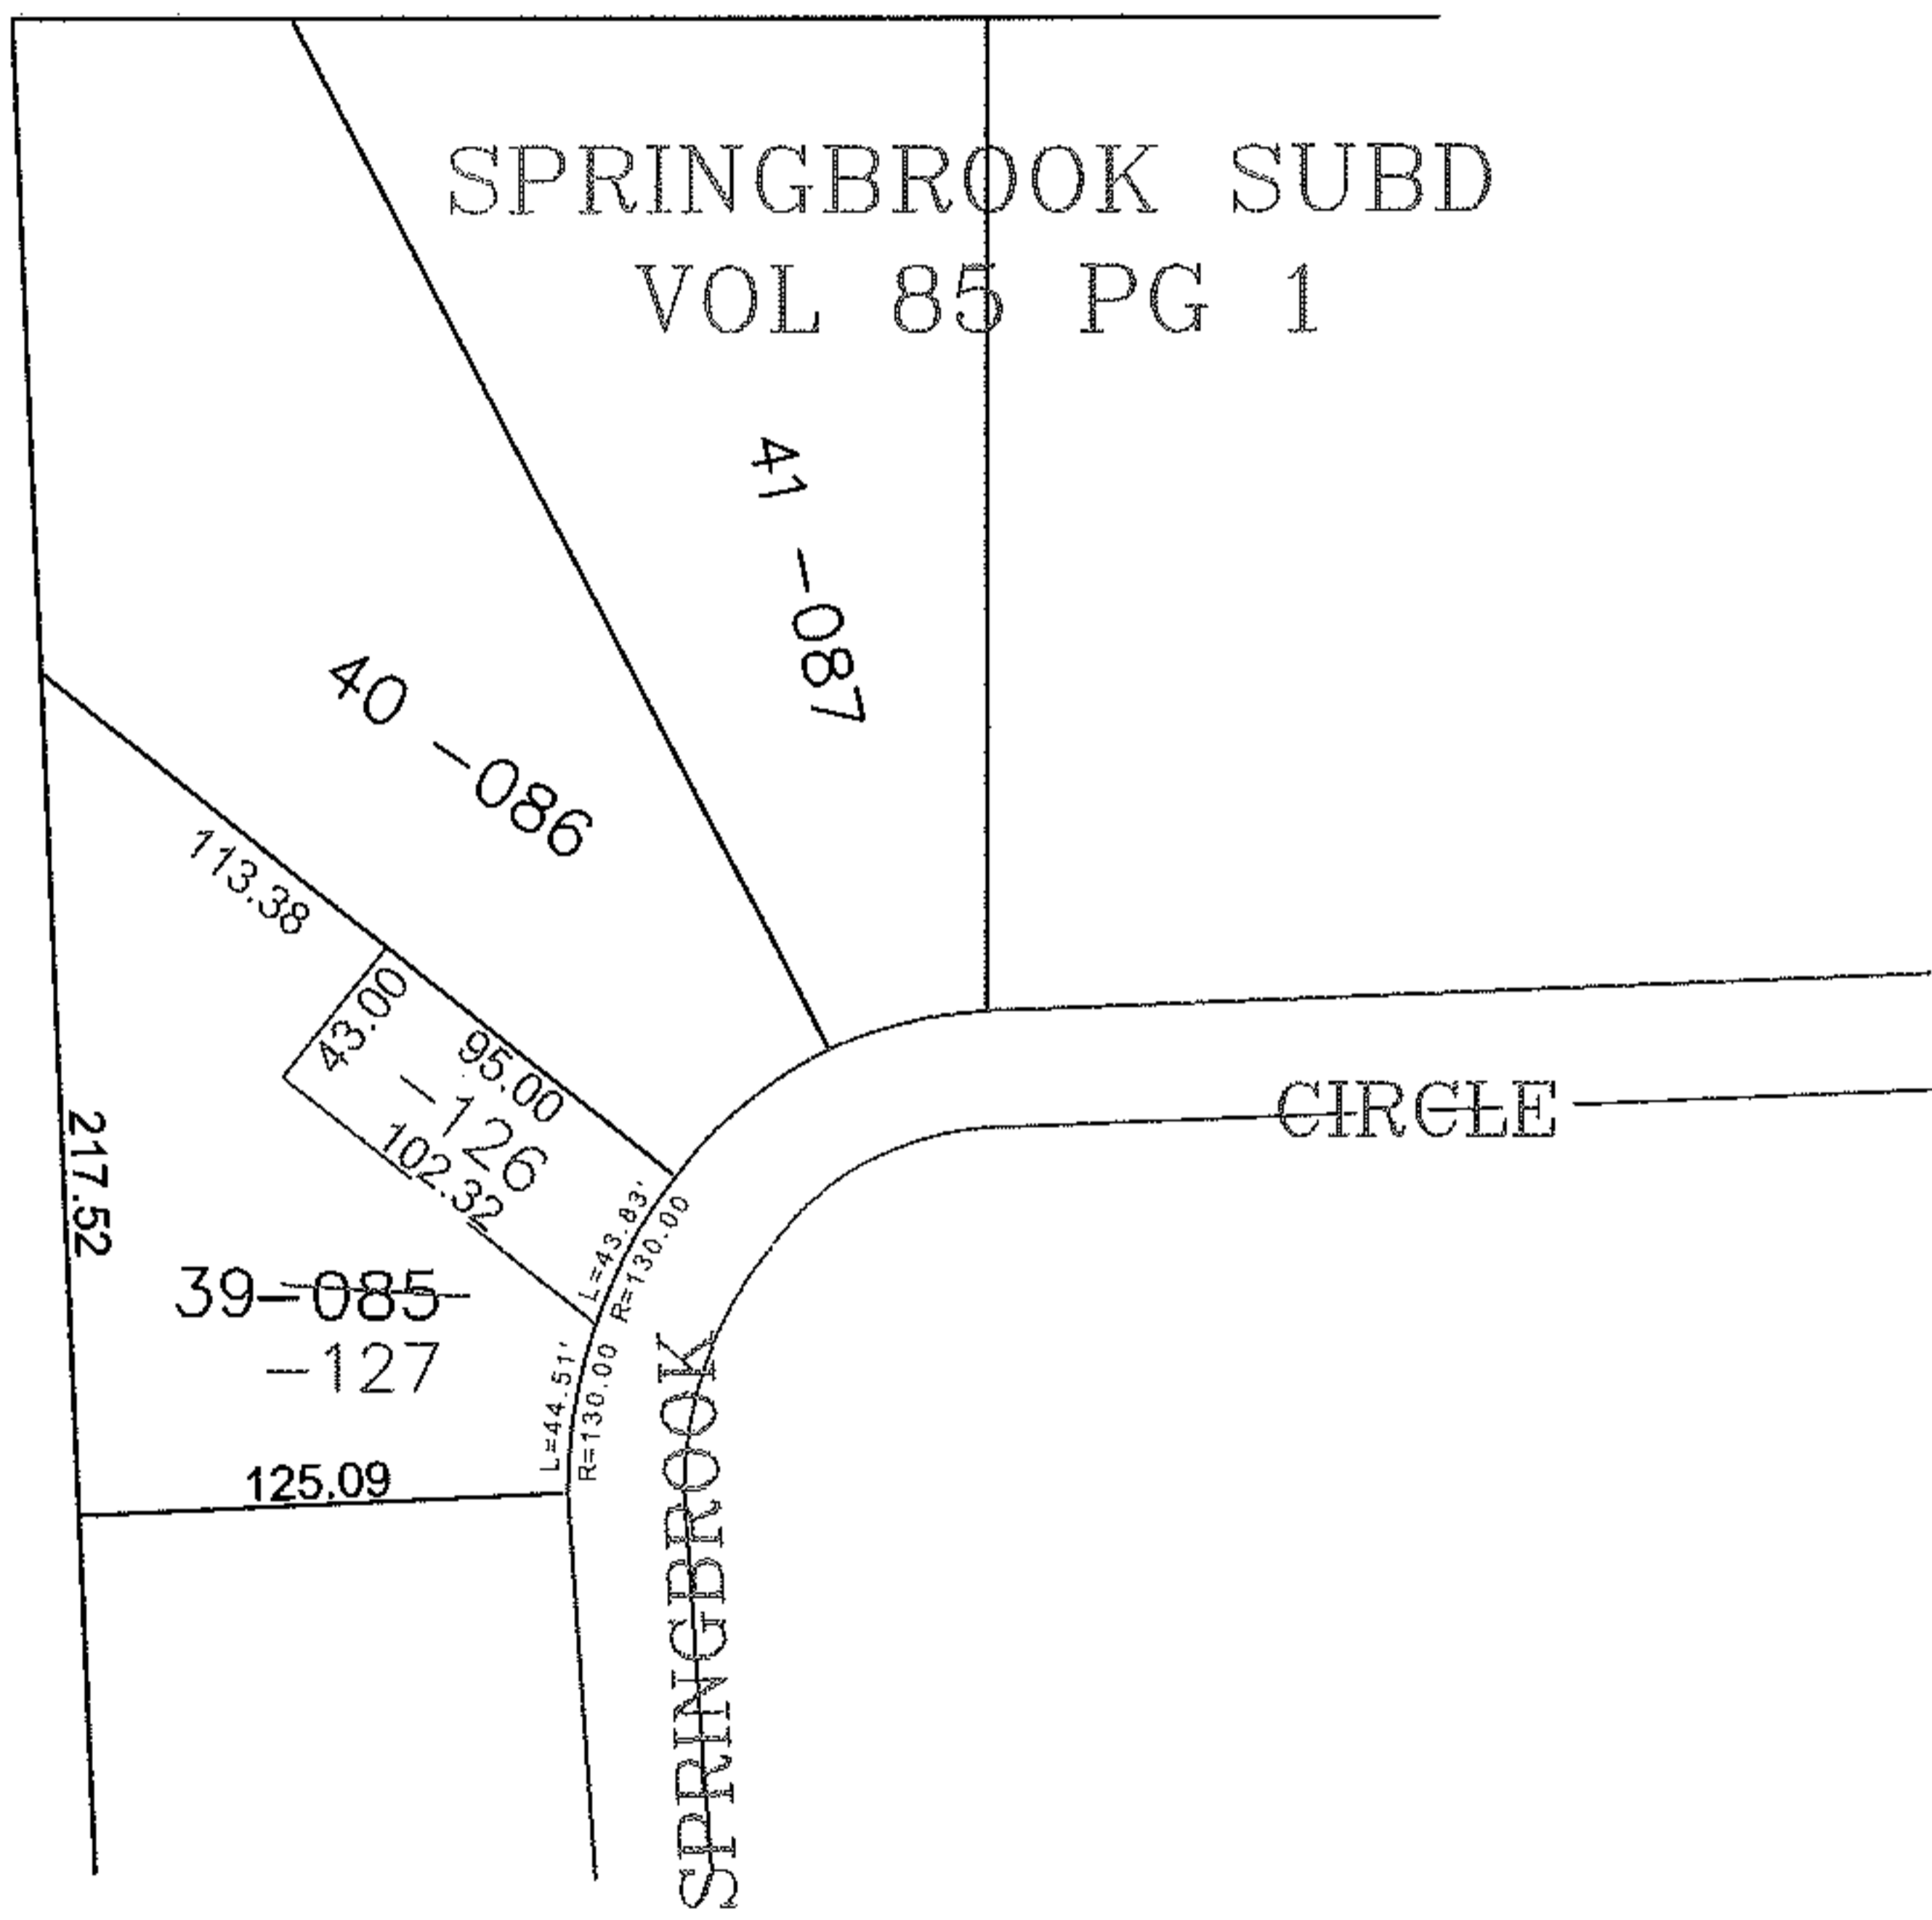


PARENT PARCEL: 06-24-015-000-085

CHILD PARCEL: 06-24-015-000-126, -127

STARTING POINT: NORTH EASTERLY CORNER OF S/L 39 OF SPRINGBROOK SUBD.

14-03239

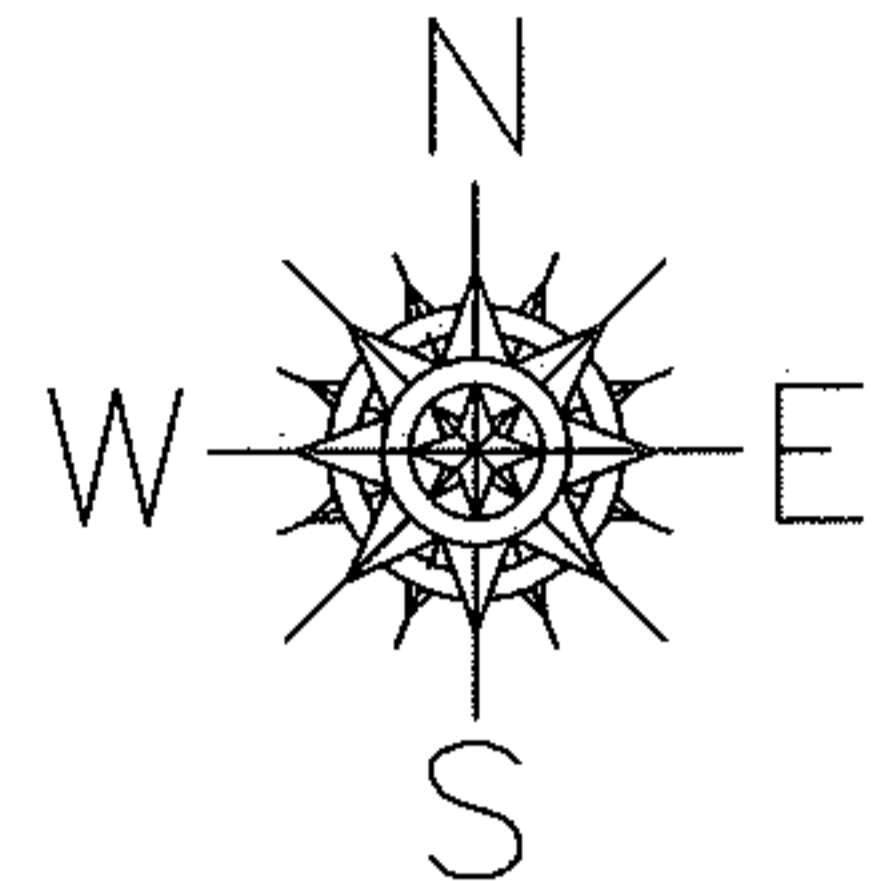

SPLITS/DEEDS PROCESSED

LORAIN COUNTY TAX MAP DEPARTMENT
226 MIDDLE AVE. ELYRIA, OHIO

SURVEYED BY: RICHARD FREDRICKSON
 CLOSURE: 0.00 : 10,000
 MAP PAGE(S): 6-93
 APPROVED BY: JAH DATE: 3/27/2014
 SCALE: 1" = 100' PRIOR INSTRUMENT: 2006034030