
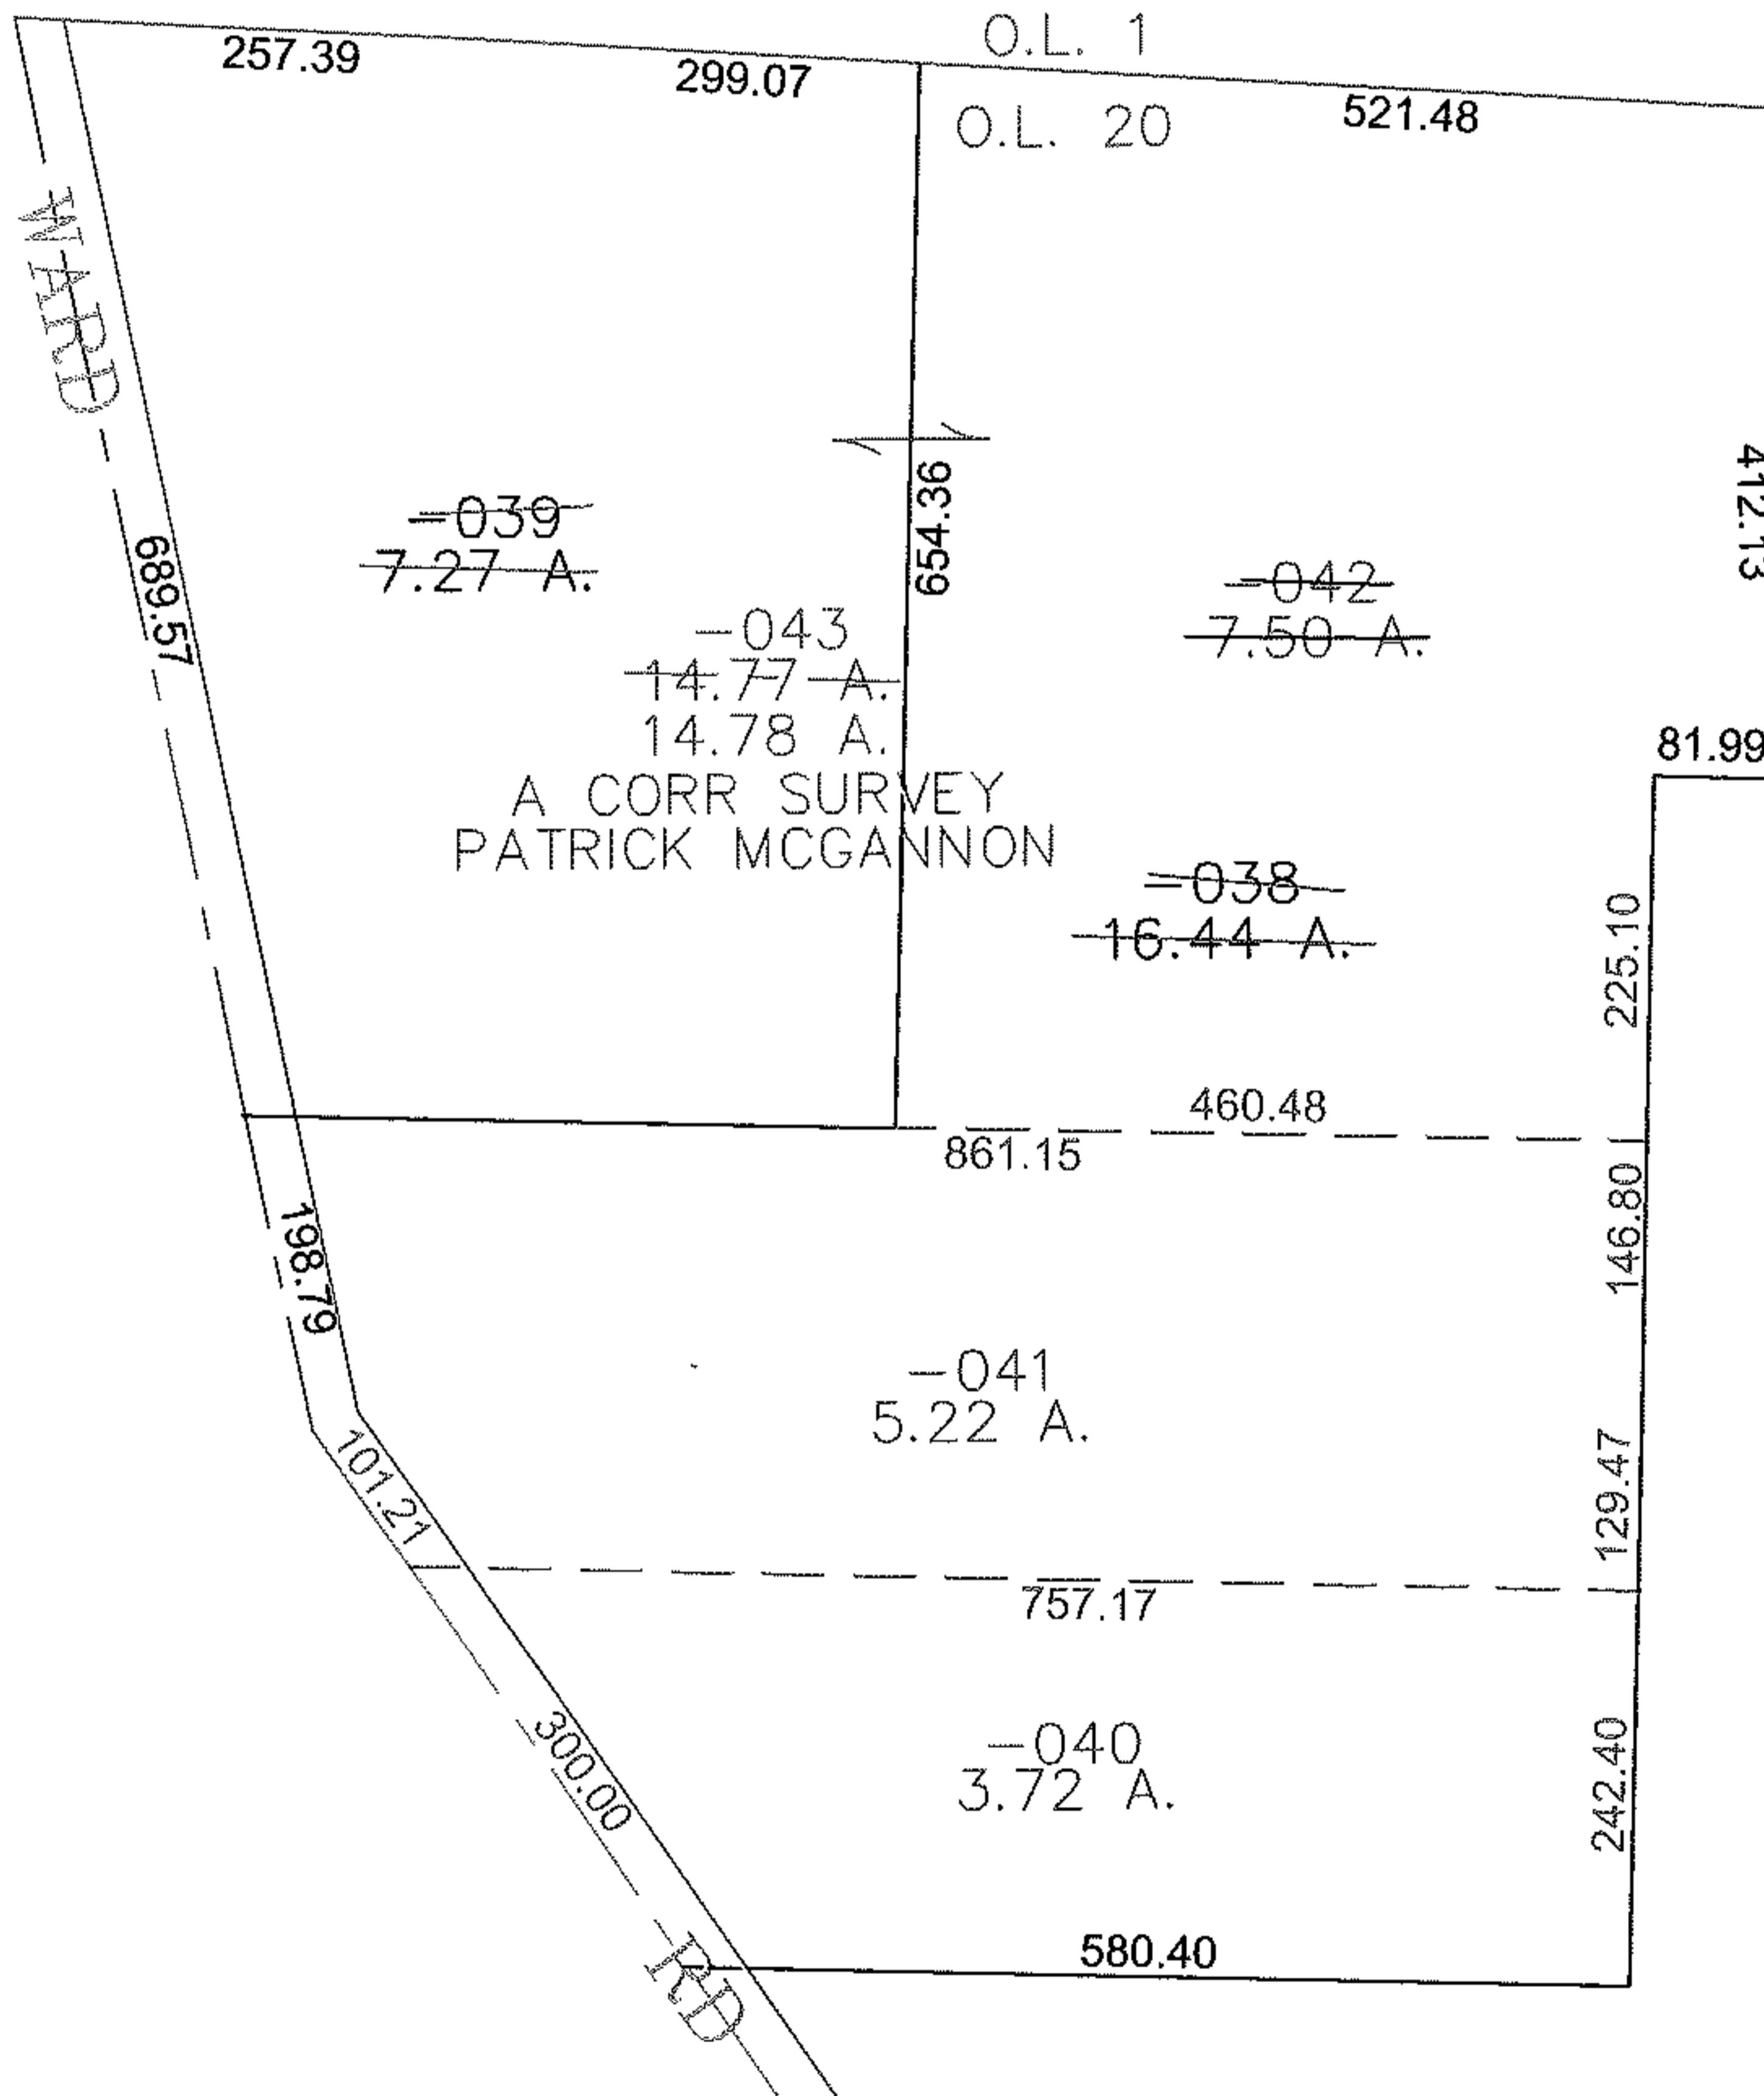


PARENT PARCEL: 08-13-020-000-038, -039


CHILD PARCEL: 08-13-020-000-040 THRU -043

STARTING POINT: CENTERLINE OF WARD RD & O.L. 20

14-03240

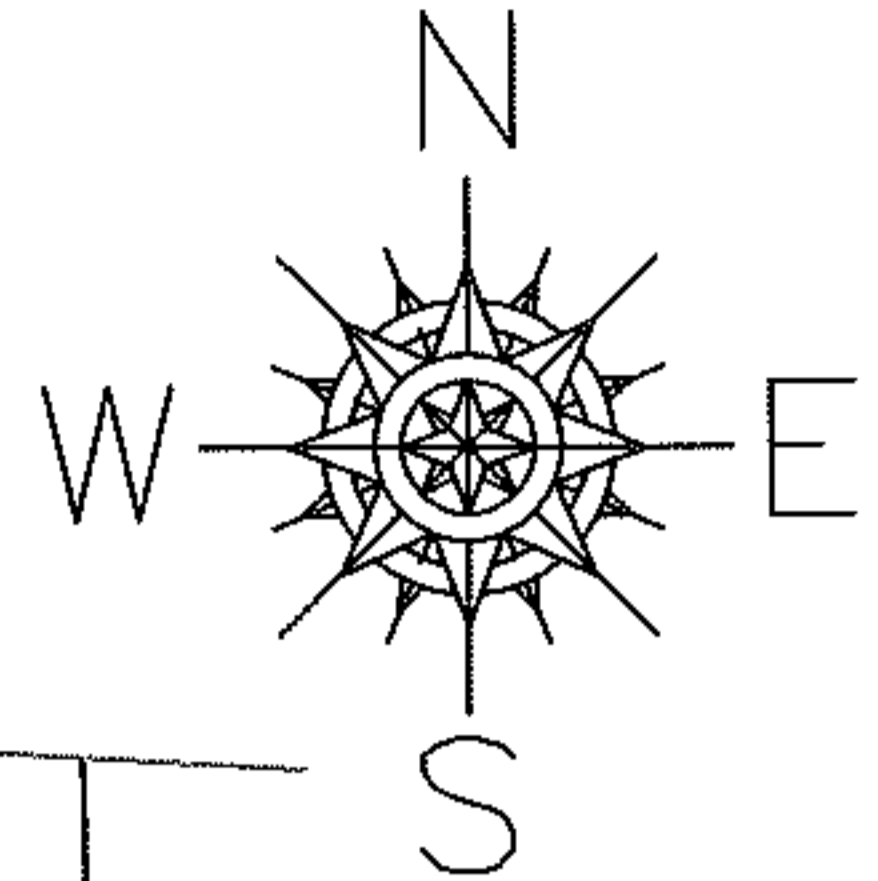

A CORR SURVEY
PATRICK MCGANNON

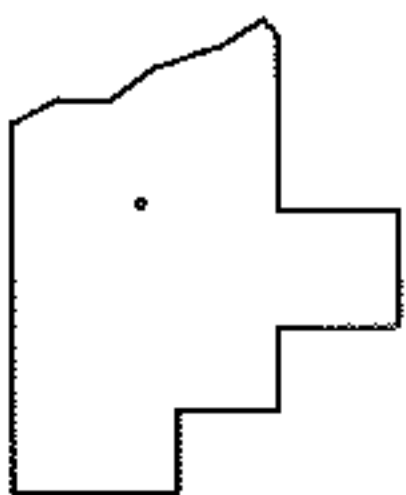

SPLITS/DEEDS PROCESSED
LORAIN COUNTY TAX MAP DEPARTMENT
226 MIDDLE AVE. ELYRIA, OHIO

SURVEYED BY: PATRICK MCGANNON
CLOSURE: 0.00 : 10.000
MAP PAGE(S): 8-E
APPROVED BY: JAH DATE: 4/1/2014
SCALE: 1" = 200 PRIOR INSTRUMENT: 20130453063