
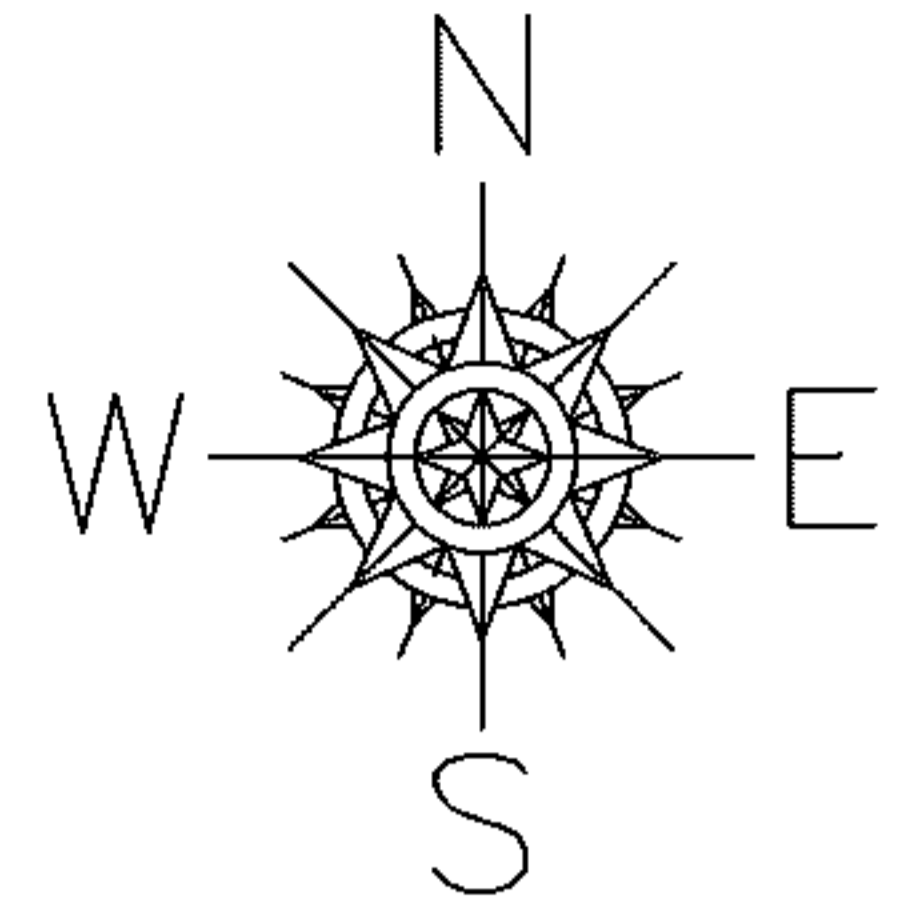


PARENT PARCEL: 04-00-027-102-052, -047
 CHILD PARCEL: 04-00-027-102-074 THRU -078
 STARTING POINT: CENTERLINE OF NAGEL RD & O.L. 27

14-03241

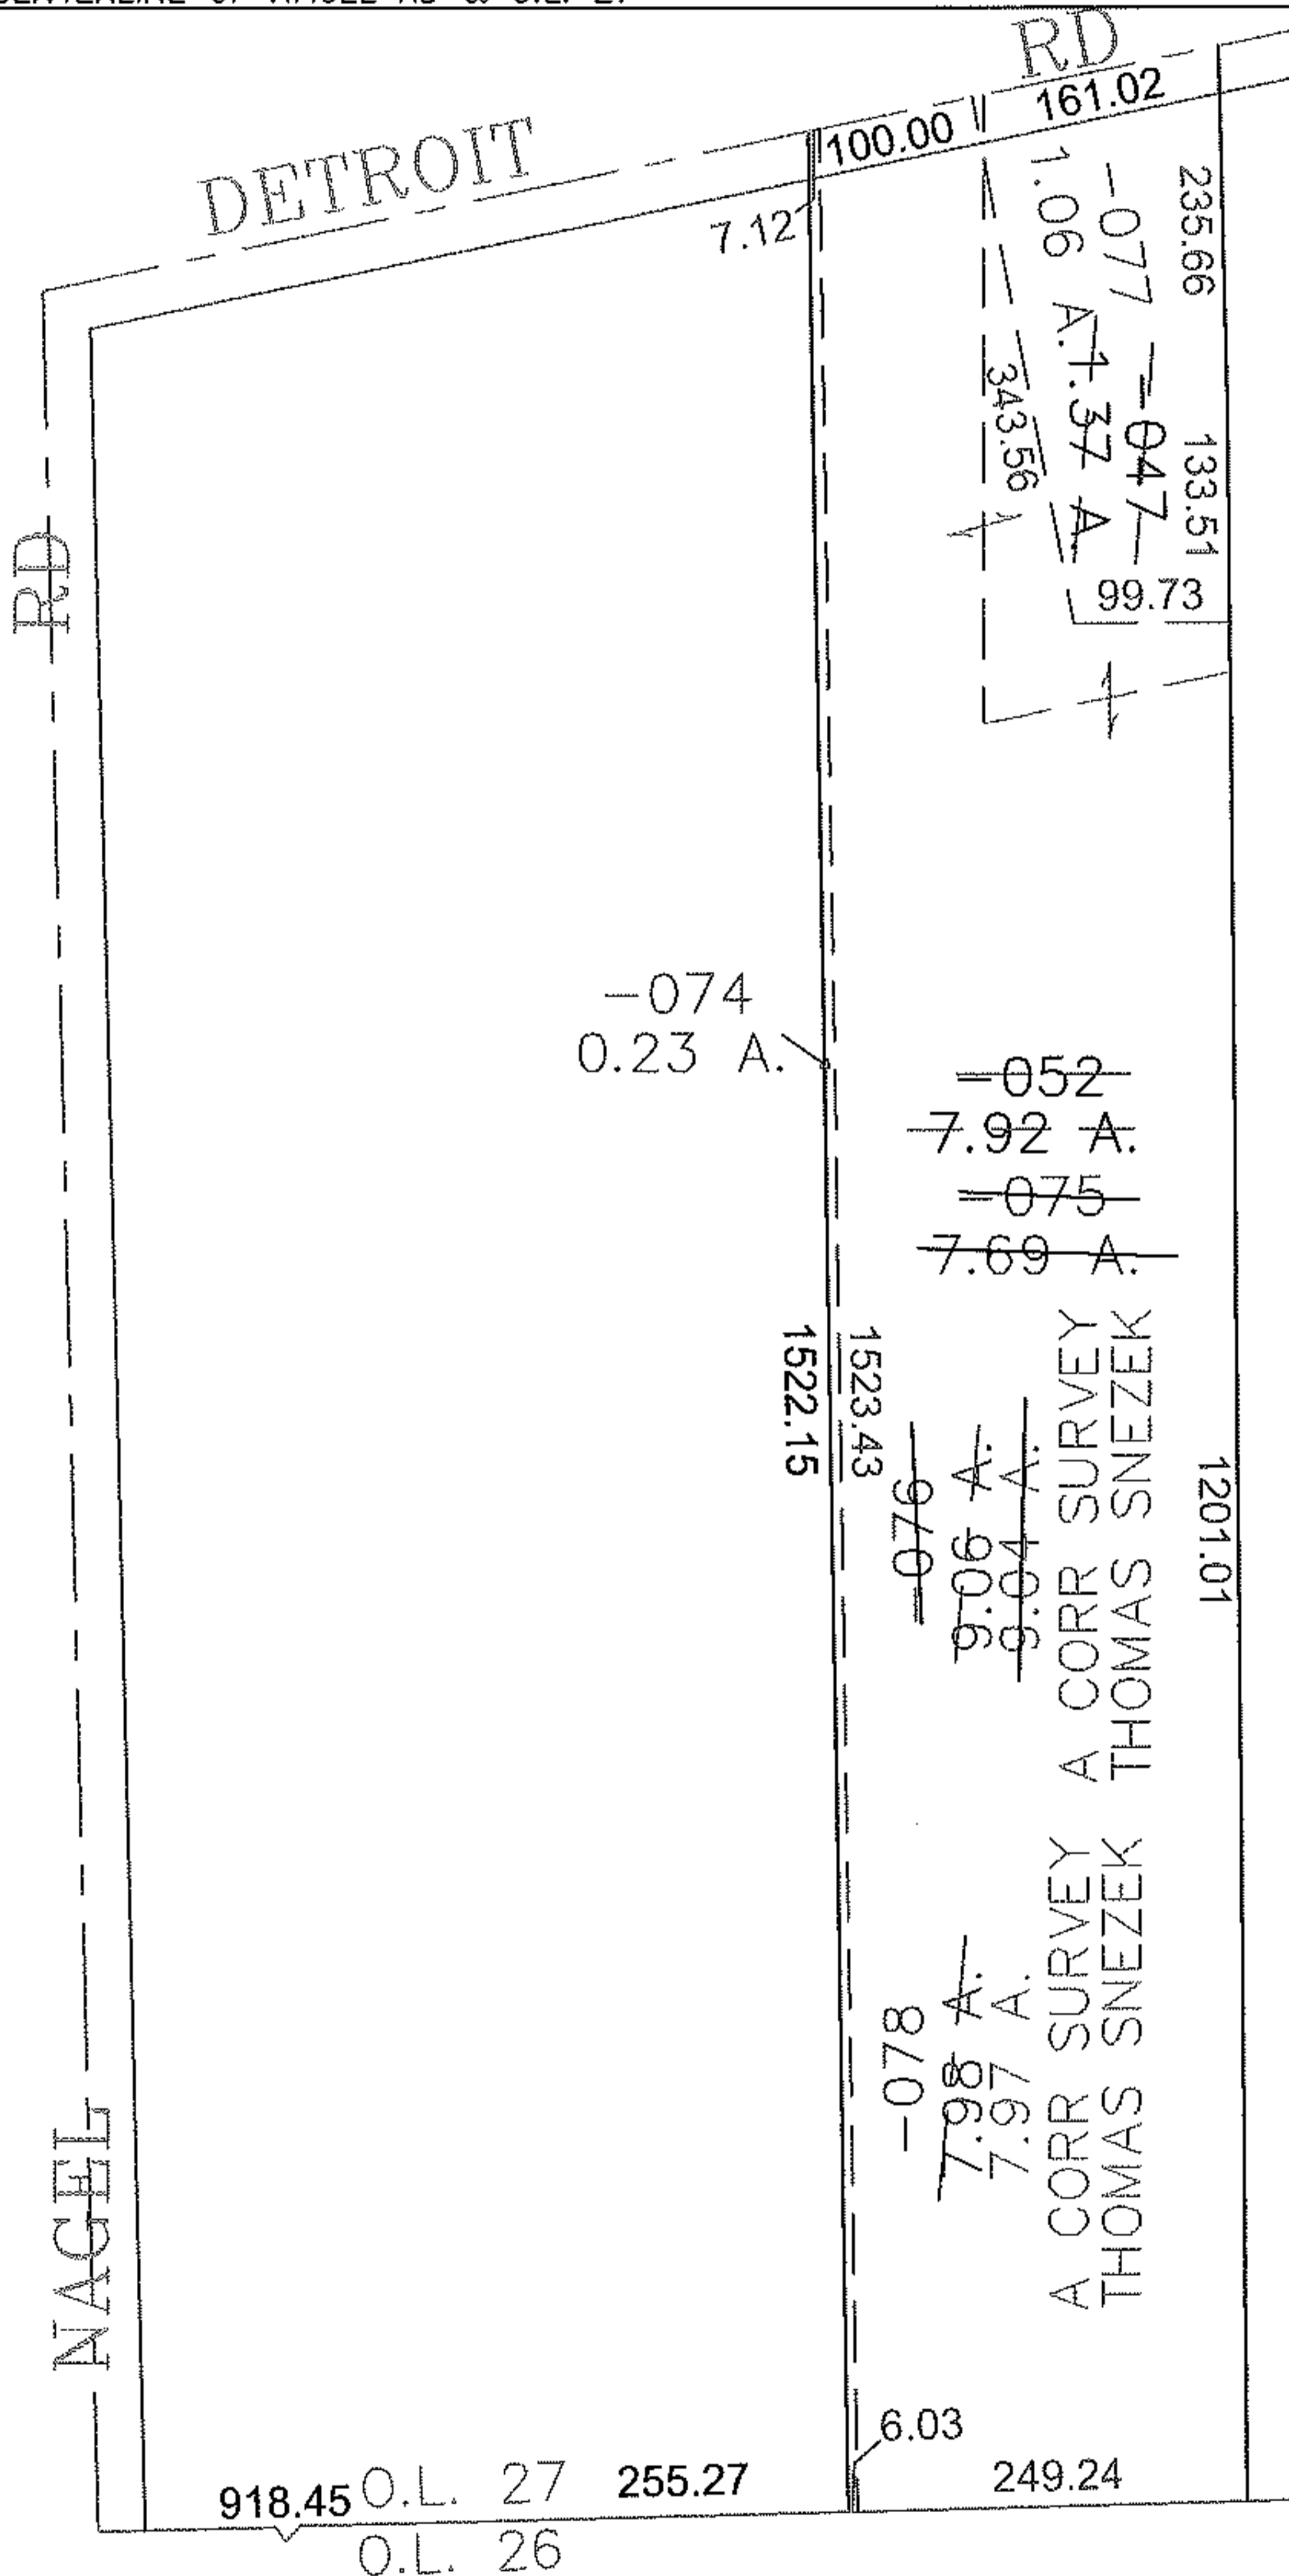

SPLITS/DEEDS PROCESSED
 LORAIN COUNTY TAX MAP DEPARTMENT
 226 MIDDLE AVE. ELYRIA, OHIO

SURVEYED BY: THOMAS SNEZEK
 CLOSURE: 0.00 : 10.000
 MAP PAGE(S): 04-00-027-E
 APPROVED BY: JAH DATE: 4/7/2014
 SCALE: 1" = 200 PRIOR INSTRUMENT: DV 1248/709